


LATITUDE 39 36

LONGITUDE 80 15

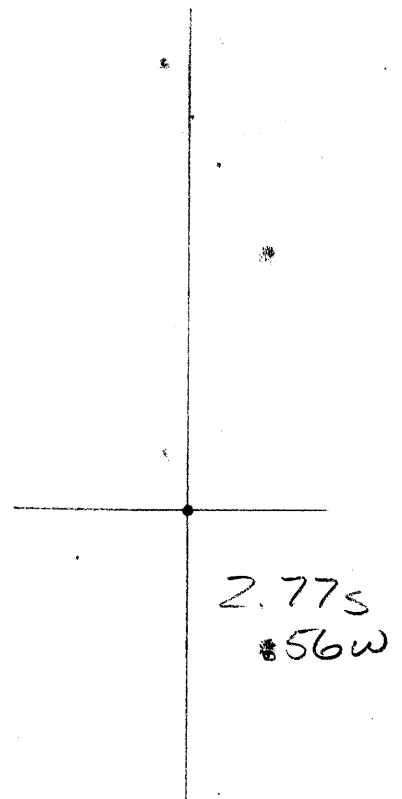

7'5 OGIS topo location

7.5' loc	<u>2.77S</u>	15' loc	_____
	<u>.56W</u>	(calc.)	_____

Company _____

Farm JACK CONNOR 1

Quad MANNINGTON

County MARION

District LINCOLN

WELL LOCATION MAP

File No. 70048

JACK CONNOR NO. 1 WELL.

70048
No 241...on Map.

612 MMT Co Rep
612 MMT Co Rep

Lincoln District, Marion County, W. Va.
Elevation, 1045' B.

Fayette County Gas Co.

Conductor, 21'; 10" casing, 376'; 8 1/4", 1307'; 6-5/8", 1630'.

Packer set at 2717'.

Pressure: 1st min., 275 lbs.; 1 1/2 min., 370 lbs.; 2 min., 440 lbs.;
3 min., 550 lbs.; 4 min., 635 lbs.; 5 min., 740 lbs.; 6 min.,
825 lbs.; 7 min., 875 lbs.; 8 min., 900 lbs.; 9 min., 925 lbs.;
10 min., 935 lbs.; 15 min., 950 lbs.

2

	Top.	Bottom.
Sewickley Coal		245
Pittsburgh Coal		368
Sand, Upper Freeport		970 - 1000
Big Dunkard Sand (East Lynn)		1095 - 1120
Gas Sand (Homewood, 2nd Cow Run)		1160 - 1205
Salt Sand (Lower Connoquenessing)		1295 - 1400
Big Lime		1630 - 1710
Big Injun Sand		1710 - 1830
Gantz Sand		2240 - 2260
50-Ft. Sand		2280 - 2295
4th Sand		2575 - 2585
Bayard Sand		2732 - 2752
Total depth		2757

.....District, Marion County, W. Va.

By Fayette County Gas Co.

On Lincoln Fork of Dunkard Mill Run.

Conductor, 21'; 10" casing, 376'; 8 $\frac{1}{4}$ ", 1307'; 6-5/8", 1630'.

8 $\frac{1}{4}$ " and 10" casing pulled.

Packer set at 2717'.

Commenced May 14, 1903; finished, July 15, 1903.

Elevation, 1045' B.

Pressure: 1st min., 275 lbs.; 1 $\frac{1}{2}$ min., 370 lbs.; 2 min., 440 lbs.;
 3 min., 550 lbs.; 4 min., 635 lbs.; 5 min., 740 lbs.; 6 min.,
 825 lbs.; 7 min., 875 lbs.; 8 min., 900 lbs.; 9 min., 925 lbs.;
 10 min., 935 lbs.; 15 min., 950 lbs.

	Top.	Bottom.
Freeport Coal (Sewickley)	245	
Pittsburgh Coal	368	
First Dunkard Sand (Upper Freeport)	970	1000
Big Dunkard Sand (East Lynn)	1095	1120
Gas Sand (Second Cow Run)	1160	1205
Salt Sand (Lower Connoquenessing)	1295	1400
Big Lime	1630	1710
Big Injun Sand	1710	1830
Fifty-foot Sand	2240	2260
Sand	2280	2295
Gordon Sand	2575	2585
Fifth Sand	2732	2752
Total depth		2757