


LATITUDE 39 37 30

LONGITUDE 80 22 30

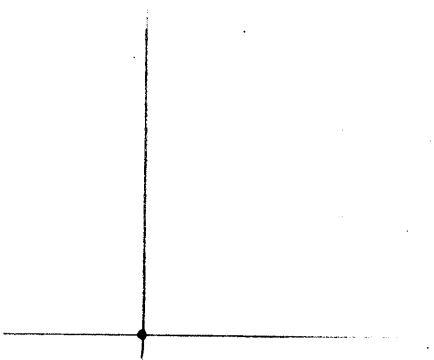

2.15S
 1.53W

7.5 OGIS topo location

7.5' loc 2.15S 15' loc _____
 1.53W (calc.) _____

Company _____

Farm BENS. DODD 2

Quad GLOVER GAP

County MARLBORO

District MANNINGTON

WELL LOCATION MAP

File No. 70856

390 MMT Co Rep

70056

Mannington District, Marion County, W. Va.

By South Penn Oil Co.

0.9 mi. S. of Glover Gap.

Completed, Nov. 21, 1892.

Elevation, 1060' B.

1 1/2" casing, 37'; 10", 287'; 7-5/8", 1318'; 5-5/8", 2091';
1/2", 2178'.



	Top.	Bottom.	Thickness.
Conductor	0	15	15
Pittsburgh Coal	800	810	10
Hurry-up Sand	1260		
Dunkard Sand	1308		
Salt Sand	1723		
Big Injun Sand (salt water, 2130' + and 2196'; first pay, 2211')	2118	2240	122
Total depth		2240	