


39° 35' LATITUDE 39 35

LONGITUDE 80 27 30 80° 27' 30"

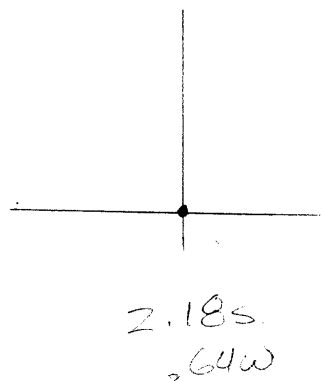

7'5 OGIS topo location

7.5' loc	<u>2.18S</u>	15' loc	_____
	<u>.64W</u>	(calc.)	_____

Company _____

Farm RACHEL EVANS I

Quad GLOVER GAP

County MARION

District MANNINGTON

WELL LOCATION MAP

File No. 70061

375 MMT Co. Log

RACHEL EVANS NO. 1 WELL.

70061
No. 22 O.F.-Marion.
No. 375 M-M-T Rept.,
tabulated only.
Vol. I(a), p. 165.

Mannington District, Marion County, W. Va.
By Hartman Oil Co.
1 mile east of Brink P. O.
Dry hole.
Elevation, 1170' B.

SEE
30330
FOR
LOCATION

	Top.	Bottom.
Pittsburgh Coal		1005
Big Injun Sand	2305	2394
Break slate	2394	2409
Squaw Sand	2409	2448
Sand	3070	3175
Slate	3175	3241
Total depth		3345½