


39° 35'

LATITUDE 39 35

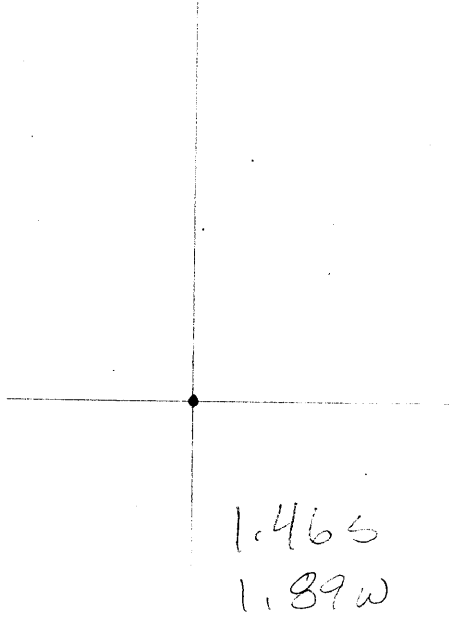

LONGITUDE 80 17 30 80° 17' 30"

7'5 OGIS topo location

7.5' loc	<u>1.46S</u>	15' loc	_____
	<u>1.89W</u>	(calc.)	_____

Company \_\_\_\_\_

Farm JAMES FLUERTY 1

Quad MANNINGTON

County MARION

District MANNINGTON

WELL LOCATION MAP

File No. 70071

Mannington District, Marion County, W. Va.

South Penn Oil Co.

Elevation, 1305' E.

2.4 mi. N. 25° E. of Mannington.

Completed, January 5, 1903.

10" casing, 230'; 8", 1322'11"; 6-5/8", 2104'10"; conductor, 16'.

498 MMT  
Co Rep



	Top.	Bottom.
Hapletown (Sewickley) Coal		714
Pittsburgh Coal		818
Salt Sand (water, 1755')	1670	1873
Pencil Cave	2080	2085
Big Lime	2085	2155
Big Injun Sand (first oil pay, 2239')	2155	2254
Total depth		2254