


39° 30'

LATITUDE 37 50'

LONGITUDE 80 22 30" 80° 22' 30"

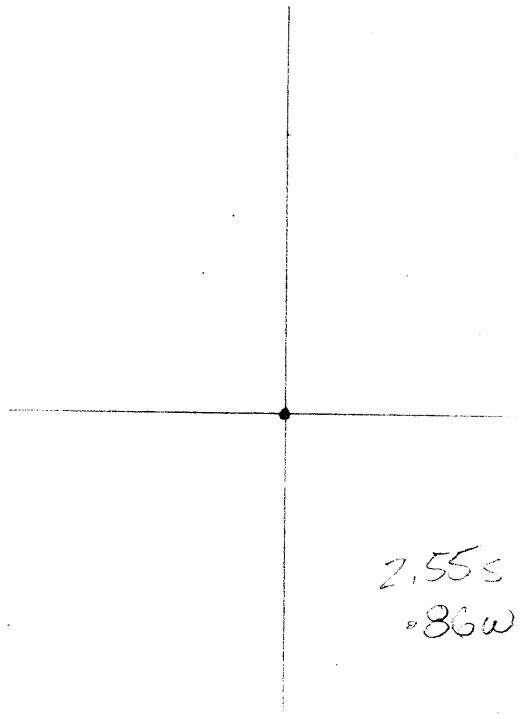

2.55S  
.86W

7'5 OGIS topo location

7.5' loc	<u>2.55S</u>	15' loc	_____
	<u>.86W</u>	(calc.)	_____

Company \_\_\_\_\_

Farm GL FORTNEY I

Quad WALLACE

County MADISON

District MANNINGTON

### WELL LOCATION MAP

File No. 70072

G. L. FORNEY NO. 1 WELL.

70072  
No. 96 O.F.-Marion.  
No. 546 H-M-T Dept.

Mannington District, Marion County, W. Va.  
By Hope Natural Gas Co.  
0.8 mi. E. of Pleasantville.  
Elevation, 1115' P.  
10" casing, 300'; 8 1/4", 1768'.



	Top.	Bottom.	Thickness.
Pittsburgh Coal		430	
Big Injun Sand		1750	
Fifty-foot Sand		2320 -	
White sand		2400	
Gordon Sand (gas, 2604')		2600	
Total depth			2655