


39° 37' 3"

LATITUDE 39 37 3

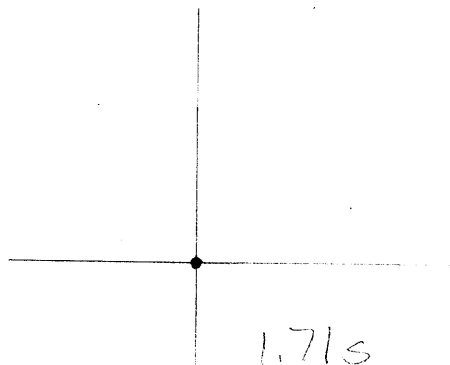

1.71S  
1.84W

LONGITUDE 80 17 30 80° 17' 30"

7.5 OGIS topo location

7.5' loc	<u>1.71S</u>	15' loc	_____
	<u>1.84W</u>	(calc.)	_____

Company \_\_\_\_\_

Farm JOHN W GRUBB 2

Quad MANNINGTON

County MARION

District MANNINGTON

WELL LOCATION MAP

File No. 70087

425 1111 6137

Mannington District, Marion County, W. Va.  
 South Penn Oil Co.  
 Elevation, 1109' L.  
 0.9 mi. S. W. of Galletin.  
 Completed, June 19, 1897.

	Top.	Bottom.
Pittsburgh Coal	800	
Salt Sand (water, 1840')	1700	1840
Big Lick (cave, 2030')	2000	2070
Big Injun Sand	2070	2210
Sand, hard, Big Injun (oil, gas, and water, 2190')	2210	2280
4th Sand (oil pay, 2996')	2996	3028
Total depth		3030