


39° 32' 30"

LATITUDE 39 32 30

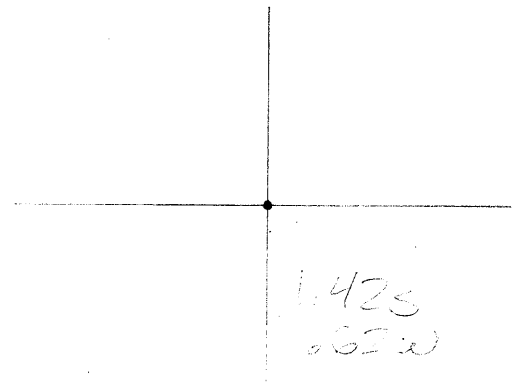

LONGITUDE 80 20 80° 20'

7'5 OGIS topo location

7.5' loc	<u>1.42S</u>	15' loc	_____
	<u>.62W</u>	(calc.)	_____

Company \_\_\_\_\_

Farm (E) HAMILTON 6

Quad MANNINGTON

County MARION

District MANNINGTON

WELL LOCATION MAP

File No. 70092

.....District, Marion County, W. Va.  
 By Flagg Meadow Oil Co.  
 Oil well.  
 Commenced July 13, 1891/ completed, Sept. 16, 1891.  
 Authority, Geo. Montgomery.  
 10" casing, 38½'; 7½", 800'; 6½", 557'; 4-7/8", 2210'.  
 Record from U. S. Geological Survey, April 8, 1939.

	Top.	Bottom.
Pittsburgh Coal	790	...
Top of Big Injun Sand (first oil, 2220'; second oil, 2234')	2154	....
Total depth		2252