


LATITUDE 39 27 30

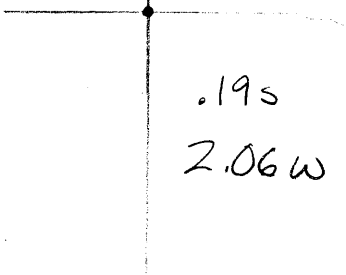

LONGITUDE 80 22 30

7'5 OGIS topo location

7.5' loc	<u>.19s</u>	15' loc	_____
	<u>2.06w</u>	(calc.)	_____

Company _____

Farm McINTIRE

Quad WALLACE

County MARION

District MANNINGTON

WELL LOCATION MAP

File No. 70137

70137

.....District, Marion County, W. Va.
By Frank Burt & Co.
On Big Binghamon Creek, near Morgan gas well.
8 1/2" casing, 90'; 6-5/8", 1400'.

	Top.	Bottom.
Coal		372
Stray Sand (oil and gas, 14' in sand)	261 1/2	
Hole filled up about 175' with oil.		