


39 37 30 LATITUDE 39 37 30

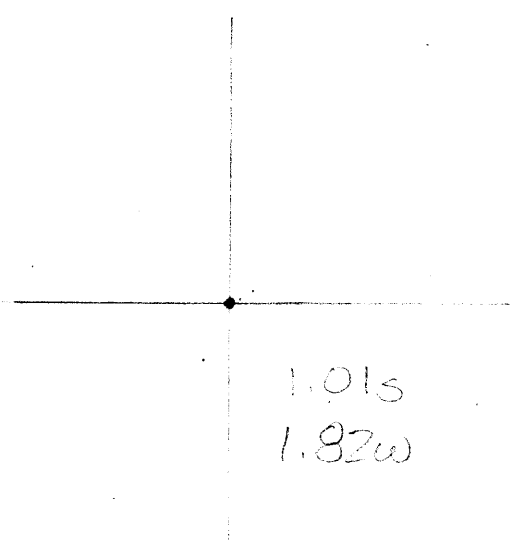

LONGITUDE 80 22 30

80 22 30

7.5 OGIS topo location

7.5' loc	<u>1.01S</u>	15' loc	_____
	<u>1.82W</u>	(calc.)	_____

Company _____

Farm E MOORE HEIRS 2

Glover Gap 7.5'

Quad Mannington (C) = 15'

County Marion

District Mannington

WELL LOCATION MAP

File No. 70141

412 M-M-T Rept.

70141

Warrington District, Marion County, W. Va.
By South Penn Oil Co.
1.0 mi. E. of Glover Gap, on Campbells Run.
Elevation, 1060' B.
10" casing, 1 1/4"; 3/4", 1332'; 6-5/8", 2119'.

3

	Top.	Bottom.	Thickness.
Conductor	0	10 1/2	10 1/2
Slate and limestone	740	750	10
Marletown (Sewickley) Coal	750	755	5
Limestone and slate	755	848	93
Pittsburgh Coal	848	855	7
Slate and red rock	855	1326	471
Dunkard Sand	1326	1473	149
Limestone and sand	1375	1770	395
Salt Sand	1770	1865	95
Slate and red rock	1865	2090	225
Big Lime	2090	2130	40
Big Injun Sand	2130	2320	190
Slate	2320	2760	440
Fifty-foot Sand	2760	2835	70
Slate and limestone	2835	2970	135
Sand	2970	2980	10
Slate	2980	2992	12
Gordon Sand (oil, 2995'), to bottom	2992	3016	24