


LATITUDE 39 37 30

LONGITUDE 80 20

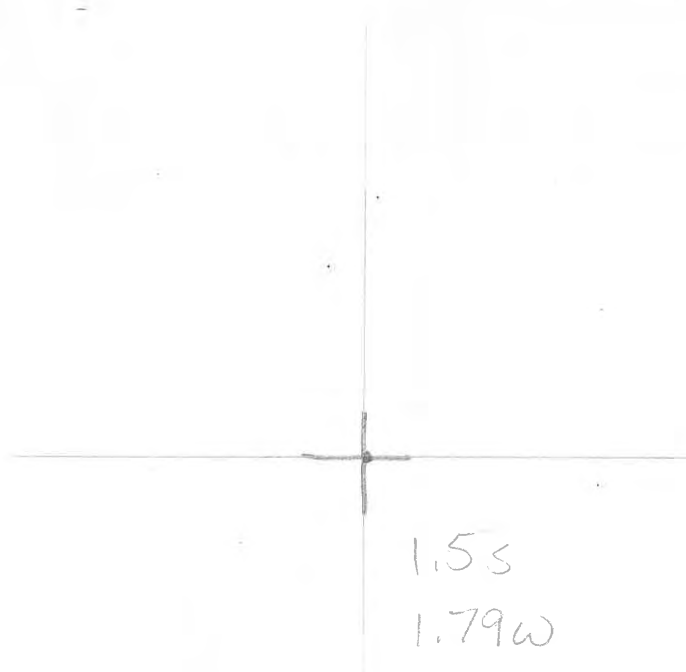

1.5S
1.79W

7'5 OGIS topo location

7.5' loc	<u>1.5S</u>	15' loc	_____
	<u>1.79W</u>	(calc.)	_____

Company _____

Farm SIMON E. MOORE I

Quad MANNINGTON

County MARION

District MANNINGTON

WELL LOCATION MAP

File No. 70144

SIMON E. MOORE NO. 1 WELL.
(SIMON & E.T.)

70144

Harrington District, Marion County, W. Va.
By Eastern Petroleum Co.

Elevation.....

Drilling commenced Dec. 7, 1920; completed April 8, 1921.

10" casing, 305' (pulled); 8", 1540' (pulled); 6", 2292' (pulled);
5", 2535' (pulled); 4" liner, 312' (pulled).

Abandoned April 16, 1921.

Record in Eastern Petroleum Co. Well Record book of Clifton Oil & Gas Co.

	Top.	Bottom.
Conductor	0	15
Native coal	925	931
Pittsburgh Coal (SLM)	1027	1033
Big Barkard Sand	1540	1615
First Salt Sand	1818	1846
Second Salt Sand (water, 1990')	1970	2040
Haxton Sand	2180	2230
Big Line	2272	2345
Big Injan Sand (gas showing, 2445')	2345	2530 (SLM)
(water, 2045')////		
Ganta Sand	2630	2660
Fifty-foot Sand	2930	3050
Thirty-foot Sand	3075	3095
Gordon Stray Sand	3175	3200 (SLM)
Gordon Sand	3205	3221
Fourth Sand (gas showing, 3286')	3268	3321 (SLM)
Total depth (SLM)		3433