


LATITUDE 39 35

LONGITUDE 80 20

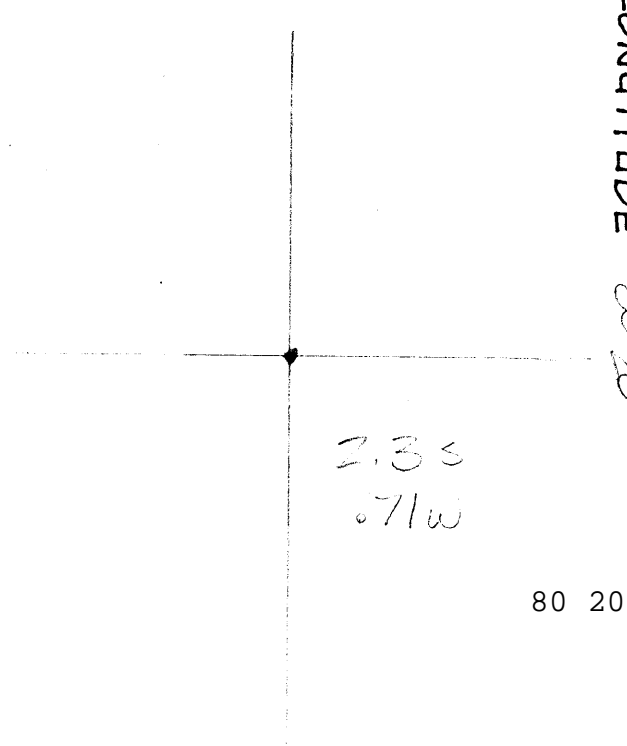

7'5 OGIS topo location

7.5' loc	<u>2.3 S</u>	15' loc	_____
	<u>.71 W</u>	(calc.)	_____

Company _____

Farm M A Morgan 2

Quad MANNINGTON

County Mason

District MANNINGTON

WELL LOCATION MAP

File No. 70147

M. A. MORGAN NO. 2 WELL.

No. 49 O.F.-Marion.
No. 492 M-M-T Rept.,
tabulated only.

70147

492 m.m. & Co.

Maunington District, Marion County, W. Va.
By Hartman Oil Co.
1.4 mi. N. of Maunington.
Elevation, 985' B.



	Top.	Bottom.
Pittsburgh Coal	505	
Dunkard Sand	1030	
Salt Sand	1460	1525
Pencil Cave	1735	
Big Injun Sand		1956
50-Ft. Sand	2450	2525
Gordon Sand	2727	2736