


39 37 30 LATITUDE 39 37 30

LONGITUDE 80 15

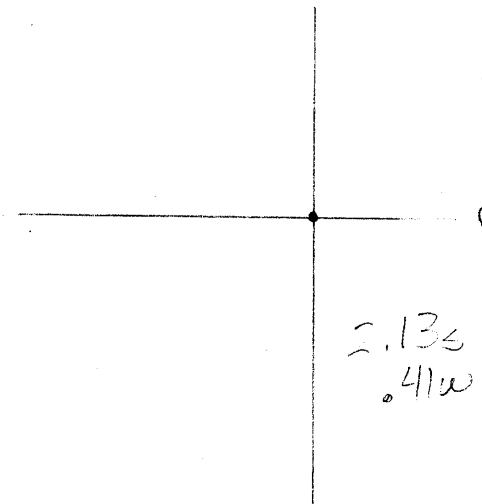

7'5 OGIS topo location

7.5' loc	<u>2.135</u>	15' loc	_____
	<u>.41W</u>	(calc.)	_____

Company _____

Farm Z F YOST 1

Quad MANNINGTON

County MARSH

District Pow Pow

WELL LOCATION MAP

File No. 70196

70196

.....District, Marion County, W. Va.
 By Fisher Oil Co.
 Near Fairview, W. Va.
 7-5/8" casing, 483'; 6 1/4", 934'.

	Top.	Bottom.
Conductor	0	16
Pittsburgh Coal	473	
Dunkard Sand	1142	
Yost Sand (water and oil) (Gas Sand) (more water, 1250')	1220	
1st Salt Sand	1283	
2nd Salt Sand	1447	
Big Red rock (115')	1674	(Bottom?)
Big Lime	1700	