

WVDEP Reclamation Plan Site Overview / Detail

Victory B 3948 (API 47-051-00162-00-00)

- BMP's and erosion control devices to be utilized per WVDEP guidelines and Columbia's WV Environmental Construction Standards.
- Existing drainage, culverts, and road ditches to be maintained.
- Minor grading and surface material to be applied as needed.

Legend

- Victory B - 03848
- Victory B 3948 Access Route
- Victory B 3948 LOD

Pit A, Pit B:
50' x 10' x 4' deep


Victory B - 03848

Google Earth

01/09/2026

RECEIVED
Department of Oil and Gas
V 24 2025
Department of
Environmental Protection



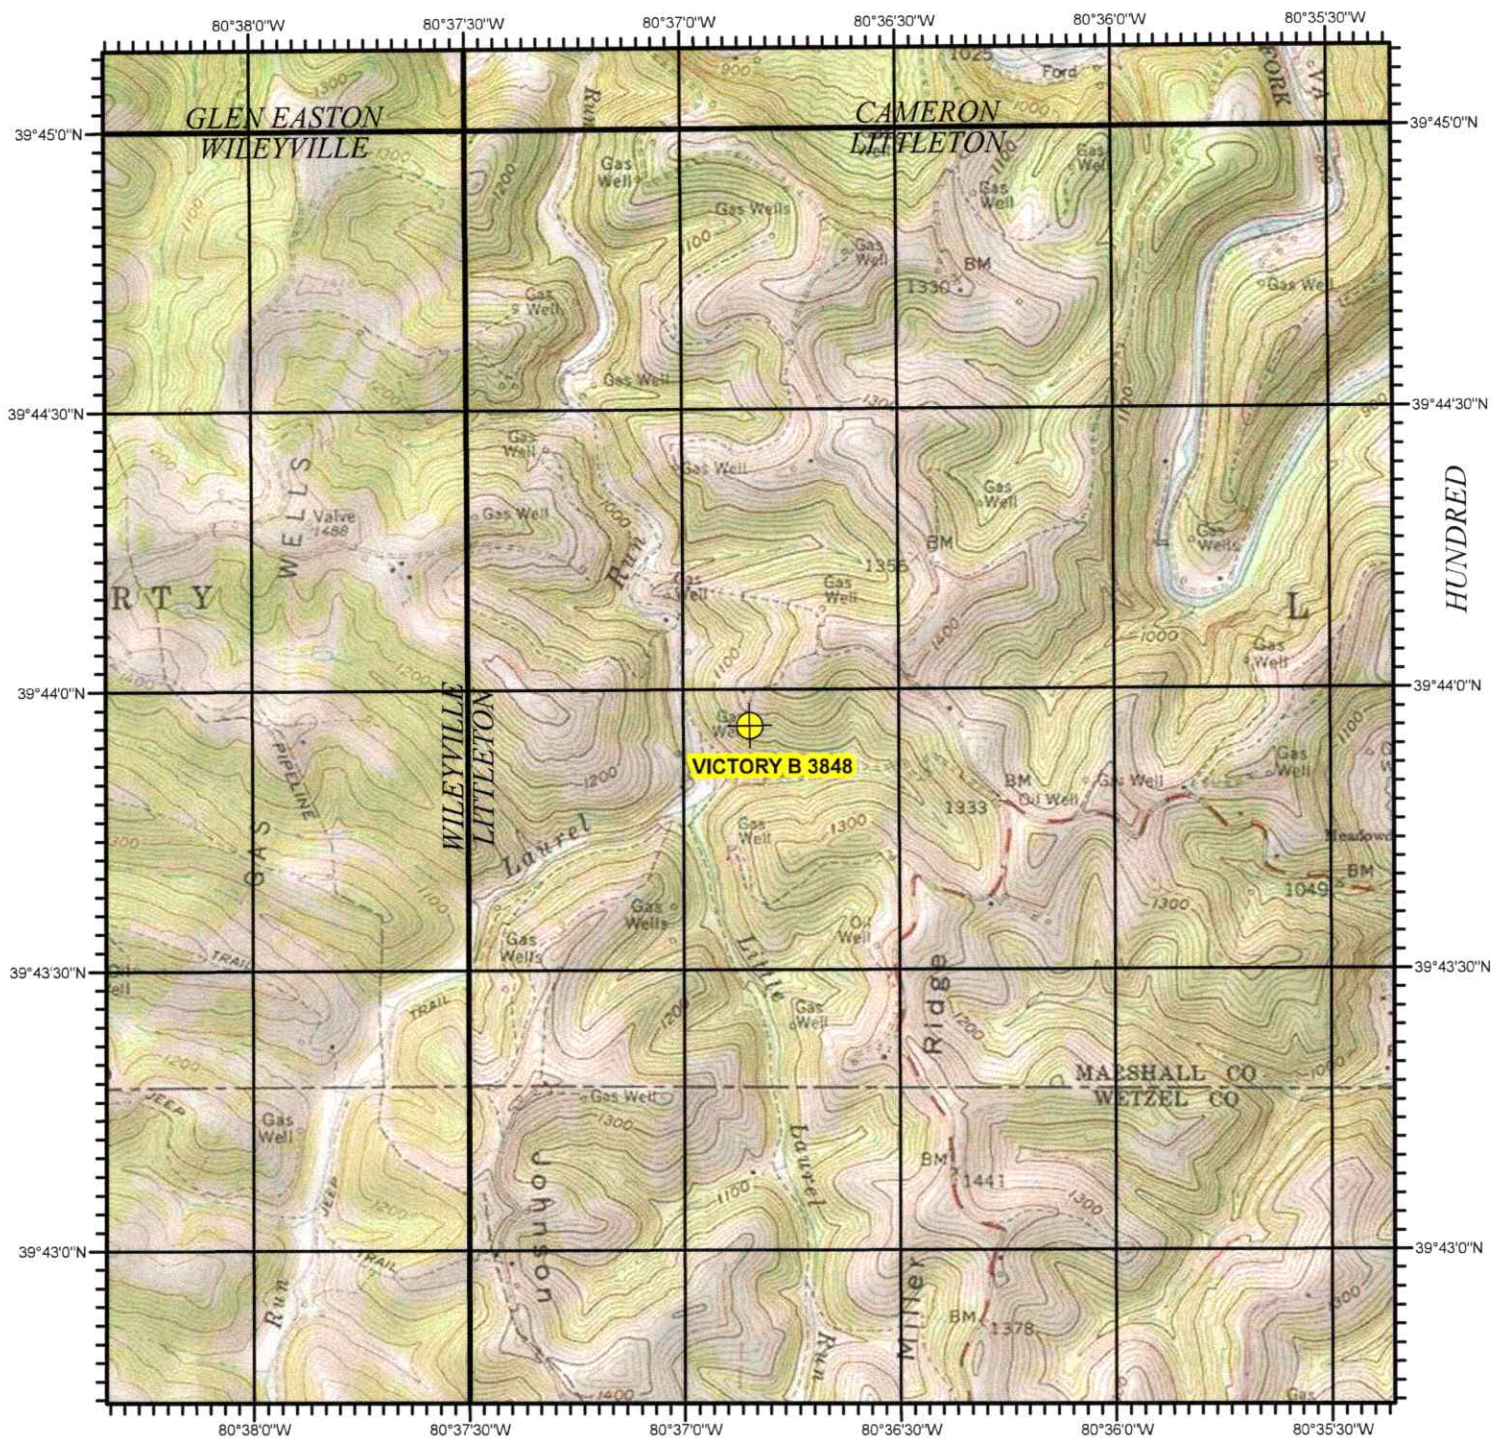


PINE GROVE

BIG RUN

GLOVER GAP

VICTORY B 3848
MARSHALL COUNTY, WV

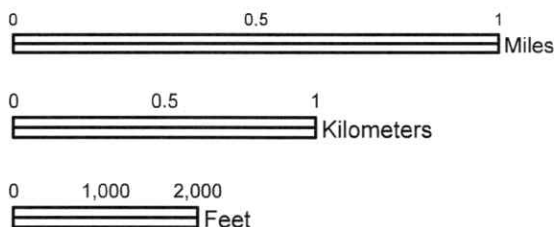

RECEIVED
Office of Oil and Gas
NOV 24 2025
WV Department of
Environmental Protection



USGS TOPOGRAPHIC QUADRANGLE
LITTLETON, WV - 1976

SCALE 1:24,000

North American 1983 Datum (NAD83)

01/09/2026

WW-7
8-30-06



West Virginia Department of Environmental Protection
Office of Oil and Gas
WELL LOCATION FORM: GPS

API: 47-051-00162-00-00 WELL NO.: Victory B 3848

FARM NAME: PYLES, VINCENT B.

RESPONSIBLE PARTY NAME: Columbia Gas Transmission, LLC

COUNTY: Marshall DISTRICT: Liberty

QUADRANGLE: Littleton, WV

SURFACE OWNER: Stern, Effie A Est Et al., C/O: Stern, Jerry G.

ROYALTY OWNER: Clark Raven, Carol J. Spence, Susan A. Richardson, Gail Richardson Barner, The Richardson Family Supplemental Trust, et al.

UTM GPS NORTHING: 4,398,112.277

UTM GPS EASTING: 533,068.023 GPS ELEVATION: 1,170'

The Responsible Party named above has chosen to submit GPS coordinates in lieu of preparing a new well location plat for a plugging permit or assigned API number on the above well. The Office of Oil and Gas will not accept GPS coordinates that do not meet the following requirements:

1. Datum: NAD 1983, Zone: 17 North, Coordinate Units: meters, Altitude: height above mean sea level (MSL) – meters.
2. Accuracy to Datum – 3.05 meters
3. Data Collection Method:

Survey grade GPS ☒ : Post Processed Differential ☒

Real-Time Differential ☐

Mapping Grade GPS ☐ : Post Processed Differential ☐

Real-Time Differential ☐

4. Letter size copy of the topography map showing the well location.

I the undersigned, hereby certify this data is correct to the best of my knowledge and belief and shows all the information required by law and the regulations issued and prescribed by the Office of Oil and Gas.

Paul Nicks
Signature

Storage Engineer
Title

10/21/2025
Date

RECEIVED
Office of Oil and Gas
NOV 26 2025
WV Department of
Environmental Protection

01/09/2026