


080° 36' 59.7839" W  
 039° 46' 08.8489" N

(CAMERON)

080° 34' 38.7412" W  
 039° 46' 08.8489" N

(WILEYVILLE)

(HUNDRED)

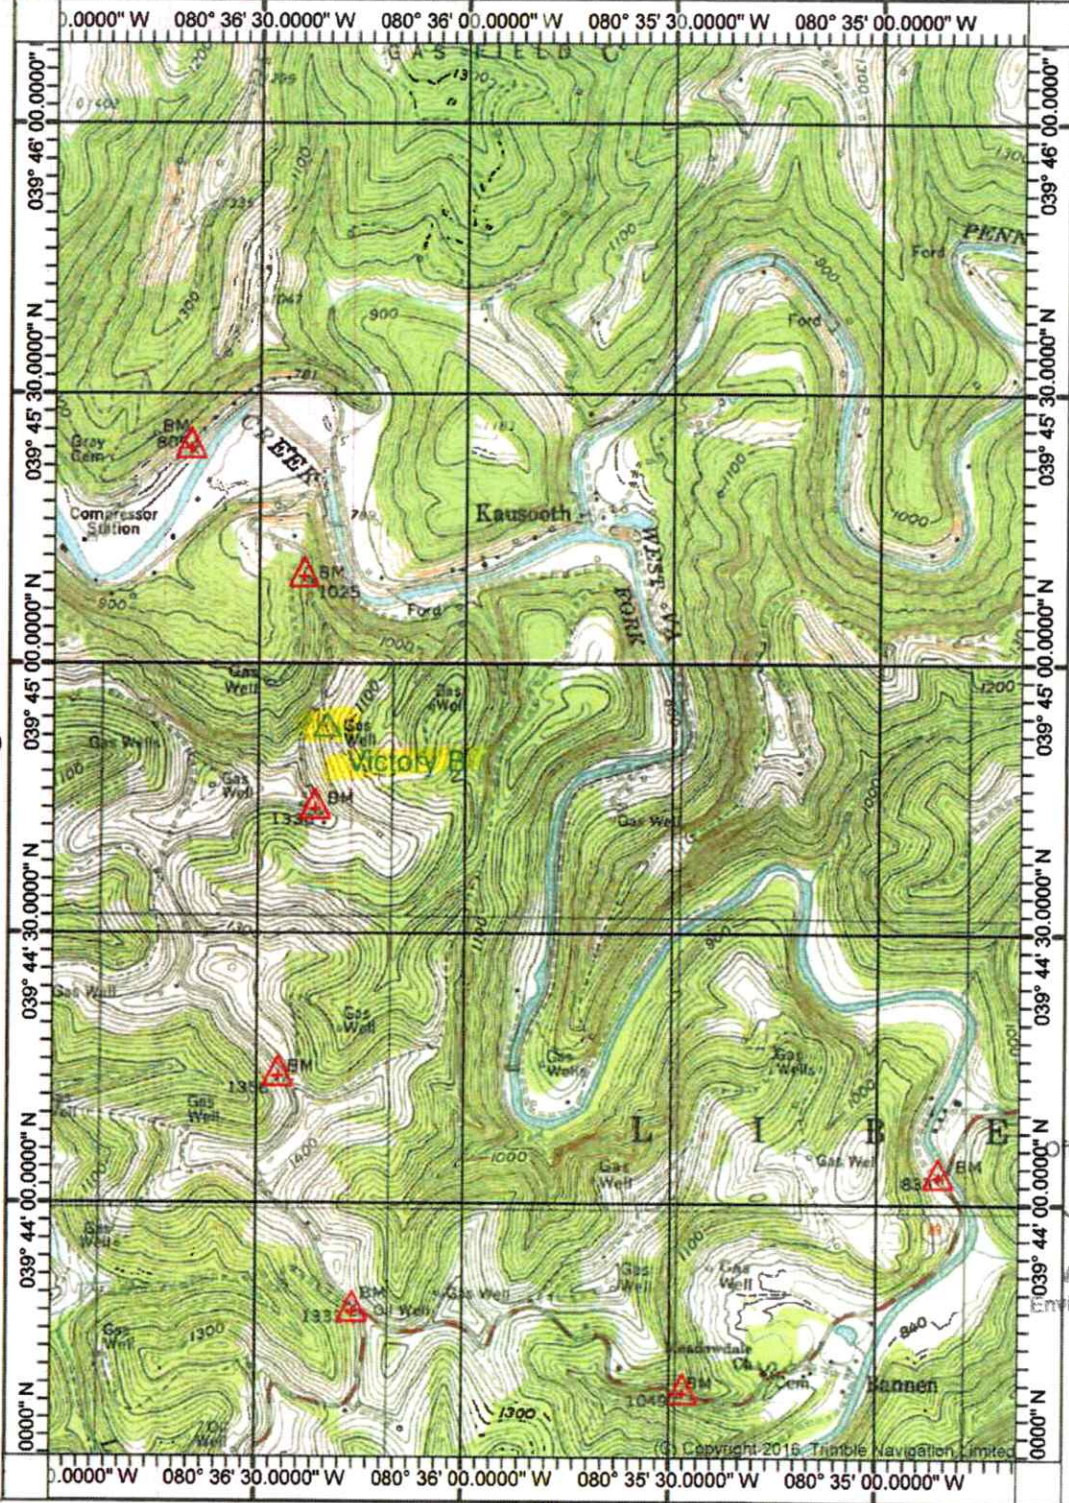

RECEIVED  
 Office of Oil and Gas  
 JAN 06 2023  
 WV Department of  
 Environmental Protection


(PINE GROVE)

(GLOVER GAP)

Produced by Trimble Terrain Navigator Pro  
 Topography based on USGS 1:24,000  
 Maps  
 North American 1983 Datum (NAD83)  
 To place on the predicted North American  
 1927 move the projection lines 9M N and  
 17M E



(BIG RUN)  
 SCALE 1:24000

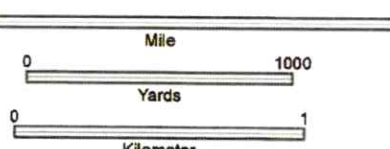

CONTOUR INTERVAL 20 FT

39080-F4-TM-024  
 LITTLETON, WV  
 JAN 1, 1998

02/23/2023

47 05 100 164

WW-7  
8-30-06



West Virginia Department of Environmental Protection  
Office of Oil and Gas  
**WELL LOCATION FORM: GPS**

API: 47-051-00164-00-00 WELL NO.: Victory B 2449

FARM NAME: CLARK, F. M.

RESPONSIBLE PARTY NAME: Brad Nelson

COUNTY: Marshall DISTRICT: Liberty

QUADRANGLE: Littleton, WV

SURFACE OWNER: Revocable Living Trust of M. Peggy Gribben

ROYALTY OWNER: Carol E. Kiger; Greenfield Resources, LLC

UTM GPS NORTHING: 4399873.94 m

UTM GPS EASTING: 533792.28 m GPS ELEVATION: 358.579 m

The Responsible Party named above has chosen to submit GPS coordinates in lieu of preparing a new well location plat for a plugging permit or assigned API number on the above well. The Office of Oil and Gas will not accept GPS coordinates that do not meet the following requirements:

- Datum: NAD 1983, Zone: 17 North, Coordinate Units: meters, Altitude: height above mean sea level (MSL) – meters.
- Accuracy to Datum – 3.05 meters
- Data Collection Method:

Survey grade GPS x: Post Processed Differential X

Real-Time Differential \_\_\_\_\_

Mapping Grade GPS \_\_\_\_\_: Post Processed Differential \_\_\_\_\_

Real-Time Differential \_\_\_\_\_

- Letter size copy of the topography map showing the well location.**

I the undersigned, hereby certify this data is correct to the best of my knowledge and belief and shows all the information required by law and the regulations issued and prescribed by the Office of Oil and Gas.

Brad Nelson  
Signature

Storage Engineer  
Title

12/12/2022  
Date

RECEIVED  
Office of Oil and Gas

JAN 06 2023

WV Department of  
Environmental Protection

02/03/2023