

WVDEP Reclamation Plan Site Overview / Detail

Victory B 4446 (API 47-051-00311-00-00)

- BMPs and erosion control devices to be utilized per WVDEP guidelines and Columbia's WV Environmental Construction Standards.
- Existing drainage, culverts, and road ditches to be maintained.
- Minor grading and surface material to be applied as needed.

Legend

- Access Routes
- Victory B - 04446
- Victory B 4446 LOD



01/09/2026

RECEIVED
Office of Oil and Gas
NOV 24 2025
WV Department of
Environmental Protection

WVDEP Reclamation Plan Site Detail

Victory B 4446 (API 47-051-003111-00-00)

- BMP's and erosion control devices to be utilized per WVDEP guidelines and Columbia's WV Environmental Construction Standards.
- Existing drainage, culverts, and road ditches to be maintained.
- Minor grading and surface material to be applied as needed.

Legend

- Victory B 4446
- Victory B 4446 Access Route
- Victory B 4446 LOD




01/09/2026

RECEIVED
Office of Oil and Gas
NOV 24 2025
WV Department of
Environmental Protection

BUSINESSBURG


MOUNDSVILLE

MAJORSVILLE

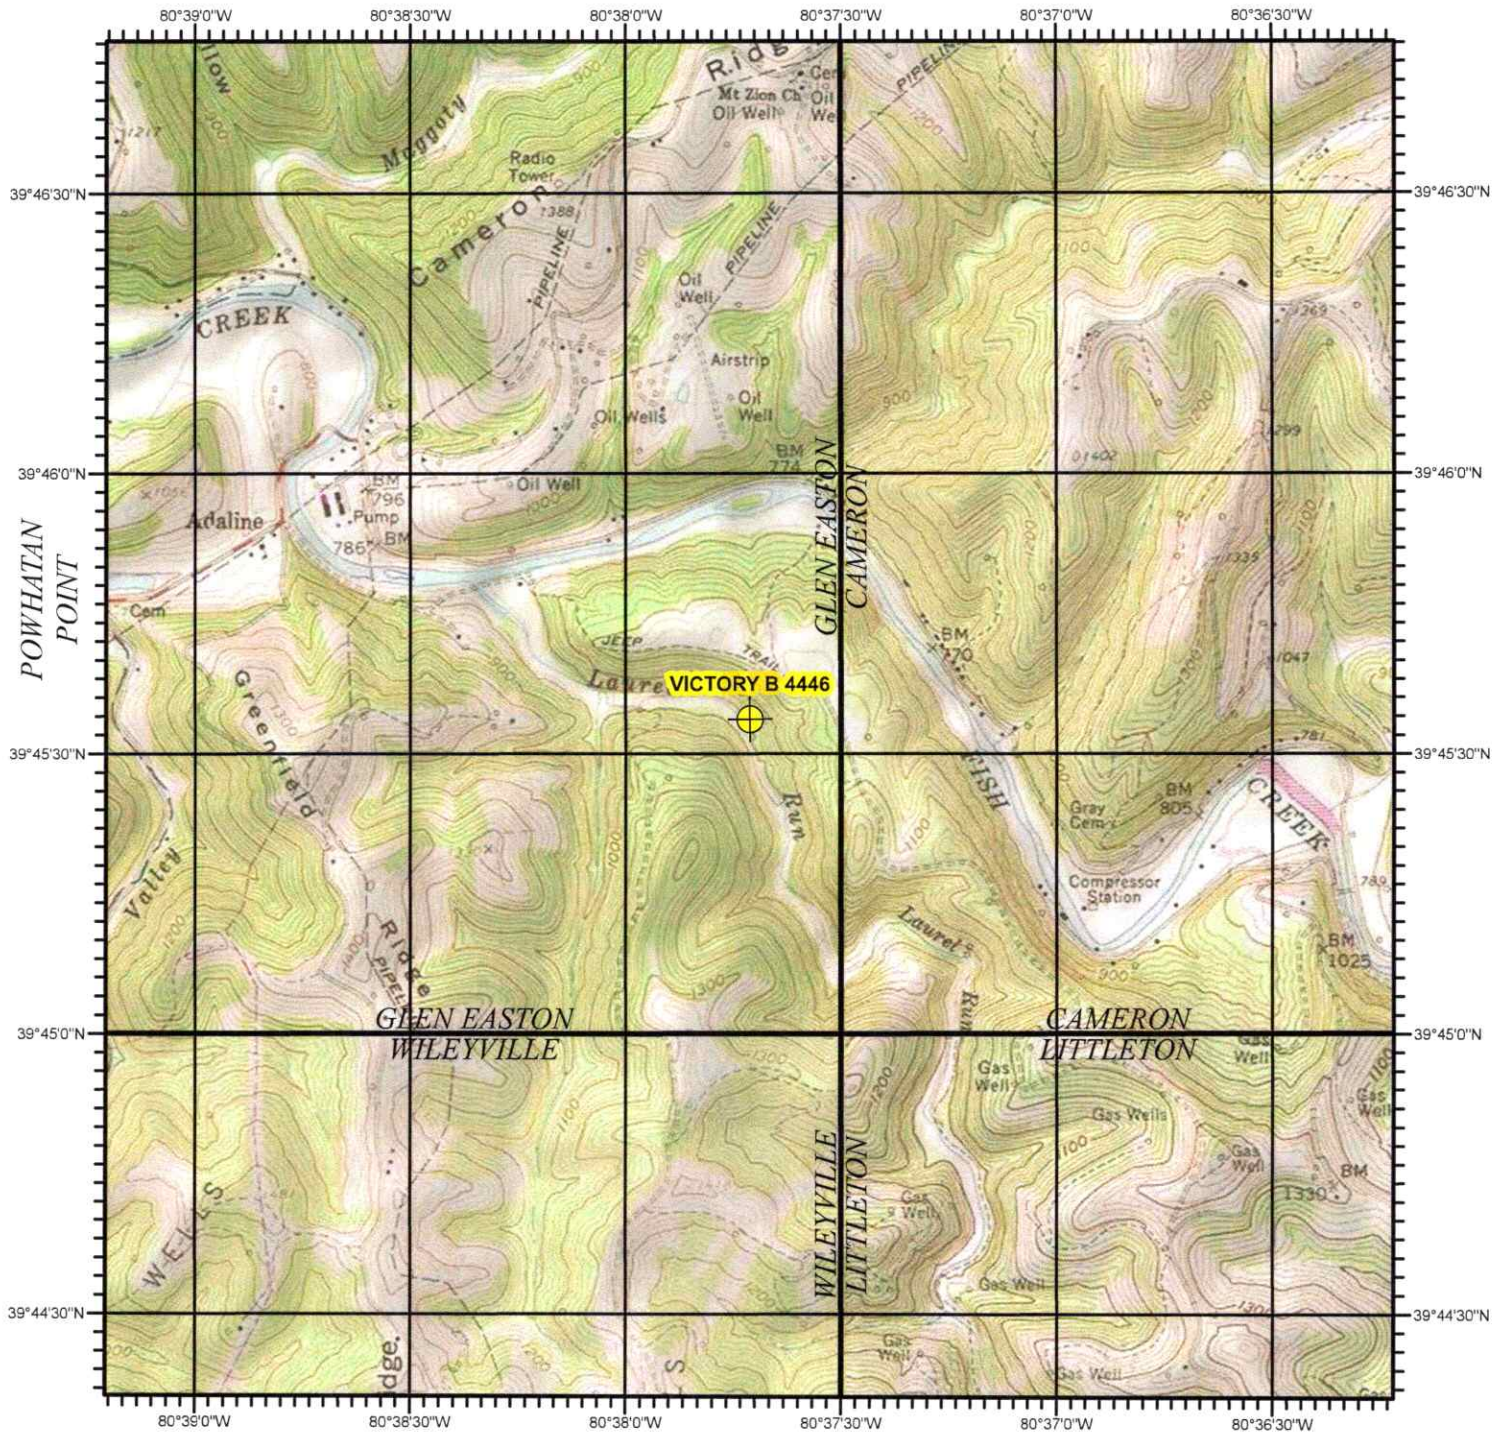

NEW MARTINSVILLE

VICTORY B 4446
MARSHALL COUNTY, WV

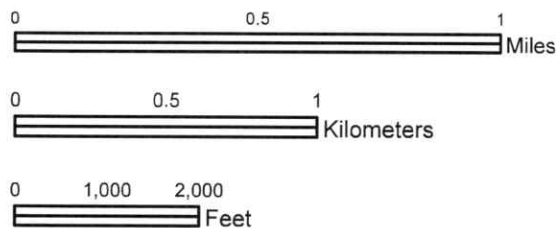

USGS TOPOGRAPHIC QUADRANGLE
GLEN EASTON, WV - 1976
North American 1983 Datum (NAD83)

SCALE 1:24,000



01/09/2026

WW-7
8-30-06



West Virginia Department of Environmental Protection
Office of Oil and Gas
WELL LOCATION FORM: GPS

API: 47-051-00311-00-00 WELL NO.: Victory B 4446

FARM NAME: THOMAS, E.

RESPONSIBLE PARTY NAME: Columbia Gas Transmission, LLC

COUNTY: Marshall DISTRICT: Liberty

QUADRANGLE: Glen Easton, WV

SURFACE OWNER: Mason Dixon Farms, LLC

ROYALTY OWNER: Brenda Sue Gittings, William H. Deal, Marc Richmond Gittings, Jennifer Wyant, Kimberly Ward, Michael Deal

UTM GPS NORTHING: 4,401,115.011

UTM GPS EASTING: 531,819.339 GPS ELEVATION: 795'

The Responsible Party named above has chosen to submit GPS coordinates in lieu of preparing a new well location plat for a plugging permit or assigned API number on the above well. The Office of Oil and Gas will not accept GPS coordinates that do not meet the following requirements:

1. Datum: NAD 1983, Zone: 17 North, Coordinate Units: meters, Altitude: height above mean sea level (MSL) – meters.
2. Accuracy to Datum – 3.05 meters
3. Data Collection Method:

Survey grade GPS x: Post Processed Differential X

Real-Time Differential _____

Mapping Grade GPS _____: Post Processed Differential _____

Real-Time Differential _____

4. Letter size copy of the topography map showing the well location.

I the undersigned, hereby certify this data is correct to the best of my knowledge and belief and shows all the information required by law and the regulations issued and prescribed by the Office of Oil and Gas.

Brent Nelson
Signature

Storage Engineer
Title

11/6/2025
Date

01/09/2026