


WVDEP Reclamation Plan Site Overview / Detail

- Victory B 4688 (API 47-051-00462-00-00)
- BMPs and erosion control devices to be utilized per WVDEP guidelines and Columbia's WW Environmental Construction Standards
- Existing drainage, culverts, and road ditches to be maintained.
- Minor grading and surface material to be applied as needed.

Legend




- Access Route
- CWA
- Victory B 4689



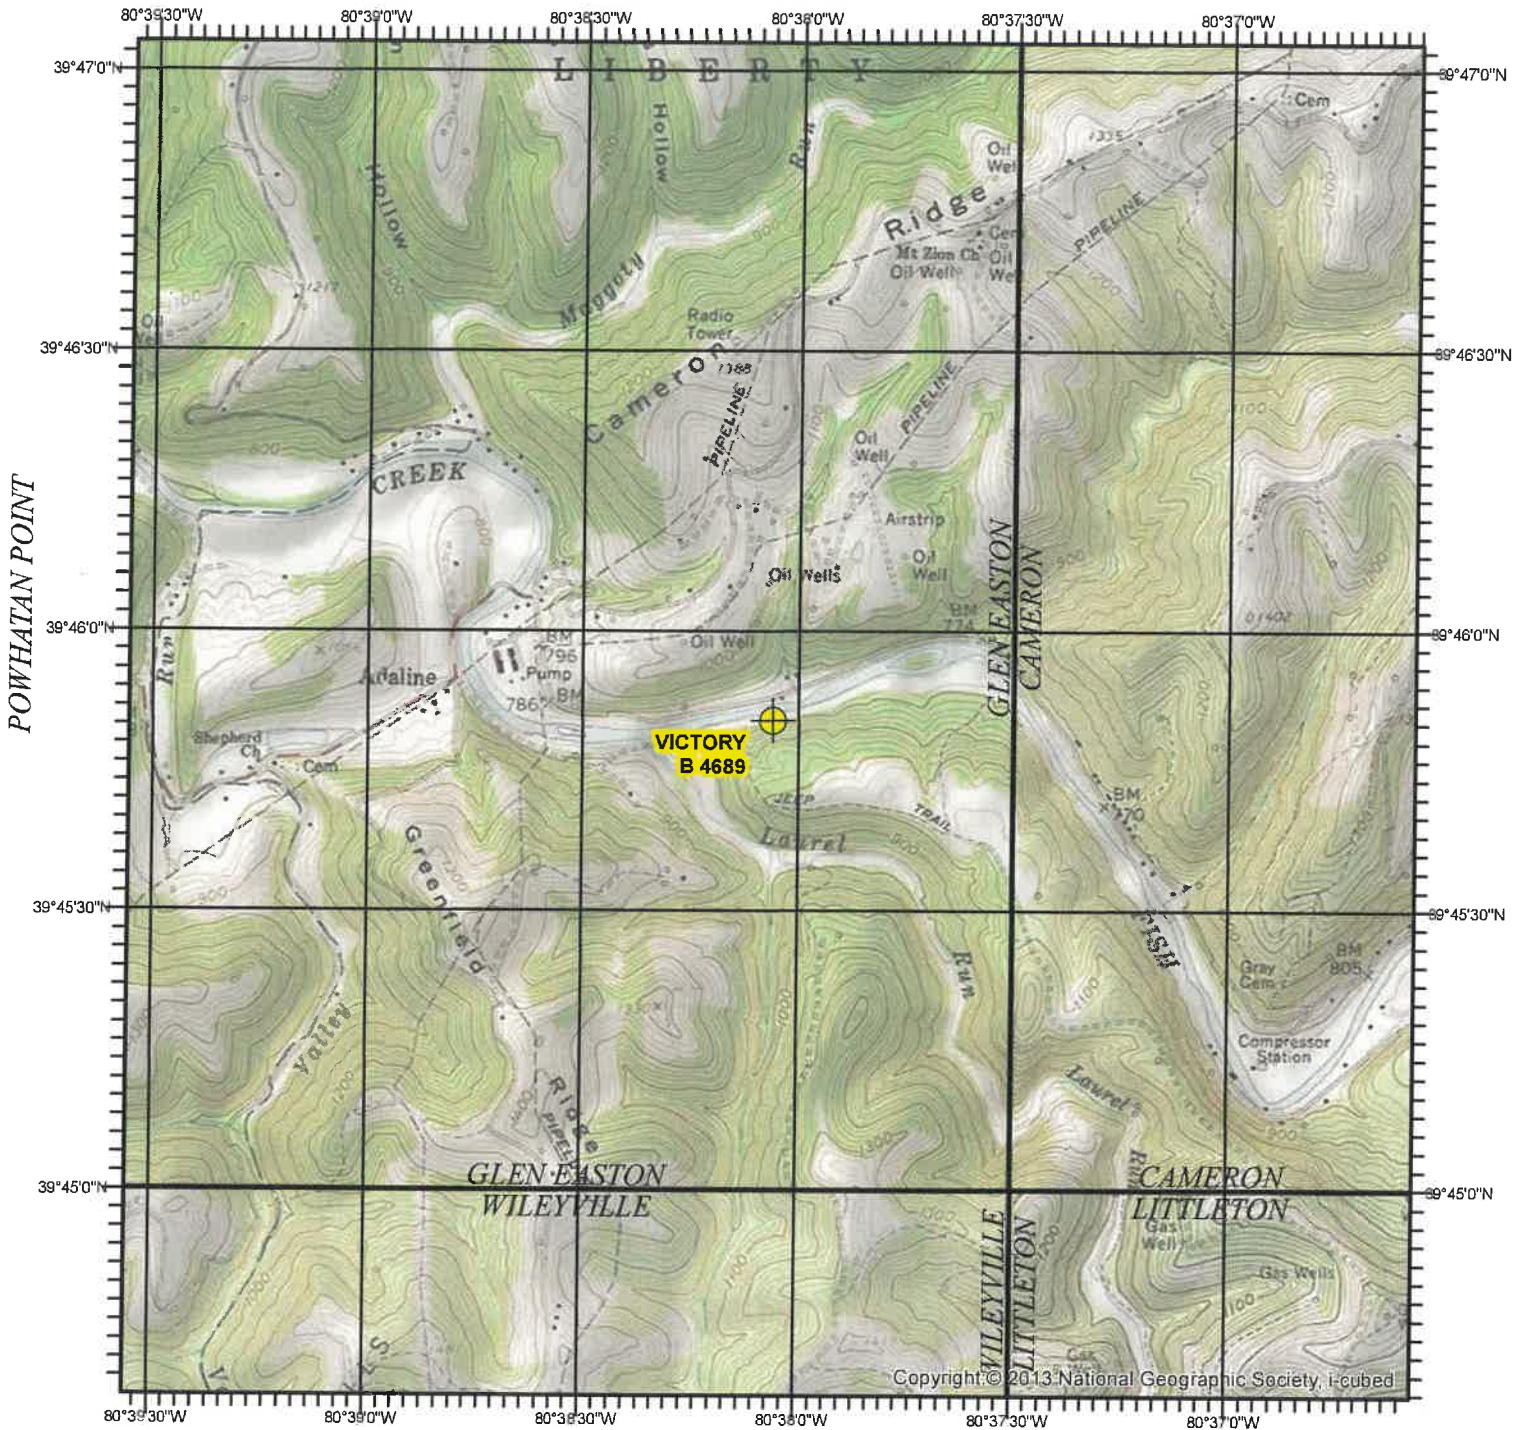

NEW MARTINSVILLE

VICTORY B 4689
MARSHALL COUNTY, WV

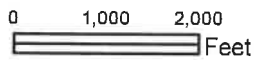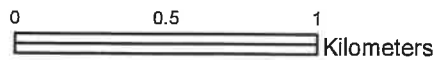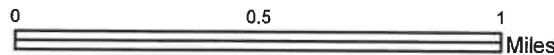

USGS TOPOGRAPHIC QUADRANGLE
GLEN EASTON, WV - 1976

North American 1983 Datum (NAD83)

SCALE 1:24,000

02/14/2025

WW-7
8-30-06



West Virginia Department of Environmental Protection
Office of Oil and Gas

WELL LOCATION FORM: GPS

API: 47-051-00462-00-00 WELL NO.: Victory B 4689

FARM NAME: YEATER, CLEMENS V.

RESPONSIBLE PARTY NAME: ~~Brad Nelson~~ COLUMBIA GAS TRANSMISSION, LLC

COUNTY: Marshall DISTRICT: Liberty

QUADRANGLE: Glen Easton

SURFACE OWNER: Thirrel A. Altman, Sr. Trust u/a/d March 16,2001

ROYALTY OWNER: Sarah Jean Chambers, Leonard Otis Haberbosch Agent, Chestnut Holdings, Inc., et al.

UTM GPS NORTHING: 4,401,629.995

UTM GPS EASTING: 531,318.590 GPS ELEVATION: 849'

The Responsible Party named above has chosen to submit GPS coordinates in lieu of preparing a new well location plat for a plugging permit or assigned API number on the above well. The Office of Oil and Gas will not accept GPS coordinates that do not meet the following requirements:

1. Datum: NAD 1983, Zone: 17 North, Coordinate Units: meters, Altitude: height above mean sea level (MSL) – meters.
2. Accuracy to Datum – 3.05 meters
3. Data Collection Method:

Survey grade GPS : Post Processed Differential

Real-Time Differential

Mapping Grade GPS : Post Processed Differential

Real-Time Differential

4. Letter size copy of the topography map showing the well location.

I the undersigned, hereby certify this data is correct to the best of my knowledge and belief and shows all the information required by law and the regulations issued and prescribed by the Office of Oil and Gas.

Digitally signed by Brad Nelson
Date: 2024.10.21 13:25:02
-04'00'

Storage Engineer

10/21/2024

Signature

Title

Date