

LATITUDE 40°00

7.5' 0.83S 0.87W

7.5 OG15 topo location
7.5' loc 0.735 15' loc 2.735
0.876 (calc.) 3.04-6

company C. E. Dague + F. Ebeling


Form C.W. Dague


J. 2.4.

Quad Majorsville 7.5 Canteron NE county Morshall
District Sand Hill

File No. OSI-91

Now: 524 Redill

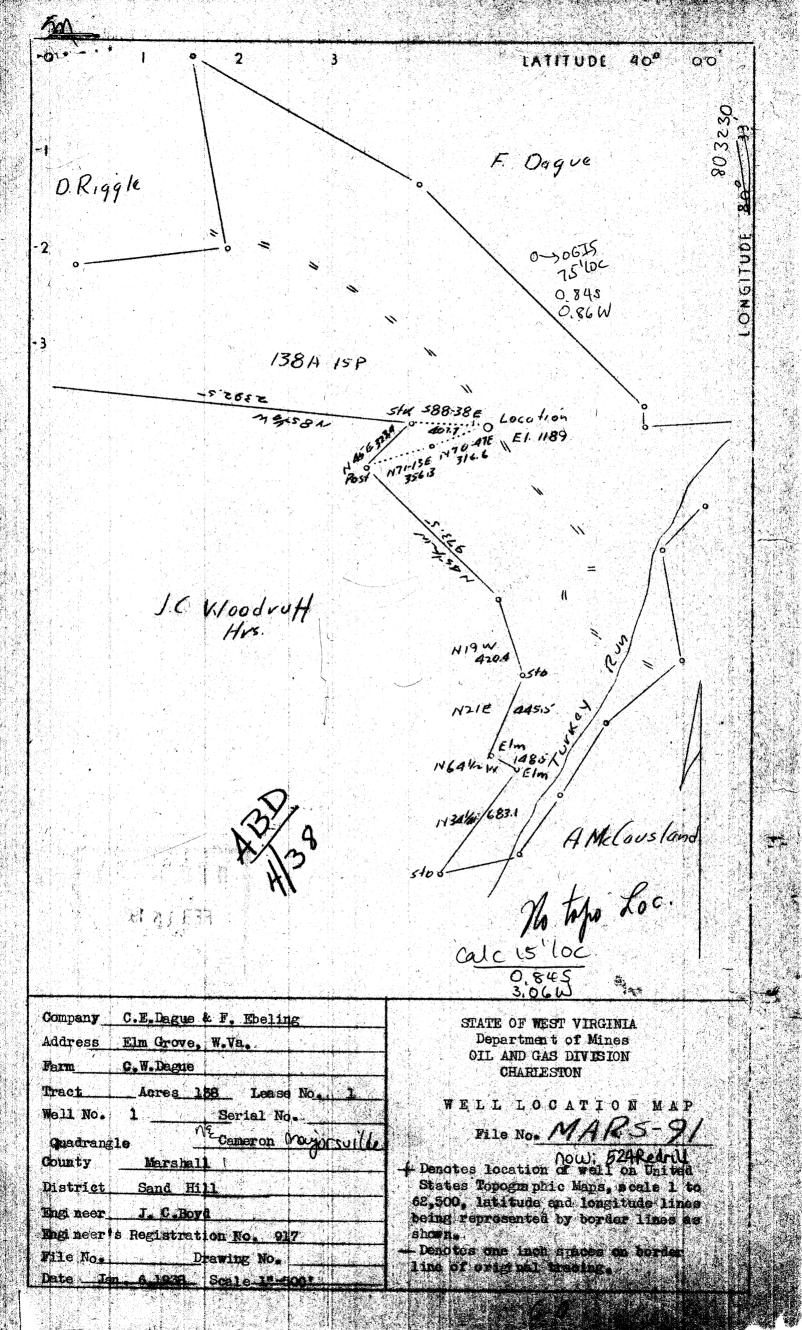

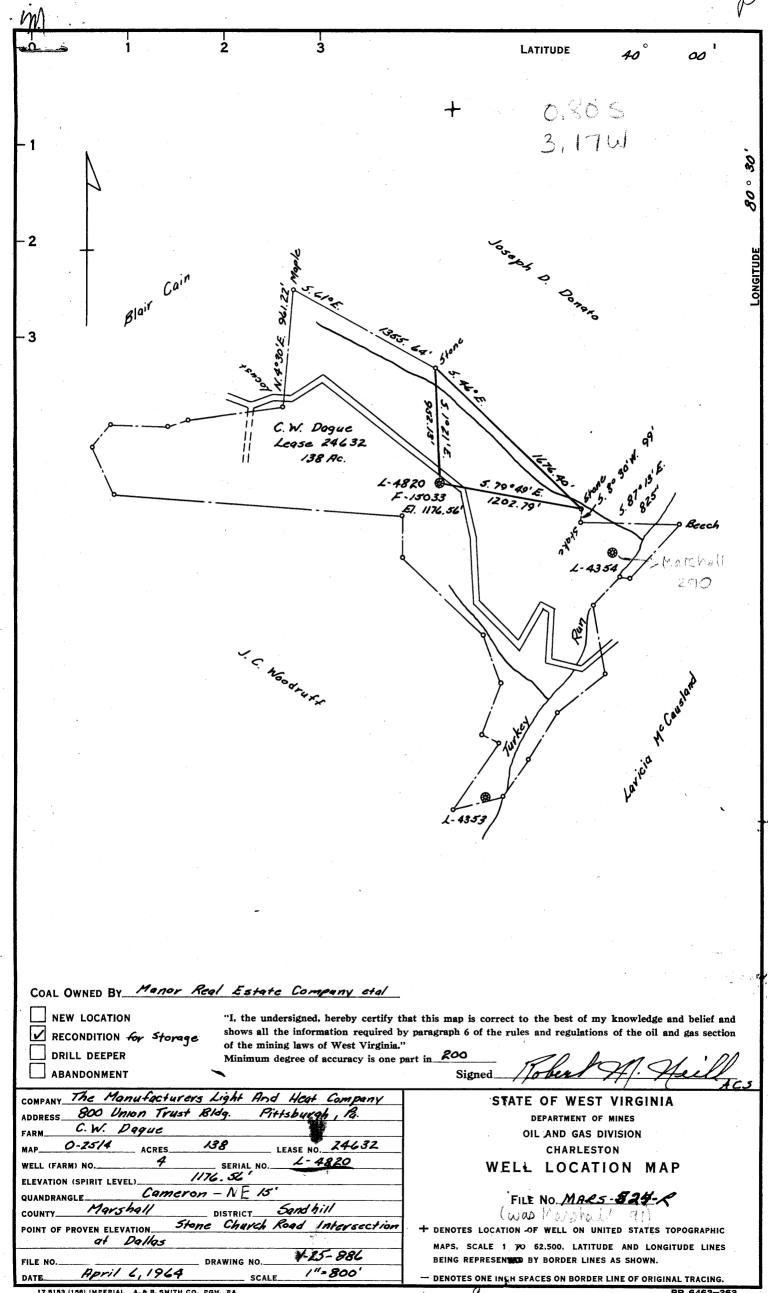

.

9 \$. 0 0 (n)

PR 6462-363



DEPARTMENT OF MINES

Redrilled to original depth of 1569'.

TOTAL DEPTH

			OIL AND	BAS DIVISION					
Quadrangle Cameron Permit No. MARS-524-R			WELL RECORD			Oil or Gas Well (KIND)			
Company The	Manufacti Union Tr	urers Light & ust Building,	Heat Compan Pittsburgh	Casing and	Used in Drilling	Left in Well	Packers		
Farm C. Location (waters	W. Dague)		Acres 138	Size			Kind of Packer		
		County Mar		18			-		
		fee by		10			Size of		
		Address		8 <u>1¢5/8"</u>	6981	<u>6981</u>			
Mineral rights ar	e owned by			6% 7"	1186'	456'	Depth set		
		Address		5 8/16					
Drilling commend			· · · · · · · · · · · · · · · · · · ·	. 8			Perf. top		
Drilling complete	d Septe	ember 21, 196	Sauds	. 8			Perf. bottom		
Date Shot 9/1			1528	Liners Used			Perf. top		
With Ord	fice Well	Tester]		Perf. bottom		
Open Flow 2			Inch						
		in			ENTED	SIZE	No. FtDate		
VolumeRock Pressure	_	lba.	Cu. Ft.						
	···		ars.	COAT WAS IN	NCOUNTERED	AT 672	FEETINCHES		
Fresh water					rINCI	HES	FEETINCHES		
		feet					FEETINCHES		
Formation	Color	Hard-or Seft	Тор	Bottom	Oil, Gas or Water	Depth Found			
		Thickness				_			
Pittsburgh Coal		5	672	677					
Sand		26	904	930					
Big Dunkard		15	1181	1196					
Gas Sand		39	1281	1320					
lst & 2nd Salt Sands		145	1383	1528	-		did not indicate roduction.		
3rd Salt		20	1549	1569	(569	1177			

1569

RECTIVED
West Virginia
Dough of Mines

WEST VIRGINIA DEPARTMENT OF MINES OIL AND GAS DIVISION

WELL RECORD

Permit No. Mars-91 - 57114:

Oil or Gas Well Dry hole (Kind)

	(Atma)				
Company C. E. Dague and Frank A Ebeling Address Elm Grove, West Virginia Frank C. W. Dague	Casing and Tubing	Used in Drilling	Left in Well	Packers	
Farm C. W. Dague Acres 138 Location (yaters) Well No. 1 Elev 1189	Size				
Location (waters)				W. LAR	
Well NoElev				Kind of Packer	
District Sand Hill County Manshall The surface of tract is owned in fee by C. W. Dague R Dallas W. Va.			***************	•••••••••••••••••••••••••••••••••••••••	
The surface of tract is owned in fee by	8¼	710151		Size of	
Address	8¼	110 5			
Mineral rights are owned by Dague	6,5X3x	1205'	******************************	Depth set	
Address	5 3/16				
Drilling commenced Feb. 18, 1938	3			Perf. top	
Drilling completed March 25, 1938	2		***************************************	Perf. bottom	
Date shot	Liners Used			Perf. top	
Open Flow /10ths Water inInch			***************************************	Perf. bottom	
/10ths Merc. inInch	Buyer or provide the second				
Volume Not enough to test Cu. Ft. CASING CEMENTED SIZE No.					
Rock Pressurelbshrs.	***************************************		*******************	***************************************	
Oil none bbls, 1st 24 hrs.	COAL WAS E	NCOUNTERE	_{D AT} 568	FEETINCHES	
Oil none bbls., 1st 24 hrs. Fresh water no feet 671 feet	665 FEE'	TINC	HES	FEETINCHES	
NO Salt waterfeetfeet	FEE'	T INC	HES	FEET INCHES	

Formation	Color	Hard or Soft	Тор	Bottom	Oil Gas or Water	Depth Found	Remarks
Conductor	·		0 -	13			
Lime	gray	hard	13	18			
lime shell		soft	18	278	water	40 ft.	
lime	gray	hard	278	563		,0 10.	
shale	black	soft	563	568			
maple town							
coal	black	soft	-568	571			
shale	white	soft	571	590			
lime	gray	hard	590	655			
shale	black	soft	655	665			
gh coal	11	soft	665	671	water	671	
shale	white	11	671	704		0,12	
lime	11	hard	704	740	710 -54		
red rock		soft	740	750	4	6-3077 83 33 S	-
lime	tt	hard	750	775	(35)	V. W. W. W. Y.	<u> </u>
red rock		soft	775	860	130	MAN DATE TO A MAN AND AND AND AND AND AND AND AND AND A	
shale	gray	11	860	918		10/1/10	\Box
little	G= ,)	108.19.19.19.19.19.19.19.19.19.19.19.19.19.	Wally and Litter	W
unkard sant	1 . "	soft	918	938	(99)	1821 1831 B	1
ed rock	_	11	938	975	150	Ada	رر ا
ime shells	white	hard	975	1071			
hale	black	soft	1071	1085		3/0/1/01/00	e .
ig Dunkard			•		101		
an d	gray	soft _	1085	1260	1	44	##
hale	.,	11	1260	1275	129	'	*
as sand	11	n ,	1275	1325	1		
shale	black	11	1325	1335			wy .
andy lime	gray	hard	1335	1345		10cm	\ \ \ \ \ \ \ \ \ \ \ \ \ \ \ \ \ \ \
hale	white	${ t soft}$	1345	1372		AN . N	1
first salt			_		·	$\gamma^{\prime\prime}$ \mathcal{M}	ω
sand	gray	soft	1372	1423	.114	, Wil	0 247
shale	black	* 11	1423	1440	(14)	- 12	
and(stray)	gray	11	1440	145 1	1	W h	128
shale	black	11	1451	1459	I M	المنتقيل	130
2nd salt sa	ind gray	11	1459	1503		July 4/3	Γ'
RUGITR		hard	1503	1541	M	1	
Maxon sand	**	s oft	1541	1566	leulle utrit gas	` 1557 }	verylight
Total depth	L _.			1566	1		
						<u>.</u>	
						·	

Consolidation Coal Company

Coal Operator or Owner 50 Racetrack Road, Washington, Pa. 15301

Address

Coal Operator or Owner

Address

STATE OF WEST VIRGINIA DEPARTMENT OF ENERGY OIL AND CAS WELLS DIVISION

AFFIDAVIT OF PLUGGING AND FILLING WELL

AFFIDAVIT SHOULD BE MADE IN TRIPLICATE, one copy mailed to the Division, one copy to be retained by the Well Operator and the third copy (and extra copies if required) should be mailed to each coal operator at their respective addresses.

Consolidation Coal Company

November 20,

Sandhill

Name of Well Operator 450 Racetrack Road, Washington, Pa. 15301

WELL AND LOCATION

Complete Address

District

C. W. Dague	Marshall				County		
Lease or Property Owne	er	-				count.	y
		WELL NO.		MARS #524			
Address							
	•	C. W.	Dague	9	•		Farm
STATE INSPECTOR SUPERVISING PI	LUCGING	Randa	pl	Micke			
•	. A F F T	IDAVIT			Office	R	· ·
•	****	ZDILV LI			NOW	OFT	
STATE OF WEST VIRGINIA,					h ~		Contract of the second
County of Harrison	ss:			10	m On	J. 70	
G. Andrew Lang		and Geo	orge I	R. Gore	Con Toon	B	75 p
being first duly sworn accord	ing to law de	epose and say	that	they are e	xperie	nced 1	n the
work of plugging and filling o	oil and gas t	wells and wer	e emp	loyed by	lonso la	dation	1
Coal Company , well o	perator, and	participated	in t	he work of	pluggi	ng and	f111-
ing the above well, that said	work was con	mmenced on th	e 1st	day o	f No	vember	
19 <u>95</u> , and that the well w	as plugged ar	nd filled in	the f	ollowing ma	nner:		
							!
Sand or Zone Record	Filling 1	Matorial		D1 !!			
	TITILIE I	maceriar		Plugs U		ł	sing
Formation				Size &	Kind	PULLED	CSO LEF.T_IN
Cleaned out wellbore with 6½"				8_5/8"		-0-	704'
from 730' to 940' through pre						ļ	
casing cemented in, cannot pu casing from 670' thru Pittsbu				<u> </u>			
hole from 940' back to surface				<u> </u>		ļ	
thixatropic cement and 206 sa							
Sent cement plug from 940' to	540' with	thixatropic co	ement.	•			
Sent cement plug from 540' to				·			
did circulate. Used 2,000 ga	llons of mud	flush.				ļ	
, ,							
TOTAL SOLID CEMENT PLUG:	940 feet						· · · · · ·
					,		
				//	1 111	,	
·				•	MA	121	21 98
Coal Seams			.	Descript	ion of	Monum	ent
(Name) Pittsburgh	678 feet	to 685 feet		Engraved st	eel pl	aque	
(Name)				stating: Co	nsolid	ation	
(Name)				Coal Co. We			
(Name)	<u> </u>			Permit #47	-051-00)524-P	
and that the work of plu		lling said we	2 1 1 wa	s completed	on th	e ^{9th}	day
of November, 19	95	•	M /	$\mathcal{I}(\mathcal{I})$	ΛX		
And Aforther deponents so	ilth, not.	· /	A) La	ZAID X.	//\	~_	_

20th day

commission expires:

ly, commission expires June 29, 1999

NOTARY PUBLIC ATE OF WEST YINGINIA

ibedhheforeimeethis 14. Clars, WV 26408

47-051-00524-P

Notary Public