



West Virginia Department of Environmental Protection Office of Oil and Gas

WELL LOCATION FORM: GPS

WELLL	JUNITURI FURNI: GPS	
_{API:} 47-051-00615	WELL NO.:	Wayt #5
FARM NAME: Consol		
RESPONSIBLE PARTY NAME	Erika Whetstone	
	bistrict:	perty
QUADRANGLE: Glen Eas	ton	
SURFACE OWNER: Consolidation Coal Company/Murray Energy C/O Land Dept		
ROYALTY OWNER:		
UTM GPS NORTHING: 4,4	105,605.355 Meters	(1245')
UTM GPS EASTING: 530,54	7.760 Meters GPS ELEVAT	TION:
The Responsible Party named above preparing a new well location plat of above well. The Office of Oil and Othe following requirements: 1. Datum: NAD 1983, Zorn height above mean sea 1 2. Accuracy to Datum – 3. 3. Data Collection Method Survey grade GPS × : Post P	for a plugging permit or assigned Gas will not accept GPS coordinate: 17 North, Coordinate Units: mevel (MSL) – meters. 05 meters	API number on the tes that do not meet eters, Altitude:
	Time Differential	RECEIVED Office of Oil and Gas
Mapping Grade GPS: Pos	st Processed Differential	MAY 8 2019
	al-Time Differential	WV Department of Environmental Protection
4. Letter size copy of the I the undersigned, hereby certify the belief and shows all the information prescribed by the Office of Oil and	n required by law and the regulation	knowledge and
En flight	Permitting Manager	5/4/19
Signature	Title	Date

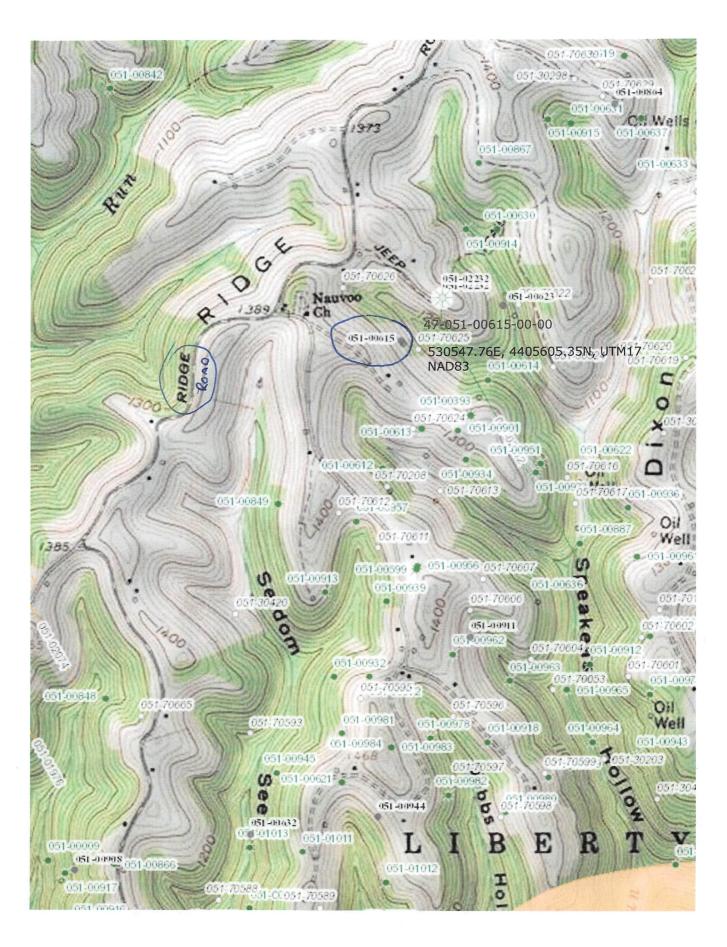

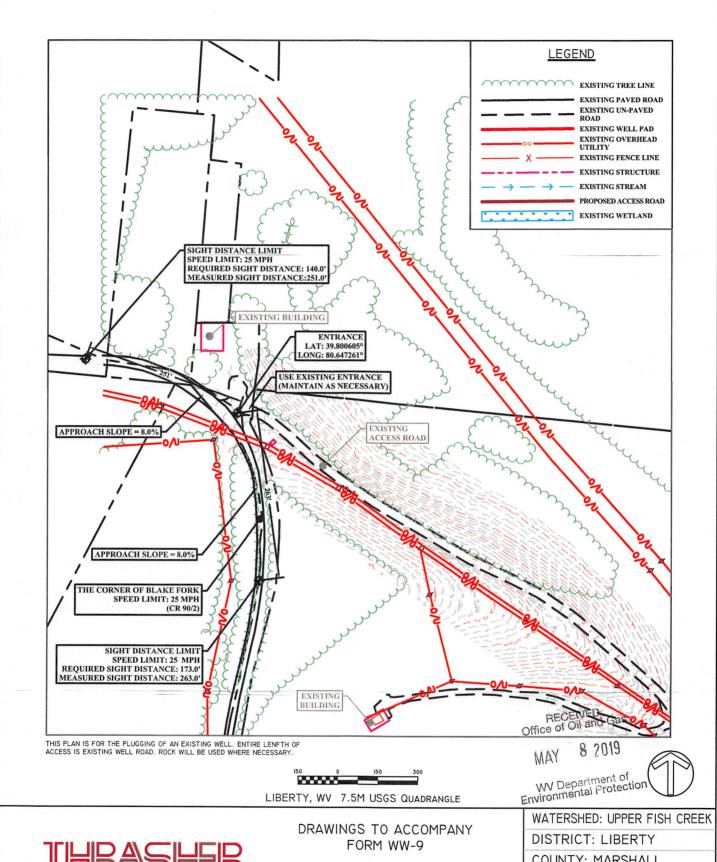



THE THRASHER GROUP, INC.

600 WHITE OAKS BOULEVARD - BRIDGEPORT, WV 26330 PHONE (304) 624-4108 FAX (304) 624-7831


CNX GAS COMPANY LLC 1000 CONSOL ENERGY DRIVE CANONSBURG, PA 15317

COUNTY: MARSHALL

WELL #: WAYT - 5

API #: 4705100615 DATE: 04/17/19

PAGE: I OF 2

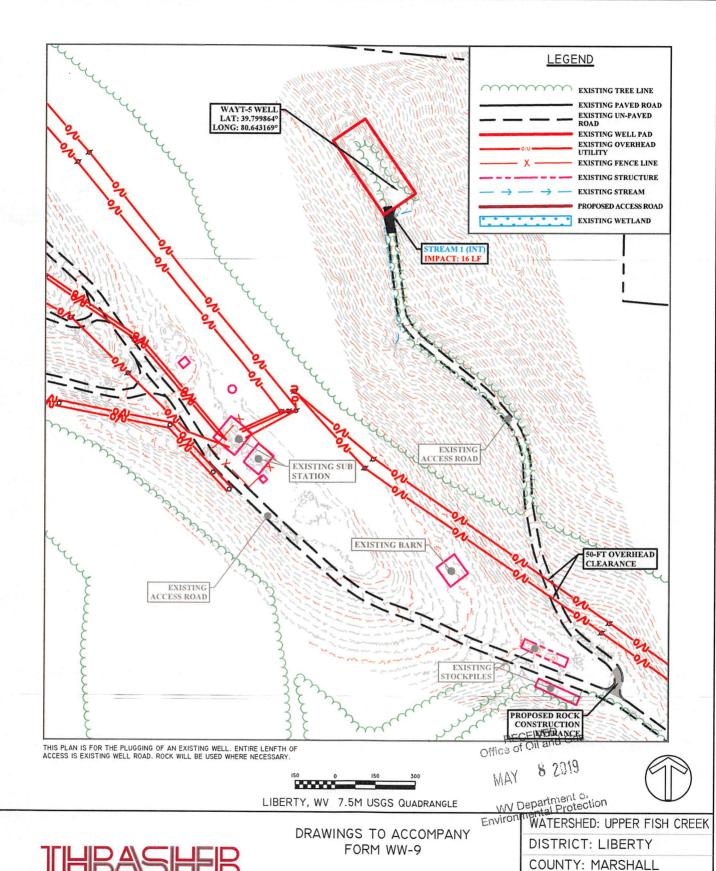

THE THRASHER GROUP, INC.

600 WHITE OAKS BOULEVARD - BRIDGEPORT, WV 26330 PHONE (304) 624-4108 FAX (304) 624-7831

CNX GAS COMPANY LLC 1000 CONSOL ENERGY DRIVE CANONSBURG, PA 15317

WELL #: WAYT - 5

API #: 4705100615

DATE: 04/17/19 PAGE: 2 OF 2