


INSTRUCTIONS

- 1) Attach a photo copy of the location of the well on a 7.5 minute Quadrangle with the corresponding Longitude and Latitude.
- 2) Designate the location of the well with the symbol(+).

80°42'30"

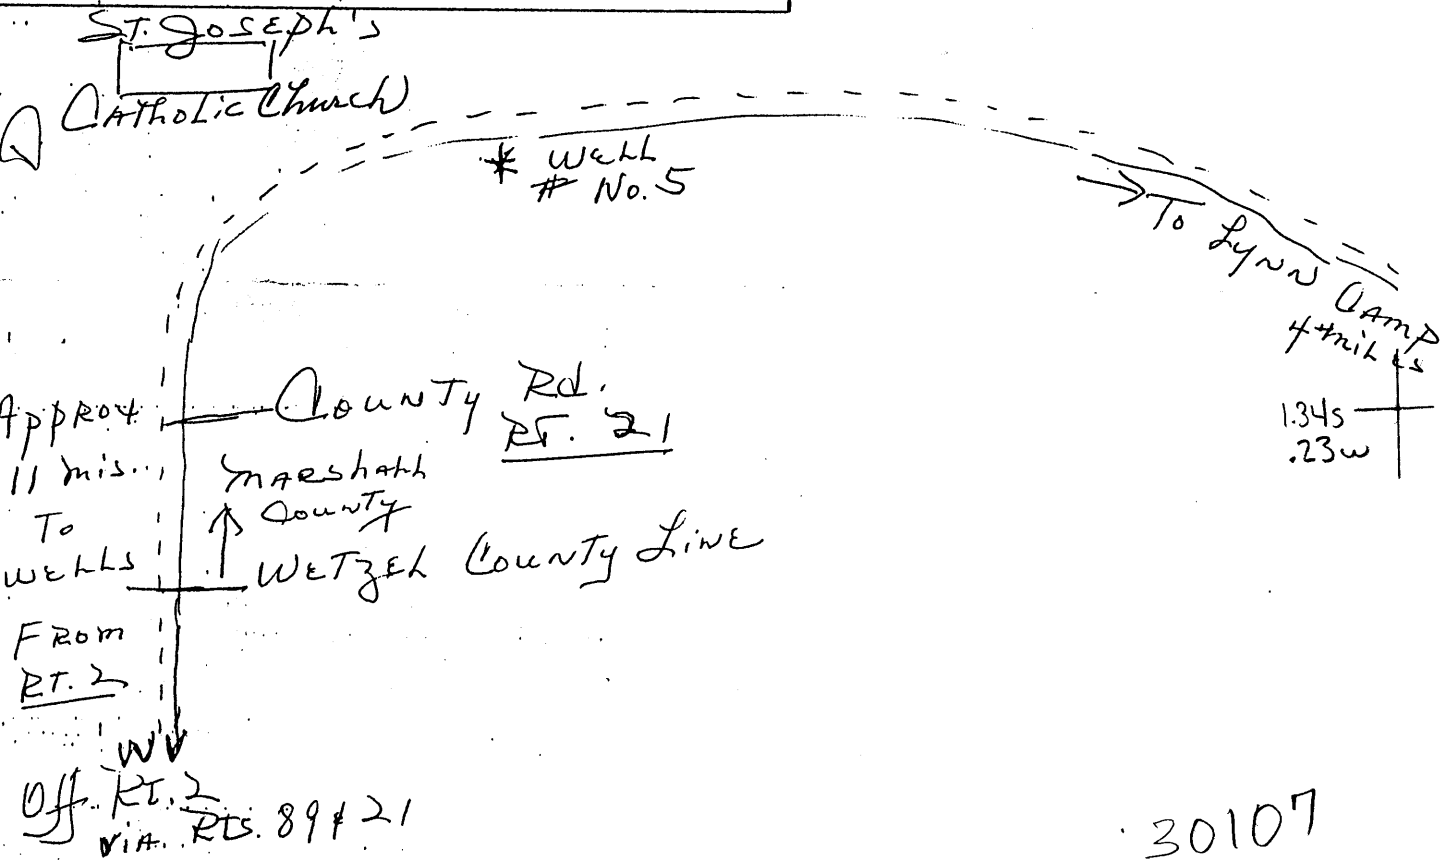

I, the undersigned, Hereby certify that this plat is correct to the best of my knowledge and belief.

SIGNED Evaristus J. Klug
TITLE Agent

DATE March 28, 19 89

OPERATORS WELL NO. #5

API WELL NO. 051-0720

STATE OF WEST VIRGINIA
DEPARTMENT OF ENERGY
OIL AND GAS DIVISION

WELL TYPE: OIL GAS LIQUID INJECTION _____ WASTE DISPOSAL _____
If "GAS" PRODUCTION STORAGE _____ DEEP _____ SHALLOW _____

LOCATION: ELEVATION _____ WATER SHED _____
DISTRICT Meade COUNTY Marshall
QUADRANGLE WILEYVILLE 7 1/2

SURFACE OWNER P.J. & E.J. Klug ACREAGE 58 acres.

OIL & GAS ROYALTY OWNER E.A. & A.J. Klug Heirs LEASE ACREAGE _____
LEASE NO. _____

PRODUCING FORMATION Gordon Sand TOTAL DEPTH 3120 ft.

WELL OPERATOR E.A. & A.J. Klug Heirs DESIGNATED AGENT Evaristus J. Klug

ADDRESS Rt. #1., Box 178 ADDRESS Rt. #1., Box 178
Proctor, WV 26055 Proctor, WV 26055

455-3773