
: , ,				A
INSTRUCTIONS		5	950	
1)Attach a photo copy	of			
the location of the well on minute Quadrangle with the c		•		
Longitude and Latitude. 2)Designate the location	on of the			
well with the symbol(+).			,	
- mer 1773				(
Viii Lasion of				
. Pyrichmental Protection	120			, , , , , , , , , , , , , , , , , , ,
M. 0. 9 90 Permitting	904	• •		
infine of Oil & was				
				•
,				
SEE ATTACHEO	PHOTO COPY	•	!)
				· · · · · · · · · · · · · · · · · · ·
17				ĵ
			: : •	(X
		•		
			•	
, the undersigned, Hereby Ce	rtlfy that			
his plat is correct to the b nowledge and belief.	est or my	SIGNED	10/	
		TITLE Real		
Marine Commission of the Commi		11100	1	
J. J. (W.A)		DATE JULY	2	_,19 <u>93</u>
DOWLER WELL #1		OPERATORS W	ell no	1
DRILLED 1904-1916		VAI METT NO	1651-	745-N=
	STATE OF WEST VI	·		
	DEPARTMENT OF E			
ELL TYPE: OIL GAS LL			j osat.	
LE "GAS" PRODUCTIONSTOR	AGEDEEP	_SIIALLOW	, , , , , , , , , , , , , , , , , , , ,	
OCATION: · ELEVATION 1345	WATER SHED	10001/01	· · · · · · · · · · · · · · · · · · ·	S. Ald
OCATION: ELEVATION 1345 DISTRICT 13ERT QUADRANGLE CAME	(4) COUNTY	MARSAALI 515E		
JRFACE OWNER HARMAN B				
LEASE NO.	DALL LEE DOL			<u>6</u>
	ه.	0		. /
RODUCING FORMATION FOURTH	SANO 838	TOTAL DE	PTII 338	<u>v</u> .
ELL OPERATOR <u>CAMERCA</u>	FAS CO. DE	SIGNATED AGENT	C.R. COL	EMAN
oukess 8 ADALINE	AUE NO	DRESS		1 6 1993
CAMERON W.U. B	16033		JUL	- 0 1333
6-(∞	(024)	İ	

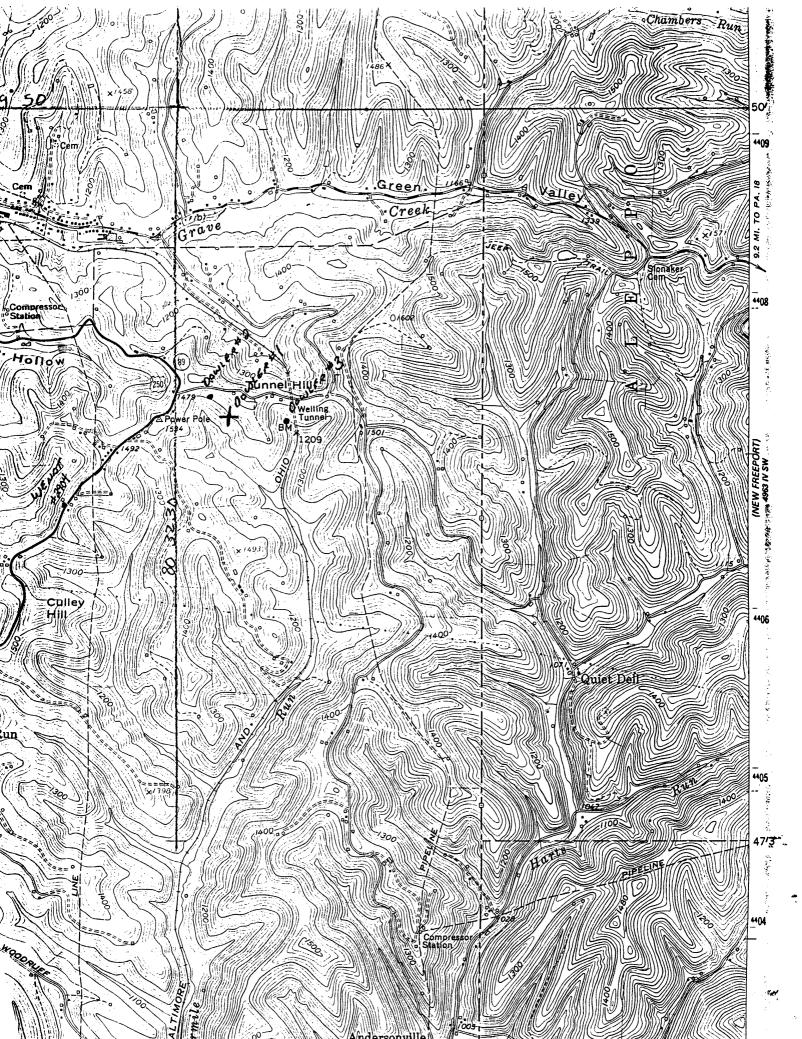

Hearty District, Marshall County, W. Va.

By Cameron Heat & Light Co. (MNV-16).

Well was drilled in 1904 by Wheeling Nat. Gas Co.

Leased in 1915.

Conductor, 12*; 13* casing, 60*; 10*, 1325* (925* left in well);

65*, 2045*.

Well was shot with 120 qts. nitroglycerine in 50-Ft. Sand.

Well was shot with 20 qts. nitroglycerine in Wourth Sand.

All casing pulled but 925* of 10* casing.

2* tubing, 3300*.

Record from Mr. Straub 9-11-39.

Elevation. /3 +5

	Top. Bottom.
Mountain Sand	525 - 565
Mapletewn (Sewickley) Coal	825 -
Pittsburgh Coal	915
Murphy Sand	1000 - 1010
Little Dukkard Sand	1325 - 1360
Big Dunkard Sand	1475 - 1515
Gas Sand	1500
Salt Sand	1760 - 1870
Big Lime	2030 - 2100
Big Injun Sand	2100 - 2355
Thirty-foot/Sand	2704 - 2731
Fifty-foot Sand (a little gas)	2883 - 2910
Gordon Stray Sand	2915 - ••••
Gerdon Sand	2948 - 2991
Fourth Sand	<i>3</i> 016
Fifth Sand	3138 - shell
Limestone and shells	3348 - • • • •
Total depth	3380

W. A. (J.J.) DOWLER No. 1 We

Liberty

DISTRICT, MARSHALL COUNTY, W. VA.

By Cameron Heat & Light Co. Total depth 3380 Elevation 1345 (Drilled by Wheeling Natural Gas Co.)

	Completed 1904		Abandoned			Production			
	Sand.	Тор.	Bottom.	Thick- ness.	Eleva- tion.	Interv Pgh. C.	als from B. I. Sand		ick-
	Pittsburgh Coal Min shall Murphy	915 1000	1040	j 1 0	430 345	0 85	1185 1100		
	Moundsville	, ;							
	1 C. R., Lit. Dunk.	1325	1360	35	20	410 560 685 845	775		
	Big Dunkard						<u></u>		
	Burning Springs	1475	1515	40	-130	560	625	,	
*v 4	Gas	. :				% 			
	Lower Gas	1600	••••	••	255	68 5	500		
*.	Second Cow Run	• • • • •				X			
	1st Salt	1760	1870	90	41 5 ′	845	340		
	2nd Salt	****				*			
	3rd Salt	1				2			
	Maxton	· · · .							
1.	Big Lime	2030	2100	70	685	1115	70		
	Keener	ţ							
	Big Injun	2100	2355	2 55	7 55	1185	0		
	Berea	2704	2731	27	13 59	1789	604		
	Gantz	. 1	***						
	50-Foot					Š			
	30-Foot	2883	2910	3 7	1538	1968	783	little ga	.8
	Gordon Stray	29 1 5	••••		1570	2000	815		-
	Gordon	2948	2991	43		2033	8,148		
	Fourth	3016	••••		1671	2101	916	gas	
	Fifth shell	3138	• • • •	••	1793	2223	1038		
	Sixth Im. shell	Ls 3248	4444		1903	2333	1148		
	Speechley	- J= •-				-,,,,			

J.J. DOWLER WELL PLA

Diberty District, Marshall County, W. Va. well was drilled in by Wheeling Natural Gas Company 1904.

Condustor 18 feet

Houstoin Sand 685 565
Espletown Coal 625
Pittsburg Coal 915Rurphy Sand 1000-1040
Little Dunkard 1385-1515
Cas Sand 1600
Selt Sand 1760-1970
Big Line 8660-8100
Sig Injun 8106-8568
Thirty Foot 8764-8761
Fifty Poot 8948-8991
Fourth Sand (shell) 2588
Fotal Topth 8546
Fotal Topth 8546

Well shot 120 que nitre glycerin in Fifty foot sand

Shot with 20 qts in Fourth Sant

15 inch casing 60 feet 10 inch casing 1525 feet 6-5/5" casing 2045 feet

All eneing was pulled out but DAS foot 10 inch

State Class on 176

Foreman

Vell. District Scounty, State, and, where possible, a gener

NATE LACT DEDADT

This following list is a record of wells drilling in my district with full record of same

OREGOR-CUTLER PRINTING CO.		aden estan cala las			drilling in my district with full record of	esed as as
DEPTH .	TARM	WELL NO.	TOWNSHIP DISTRICT	COUNTY	DEMARKS	THI
					ty Dist Marshall Go. W.V.	ب.
Cond	uctor	ノア /	70-9.	1011-11.	Tra. Nat Gasco.	
13' C	ising		Consultation of the second	60		
	n Sond			565 825		
Pittsb	own Cool			1.	920	
Murph	ig Sand			1040		
101/10	[전문] 하면 있는 경영 중에 가장 하는 것 같아 그는 것은 것이다. 그는 것 같아 그 것 같아 그는 것 같아.			1325	Programme and the second secon	
and the second of the second o	Dunkard San Dunkard San	Lare Market Contract	2.30	136a 1515		
Gas	Sand,		1600	1 1 1 1 1 1 1 1 1 1 1 1 1 1 1 1 1 1 1		
一一一大大 上海 的复数数计算	Sand			1870	1 1 1 1 1 1 1 1 1 1 1 1 1 1 1 1 1 1 1	
	ime asing		A CONTRACTOR OF THE PARTY OF TH	2100	2051.11	
Big In	njum sand	1	The second secon	2355		
30 1 State 2011	foot		· · · · · · · · · · · · · · · · · · ·	2737		
Fifty	foot on Stroy		2883 2915	2910 T	4 3 4 5 4 5 1 V	
Gordo	n sand		2948	2991		
Fourt	1		30.16	24 V 24 C 2 C 2 C 2 C 2 C 2 C 2 C 2 C 2 C 2		
Fifth_ Lime	stone +3hell	5//]3138 3348	17.		
	34/			अवदर्ध		
n 11	- L - 4/		1 2	,		
rrell.	shot mith	200	uay 1.5,	n so i	Insund.	
71/c	asing Pulle	d. Bu	t=928	fto	10' casing:	
	and the second of the second o					
90	AL DEPTH	940				
S.	NE 4th 1 3054 -	6".		The state of the s	The state of the s	
			#///Z	ASU	TENT- WX "	7.0
Col	and out				The state of the s	
な。	and ont 3058'-6/2	0/40	1. 36			
				<u>- 1</u>		
2. 3111	Justing sin	un	m D.		। ४७ - : : : : : : : : : : : : : : : : : :	
Wa	65/2-16'ne el parker		AMA-	in companies in		
Ba	eper set to	tom	4.13	7 277	mat.	
-Very	oratio from	1 5 CA	If		hyjst fu 2" tubry)	
Star	ted clean out	por-	1431	-6/4	hy for fun 2 lubis)	ore
This R	그리고 그 그렇게 그 않다. 그 살아가는 하는 그 살아 살아 들어 되었다. 그 생각이 되었다.	Saturday.	The state of the s	of the second se	mber of Well, District, County, State, and, where possible	e, a

report of field operations of other companies.

1. E. Beille & Parky Inguin

60. Conducts 13" Crains 5-25-5-65 Mountay Sand 825 Maplelous los 915 Pittsburgh Eval -Murphy Sand - -1325 10" Casing 925 ffm Lel 1325'_/360' L. Dunkard 1475 /515 1600. 1760-1870 You Sand 2030-2100 Sult Big Line 65/ leany 2100-2355 18t 2704-2731 Buy Engine 30 ft. 2883-2910. Lay 2948-2991 Gordon 4th Sand --5-th " Lime Stone skills Total Depth

STATE OF WEST VIRGINIA DIVISION OF ENVIRONMENTAL PROTECTION SECTION OF OIL AND GAS

WELL REGISTER ASSIGNMENT

This API Number 47-51-00745, issued to CAMERON GAS COMPANY is evidence of permission to operate the well that is referenced at the location described on the attached plat, subject to the provisions of Chapters 22 and 22B of the West Virginia Code of 1931, as amended, and all rules and regulations promulgated thereunder. The name and telephone number of the Oil and Gas Inspector for this well is RANDAL MICK - 304-986-3324.

Spills or emergency discharges must be reported to 1-800-654-3312.

Failure to abide by all statutory and regulatory provisions governing all duties and operations hereunder may result in suspension or revocation of your permits and in addition may result in civil and/or criminal penalties.

The enclosed WR-35 must be completed by you and returned to this office. In addition annual production reports must be submitted on this well and failure to do so may require you to plug the well.

Theodore M. Streit Chief

By: 111 - 16

Title:	

Operator's Well No: J.J. DOWLER #1

Farm Name: BROWN, HARMAN

API Well Number: 47- 51-00745 N

Date Issued : 07/09/93