

INSTRUCTIONS

1) Attach a photo copy of the location of the well on a 7.5 minute Quadrangle with the corresponding Longitude and Latitude.  
 2) Designate the location of the well with the symbol(+).


11650

39°47'30"

LATITUDE 39°46'39"

80°35'00"

80°32'30"

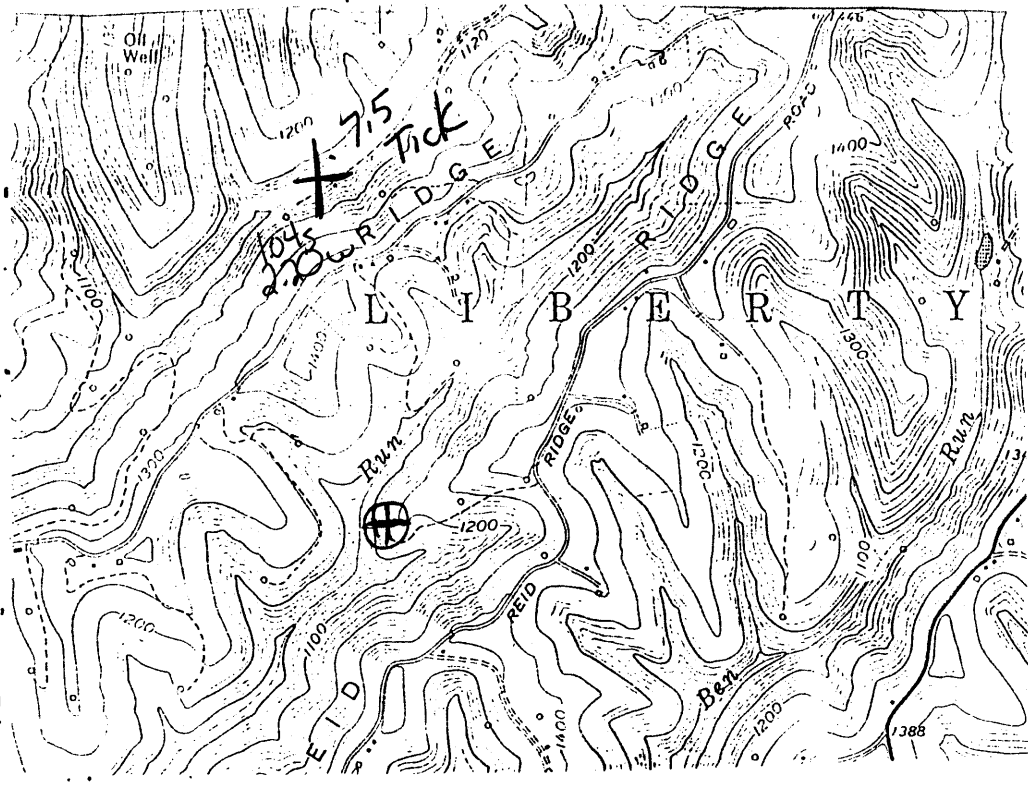

LONGITUDE 80°35'00"

0.985  
0.01W

5150

I, the undersigned, hereby certify that this plat is correct to the best of my knowledge and belief.

SIGNED C. D. Ad  
 TITLE VICE-PRESIDENT

16984

DATE MARCH 15, 1993  
 OPERATORS WELL NO. 3046  
 API WELL NO. 051--0801-N

Cameron SE  
 3,86 S  
 2,21 W

STATE OF WEST VIRGINIA  
 DEPARTMENT OF ENERGY  
 OIL AND GAS DIVISION

WELL TYPE: OIL  GAS  LIQUID INJECTION  WASTE DISPOSAL   
 (IE "GAS" PRODUCTION  STORAGE  DEEP  SHALLOW

LOCATION: ELEVATION 1165 WATER SHED FISH CREEK  
 DISTRICT LIBERTY COUNTY MARSHALL  
 QUADRANGLE CAMERON

SURFACE OWNER F. QUIGLEY ACREAGE \_\_\_\_\_  
 OIL & GAS ROYALTY OWNER \_\_\_\_\_ LEASE ACREAGE \_\_\_\_\_  
 LEASE NO. \_\_\_\_\_

PRODUCING FORMATION GORDON + 4th SAND TOTAL DEPTH 2908

WELL OPERATOR CHELSEA OIL & GAS CO. INC DESIGNATED AGENT AL ANDERSON

ADDRESS Box 1145 ADDRESS 901 W. MAIN ST  
BRIDGEPORT WV 26330 BRIDGEPORT WV 26330

66

024

F. QUIGLEY NO. 3046 WELL.

Liberty District, Marshall County, W. Va.  
By Manufacturers Light & Heat Co.  
Completed Dec. 24, 1925.  
Record from Mr. Schillhahn Sept. 30, 1939.

↳ 801

	Top.	Bottom.
Pittsburgh Coal	820	- 827
Little Dunkard Sand	1236	- 1265
Big Dunkard Sand	1295	- 1345
Gas Sand	1500	- 1550
1st Salt Sand	1600	- 1620
2nd Salt Sand	1720	- 1745
3rd Salt Sand	1815	- 1835
Maxton Sand	1890	- 1935
Big Injun Sand (water, 2050')	1960	- 2250
30-Foot Sand	2550	- 2610
50-Foot Sand	2785	- 2795
Gordon Sand (gas, 2842')	2842	- 2877
4th Sand (gas, 2904-2908')	2892	- 2908
Total depth		2908

STATE OF WEST VIRGINIA  
DIVISION OF ENVIRONMENTAL PROTECTION  
SECTION OF OIL AND GAS

WELL REGISTER ASSIGNMENT

This API Number 47- 51-00801, issued to CHELSEA OIL & GAS, INC is evidence of permission to operate the well that is referenced at the location described on the attached plat, subject to the provisions of Chapters 22 and 22B of the West Virginia Code of 1931, as amended, and all rules and regulations promulgated thereunder. The name and telephone number of the Oil and Gas Inspector for this well is RANDAL MICK -  
304-986-3324.

Spills or emergency discharges must be reported to 1-800-654-3312.

Failure to abide by all statutory and regulatory provisions governing all duties and operations hereunder may result in suspension or revocation of your permits and in addition may result in civil and/or criminal penalties.

The enclosed WR-35 must be completed by you and returned to this office. In addition annual production reports must be submitted on this well and failure to do so may require you to plug the well.

Theodore M. Streit  
Chief

By:   
\_\_\_\_\_

Title: \_\_\_\_\_

Operator's Well No: 3046

Farm Name: QUIGLEY, F.

API Well Number : 47- 51-00801 N

Date Issued : 01/27/94

70126