


LATITUDE 39° 47' 30"

4100'

LONGITUDE 80° 42' 30"

2.745
0.78w

20754

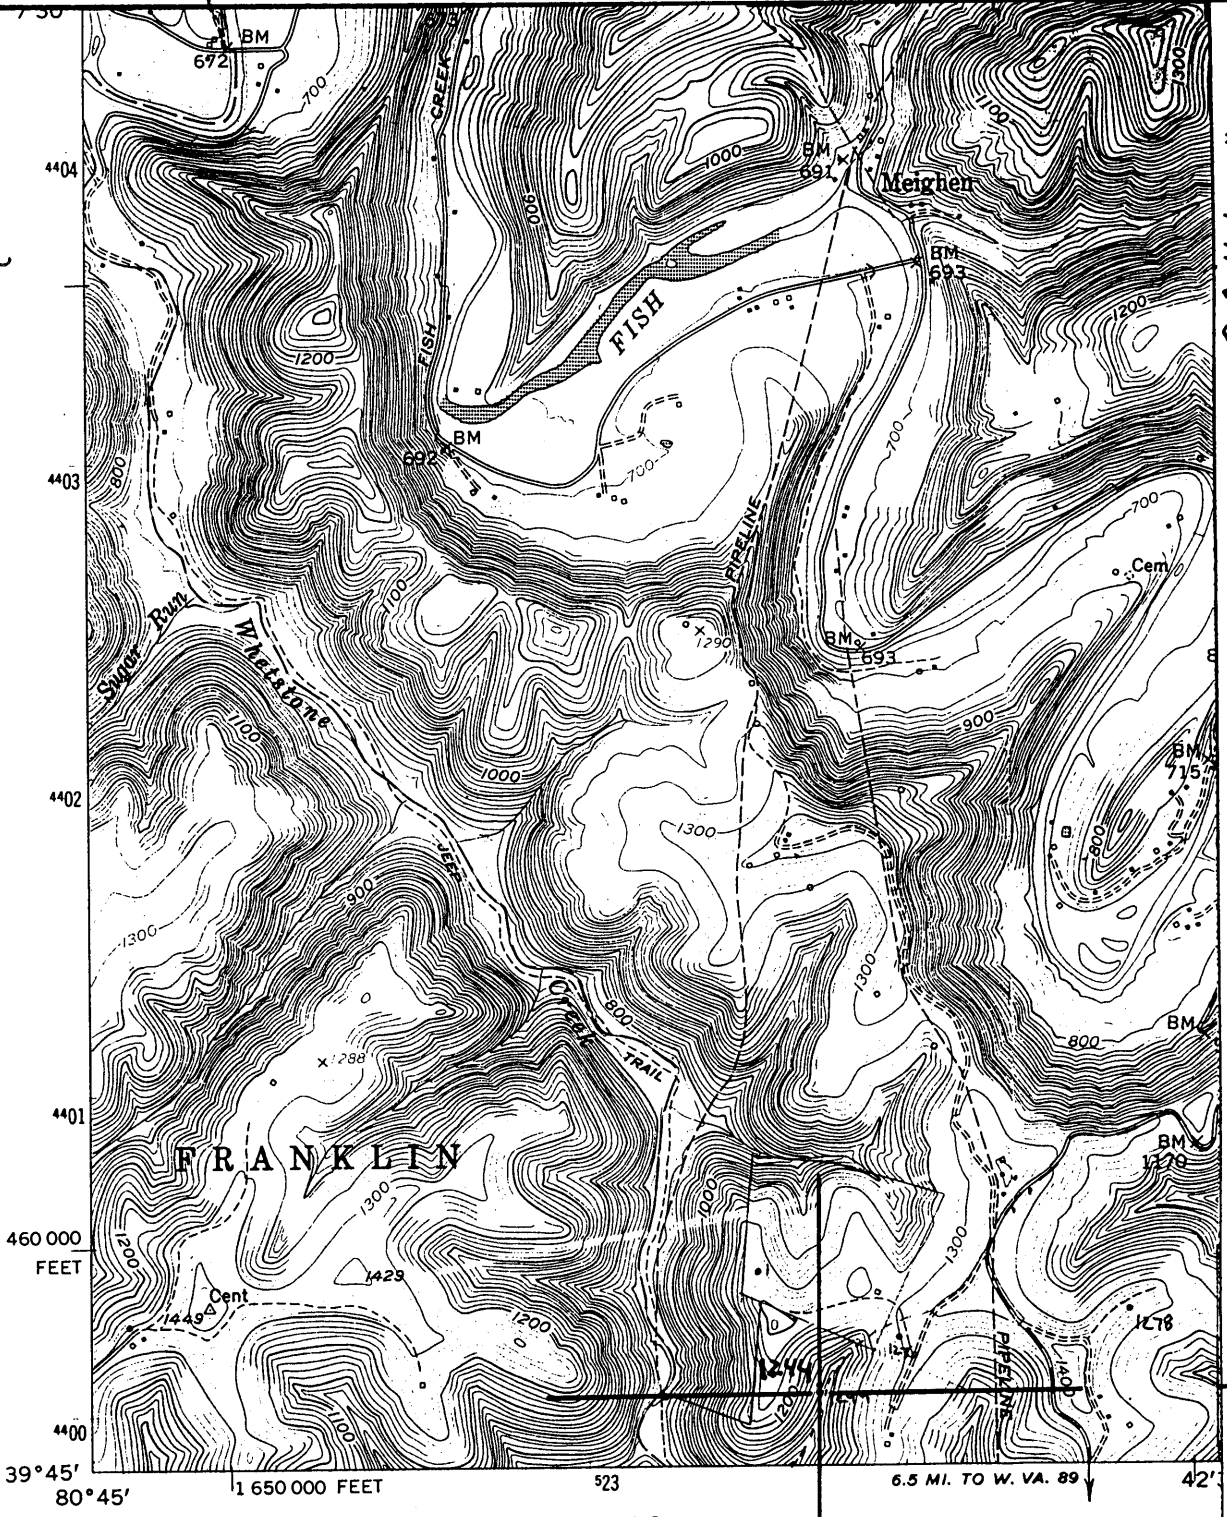

Mapped, edited, and published by the Geological Survey
Control by USGS and USGS/CG

I THE UNDERSIGNED, HEREBY CERTIFY THAT THIS PLAT IS CORRECT TO THE BEST OF MY KNOWLEDGE AND BELIEF.

SIGNED _____
TITLE Deryl Perkins - VICE PRESIDENT

STATE OF WEST VIRGINIA
DIVISION OF ENVIRONMENTAL PROTECTION
OFFICE OF OIL AND GAS

DATE March 27, 19 95
FARM James Messey NO. 1244
API WELL NO. 47-051-0826-N

WELL TYPE: OIL _____ GAS X LIQUID INJECTION _____ WASTE DISPOSAL _____
(IF "GAS") PRODUCTION X STORAGE _____ DEEP _____ SHALLOW X
LOCATION: ELEVATION 1100' Topo WATERSHED Whetstone Creek
DISTRICT Meade COUNTY Marshall
QUADRANGLE Glen Easton 370

was 70771

RECEIVED
Environmental Protection
JUN 19 1995
Permitting
Office of Oil & Gas

SURFACE OWNER Unknown
OIL & GAS ROYALTY OWNER Unknown
LEASE NO. _____

ACREAGE ?
LEASE ACREAGE 200 Ac.

PRODUCING FORMATION _____
WELL OPERATOR Perkins Oil & Gas DESIGNATED AGENT Deryl Perkins
ADDRESS P.O. Box 547 ADDRESS P.O. Box 547
Pennsboro, West Virginia 26415

TOTAL DEPTH _____
Pennsboro, West Virginia 26415

STATE OF WEST VIRGINIA
DIVISION OF ENVIRONMENTAL PROTECTION
SECTION OF OIL AND GAS

WELL REGISTER ASSIGNMENT

This API Number 47- 51-00826, issued to PERKINS OIL & GAS, INC. is evidence of permission to operate the well that is referenced at the location described on the attached plat, subject to the provisions of Chapters 22 and 22B of the West Virginia Code of 1931, as amended, and all rules and regulations promulgated thereunder. The name and telephone number of the Oil and Gas Inspector for this well is RANDAL MICK -
304-759-0579.

Spills or emergency discharges must be reported to 1-800-654-3312.

Failure to abide by all statutory and regulatory provisions governing all duties and operations hereunder may result in suspension or revocation of your permits and in addition may result in civil and/or criminal penalties.

The enclosed WR-35 must be completed by you and returned to this office. In addition annual production reports must be submitted on this well and failure to do so may require you to plug the well.

Theodore M. Streit
Chief

By: 

Title: _____

Operator's Well No: MESSEY #1244

Farm Name: MESSEY, JAMES

API Well Number : 47- 51-00826 N

Date Issued : 07/24/95

051 70771