Latitude

1.625 1.26w

Longitude

Topo Location

7.5' Loc	15' Loc
	(calc.)

Company I H Beam

Farm DA Jones #1

15' Quad _____ (sec.)


7.5' Quad Dom Eastern


District Meado

WELL LOCATION PLAT

County os Permit 30098

mow: 051 €33

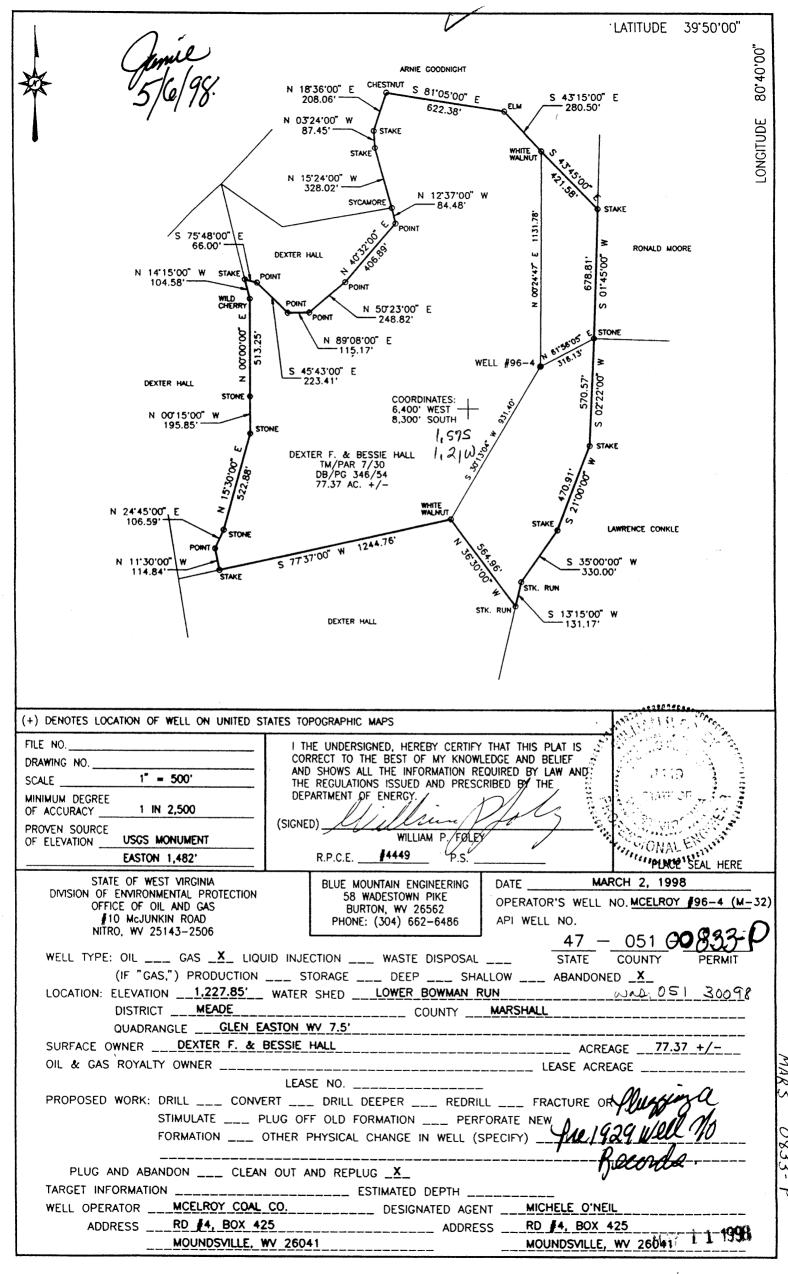

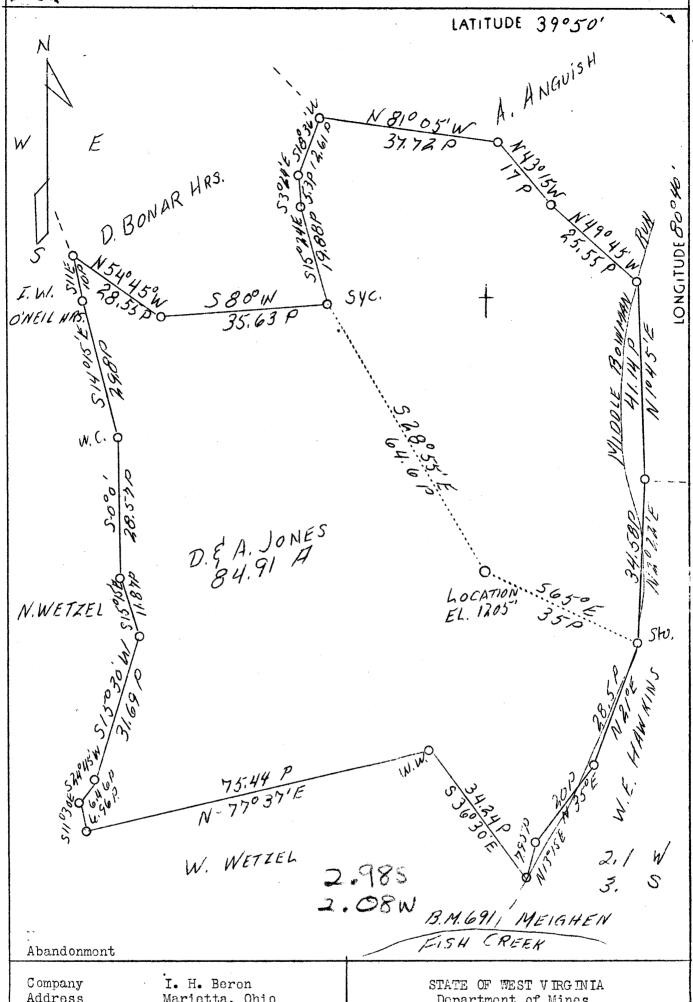

Address Marietta, Ohio Farm D. & A. Jones Tract Acres 84.91 Well (Farm) No. One Flevation (SL) 1205 Quadrangle Cameron S. W. County Marshall District Moado Engineer F. W. Parsons

Eng. Reg. No.

Date Scale 203 May 2, 1939 1" - 20 poles STATE OF WEST VIRGINIA
Department of Mines
OIL & GAS DIVISION
Charleston

WELL LOCATION MAP

Filo No. Mars - 98-17

x Denotes location of well on U. S. Topographic Maps, scale 1 to 62,500, latitude and longitude lines being represented by border lines as shown.

- Denotes one inch spaces on border line of original tracing.

STATE OF WEST VIRGINIA

DEPARTMENT OF MINES

OIL AND GAS DIVISION



WELL RECORD

Permit No. MARS - 98 - A - 83 3

Company		Casing and Tubing	Used in Drilling	Left in Well	Packers		
Farm Daniel Jones	Acres 100						
ocation (waters)		Size					
Well No. 142		16			Kind of Packer		
District		13	110*		Disk Wall		
The surface of tract is owned in fee by		10		3951	Size of 6-5/8" X		
Address P		8¼	25 1 1 1 1 1 1 1	904*	5-3/16"		
fineral rights are owned by Daniel J		6 5/8		22051	Depth set 23101		
Address P		5 3/16			Sopon Scome		
Orilling commenced.	· · ·	3			Perf. top		
Orilling completed		2		29651	Perf. bottom		
Date shotDepth		l l			Perf. top		
Open Flow /10ths Water in		1			Perf. bottom		
/10ths Merc. in		1					
Volume			ENTED	SIZE	No. FTDa		
cock Pressurelbs							
il			NCOUNTERF	ED AT. 835	FEET		
resh water feet feet					FEETINCHE		
Salt waterfeet		· · · · · ·					
Hard o			Oil Gas	Depth			

Salt water		feet	feet	FEE	TINCH	ESFEE	TINCHE
Formation	Color	Hard or Soft	Тор	Bottom	Oil Gas or Water	Depth Found	Remarks
Sapletown Coe Pittsburgh Co Pittle Dunkard Balt Sand Balt Sand Balt Sand Big Lime Big Injun Sand Bordon Sand	el d		835 925 1245 1325 1595 1745 2005 2050 2930	840 930 1280 \$445 1636 1760 2050 2320 2960 2978			
						0x	(Jerges)
			·			\ 3	

2833

Neade District, Harshall County, W. Va.
Nanufacturers Light & Heat Co.
Elevation, 1230' B.
Begun July 18, 1907; completed, Sept. 22, 1907.
Shot Oct. 18, 1907, with bo qts.
Conductor, 14: 13" casing, 110: 10", 1250'; 81", 1860';
6-5/8", 2205'; 2" tubing, 2978'.

	Top. Bottomb.
Mapletown Coal	8h5 - 850
Pitteburgh Coal	935 - 940
Big Dunkard Pand (Moundeville)	1255 - 1275
Little Dunkard Sand	1435 - 1470
Gas Sand	1192 - 1567
Salt Sand	1675 - 1715
Salt Sand (no water in Salt Sand)	1835 - 1855
Big Line	2015 - 2060
Big Injun Sand	2060 - 2330
Berea Sand	2655 2663
Red rock	2770 - 2850
Black slate	2850 - 2930
Gordon Sand (oil in top of sand; a new	26
small showing before shot)	2910 - 2952
Intal depth	2978

STATE OF WEST VIRGINIA DEPARTMENT OF ENERGY OIL AND GAS WELLS DIVISION

AFFIDAVIT OF PLUGGING AND FILLING WELL

AFFIDAVIT SHOULD BE MADE IN TRIPLICATE, one copy mailed to the Division, one copy to be retained by the Well Operator and the third copy (and extra copies if required) should be mailed to each coal operator at their respective addresses.

MCELROY COAL COMPANY		E	ECELROY COAL COMPANY			
Coal Operator or Owner			Name of Well Operator			
RD #4, BOX 425, MOUNDSVILLE, V	<u>// 26041 </u>	R	D #4, BOX 425, MOU			
Address MCELBOY COAL COMPANY				ete Address		
MCELROY COAL COMPANY Coal Operator or Owne		<u>8-</u>	<u>8-15-98</u> 19			
RD #4, BOX 425, MOUNDSVILLE, V		8.4		LOCATION		
Address	777 20041	IVI	EADE	strict		
DEXTER F. & BESSIE HALL		M	ARSHALL	SUICU		
Lease or Property Own	ner	171		unty	***	
RD #1, BOX 74, GLEN EASTON, W	/V 26039	#9	96-4 (M-32)	, and y		
Address				LL NO.		
		<u>D</u>	EXTER F. & BESSIE	HALL		
STATE INSPECTOR SUPERVISING	G PI UGGING		F/	ARM		
				<u> </u>		
	AFFII	DAVIT		United		
OTATE OF MEST MINISTER						
STATE OF WEST VIRIGINIA,				1:07 0		
County of UPSHUR	_ ss:					
GEORGE R. GORE	and	D	ONALD HATELELD			
being first duly sworn according t		Di Di	ONALD HATFIELD	ork of plugg	ing and	
filling oil and gas wells and were	employed by CONSOLIDATIO	N COAL	COMPANY	ark or plugg	ing and	
well operator, and participated in	the work of plugging and filling	ng the a	hove well that said	work was c	ommoncod	
on the 7TH day of	July 1998		and that the well was			
following manner:			and that the Well Wat	, plugged li	i tile	
Sand or Zone Record	Filling Material		Plugs Used	Casing	Casing	
				Pulled	Left In	
Formation			Size & Kind			
CLEANED HOLE WITH 10 5/8" BIT PLUG FROM 737' TO 833'. REDUC	10 835'. CLEANED OUT CEM	ENT	7"	123'	163'	
HOLE WITH 9 7/8" BIT TO 937'. RE	EDUCED HOLE TO 7 7/8" AND	CLEA	8 5/8"	368'	UNKNOWN	
HOLE WITH 7 7/8" BIT TO 1,836'. F	REDUCED HOLE TO 6 1/4" AND	D D	10 3/4"	378'	0	
CLEANED HOLE WITH 6 1/4" BIT T	O 2.124'. PULLED 123' OF 7" (CASING	· · · · · · · · · · · · · · · · · · ·	+	 	
PULLED 368' OF 8 5/8" CASING. P	PULLED 378' OF 10 3/4" CASING	G. CUT		-		
8 5/8" CASING REMAINING IN HOL	E AT 1,350' TO 1,550'. CEMEN	NTED H	OLE .			
FROM 2,124' BACK TO SURFACE S	SOLID USING 1,026 SACKS OF	F POZ				
MIX AND 208 SACKS OF THIXATRO	OPIC CEMENT. USED 2,000 G	SALLON	S			
OF MUD FLUSH. CEMENT DID CIP	RCULATE. MEEKS WIRELINE	RAN				
GAMMA RAY, CALIPER & BOND LO	OG, CONSOL COAL RAN DEVI	IATION				
AND CALIPER LOG. B. J SERVICE	ES CEMENTED WELL.			1/11		
SENT CEMENT PLUG FROM 2,100 CEMENT PLUG FROM 1,150' TO 75	10 1,150 WITH POZ MIX. SE	ENT	····	A/////	1.	
SENT CEMENT PLUG FROM 750' E	BACK TO SUBEACE WITH BO	INI.	OUD CEMENT DUILO	1 1/Many	11/10/98	
	TO SURFACE WITH POZ	Z IVIIXISC	JLID CEMENT PLUG	: 2,124	\ ` ` \	
Coal Seams			escription of Monum		J	
	936' TO 942'		OF 4 1/2" ENGRAVE		STATING:	
(Name) (Name)			CELROY COAL COM	PANY		
(Name)			ELL #96-4 (M-32)			
and that the work of plugging a	and filling poid well was some	PE	RMIT #47-051-0833-			
July 1998	ind mining said well was comp	letea on	the <u>22ND</u>	_ day of	Ī	
And further deponents saith no	·		Meorae X	<i>M</i> .		
appendito daliti ilo	· 		Day De Coil	WITT OF THE SERVICE O	<u> </u>	
			NUMBER OF HE	geld		
Sworn to and subscribed before m	ne this <u>15TH</u> day	of Au	igust 1998 , ,	-	`	
}		<u>, , , , , , , , , , , , , , , , , , , </u>	ha 11/1/			
	OFFICIAL SEAL	77	Thankette 111.	aton)		
- I Maria S	NOTARY PUBLIC	7	Notary	Public		
My commission expires:	J. Watterland House	Pe	rmit No.			
6-29-99	A 1. 50x 556	47	-051-0833-P			
My comm	Mt. Clero, WV 26408 hission expires June 29, 1999	_		· · · · · · · · · · · · · · · · · · ·		
· · · · · · · · · · · · · · · · · · ·						

MARS 0833-+

NOV 1 6 1998