

WW-7
8-30-06



West Virginia Department of Environmental Protection
Office of Oil and Gas
WELL LOCATION FORM: GPS

API: 4705100860 WELL NO.: 1-2N
 FARM NAME: Okey L. Rine
 RESPONSIBLE PARTY NAME: CNX
 COUNTY: Marshall DISTRICT: Washington
 QUADRANGLE: Moundsville
 SURFACE OWNER: RINE OKEY L JR
 ROYALTY OWNER: RINE OKEY L JR
 UTM GPS NORTHING: 4417683.17
 UTM GPS EASTING: 526774.06 GPS ELEVATION: 1228.20

The Responsible Party named above has chosen to submit GPS coordinates in lieu of preparing a new well location plat for a plugging permit or assigned API number on the above well. The Office of Oil and Gas will not accept GPS coordinates that do not meet the following requirements:

1. Datum: NAD 1983, Zone: 17 North, Coordinate Units: meters, Altitude: height above mean sea level (MSL) – meters.
2. Accuracy to Datum – 3.05 meters
3. Data Collection Method:

Survey grade GPS : Post Processed Differential _____


Real-Time Differential _____

Mapping Grade GPS _____ : Post Processed Differential _____

Real-Time Differential _____

4. **Letter size copy of the topography map showing the well location.**

I the undersigned, hereby certify this data is correct to the best of my knowledge and belief and shows all the information required by law and the regulations issued and prescribed by the Office of Oil and Gas.

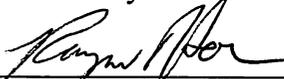
Signature

Project MANAGER
Title


12-3-20
Date

RECEIVED
Office of Oil and Gas

DEC 10 2020

WV Department of
Environmental Protection

03/19/2021

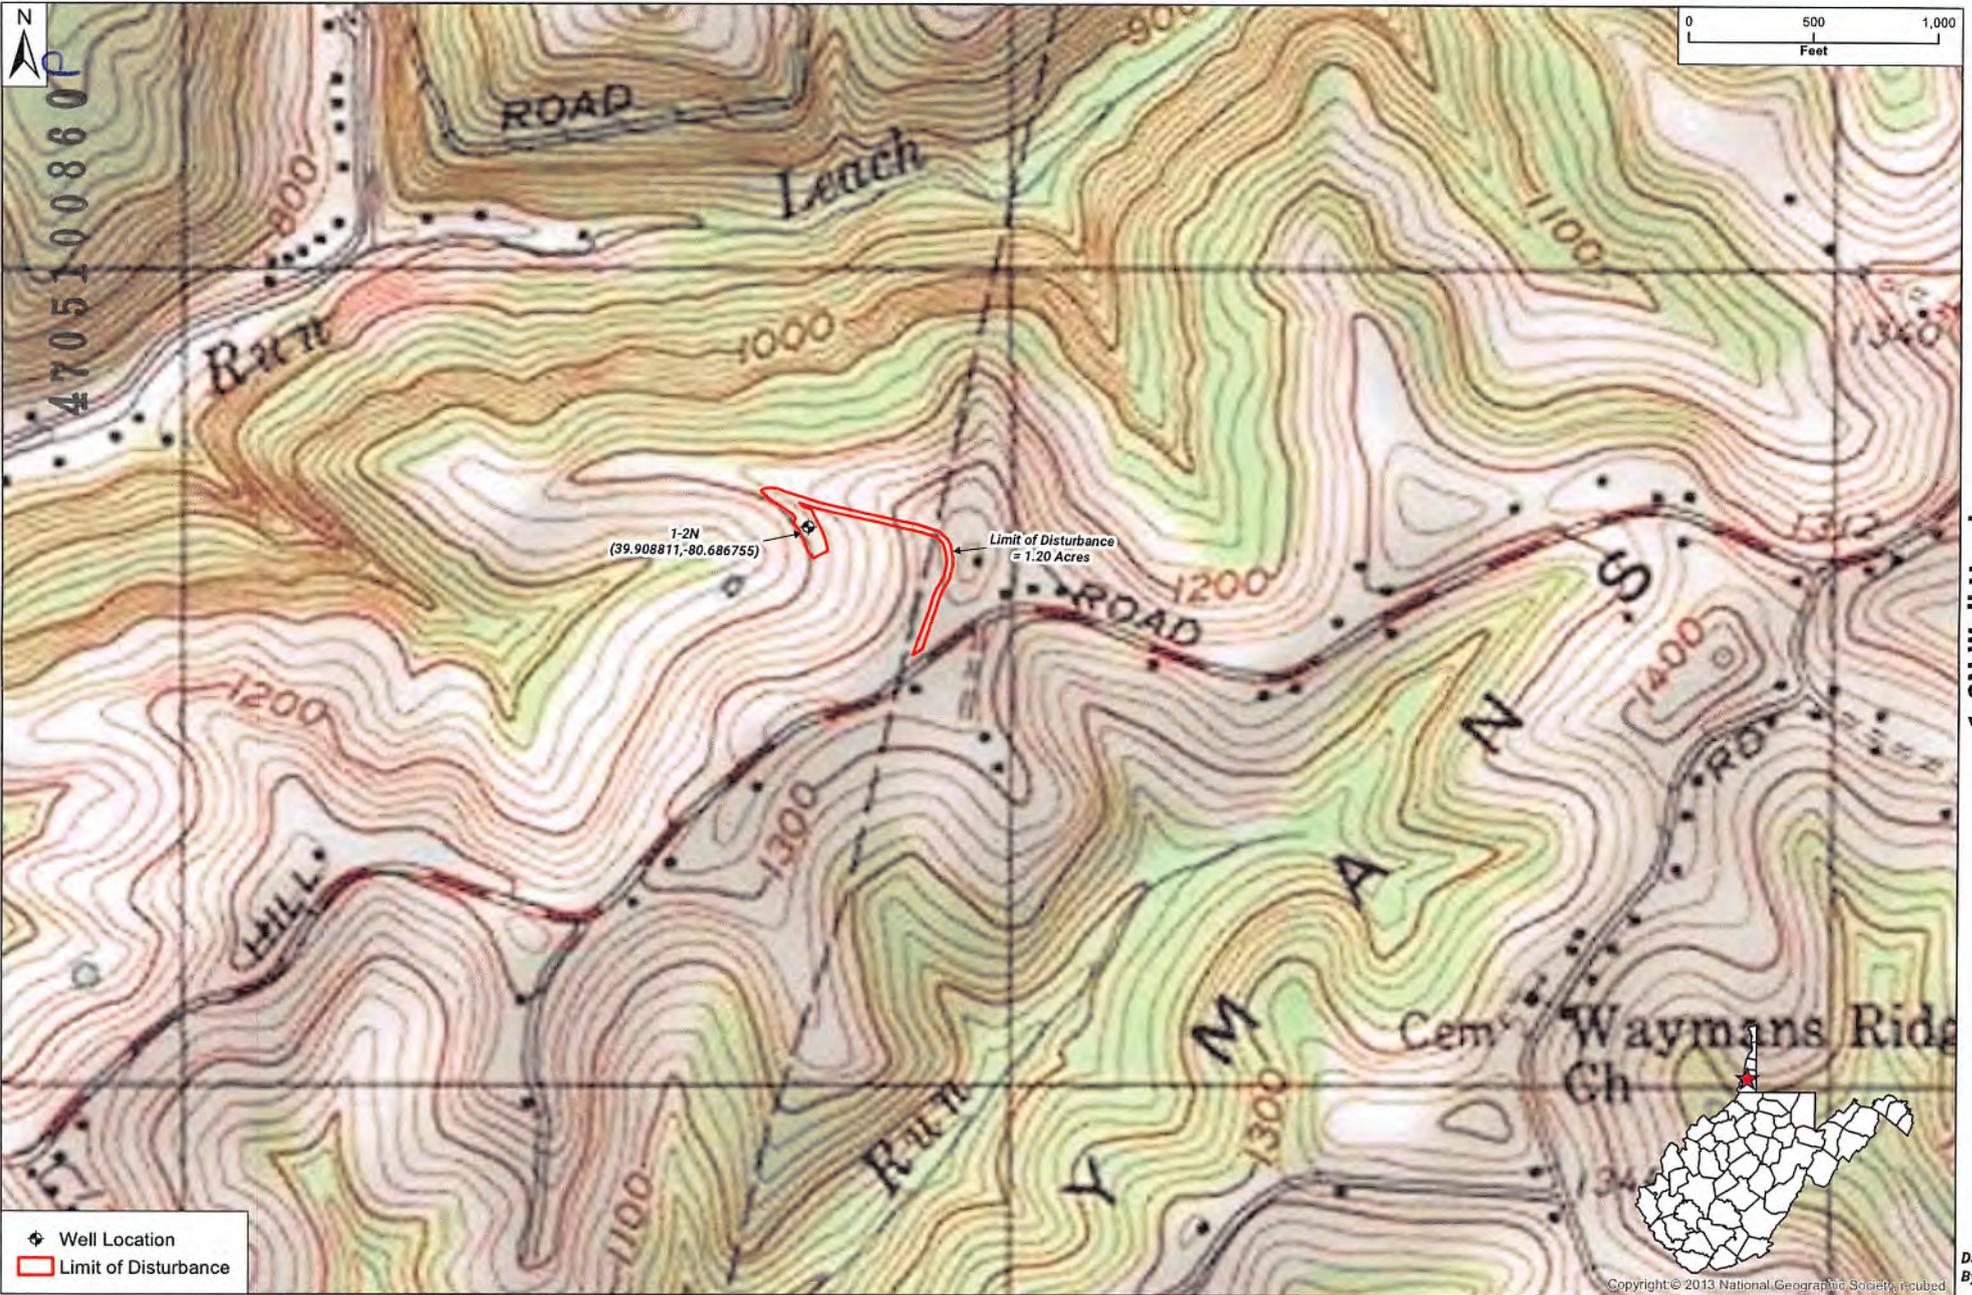

4705100860P

1-2N
(39.908811, -80.686755)

Limit of Disturbance
= 1.20 Acres

-  Well Location
-  Limit of Disturbance

1-2N Well Head
Site Location Topographic Map
Marshall County, West Virginia



Date: 11/19/21
By: R. Kenner

Copyright © 2013 National Geographic Society, i-cubed