

(+) DENOTES LOCATION OF WELL
ON U.S.G.S. TOPOGRAPHIC MAP


LATITUDE

39 52 30

N 85° 45'

LONGITUDE

8857.3'

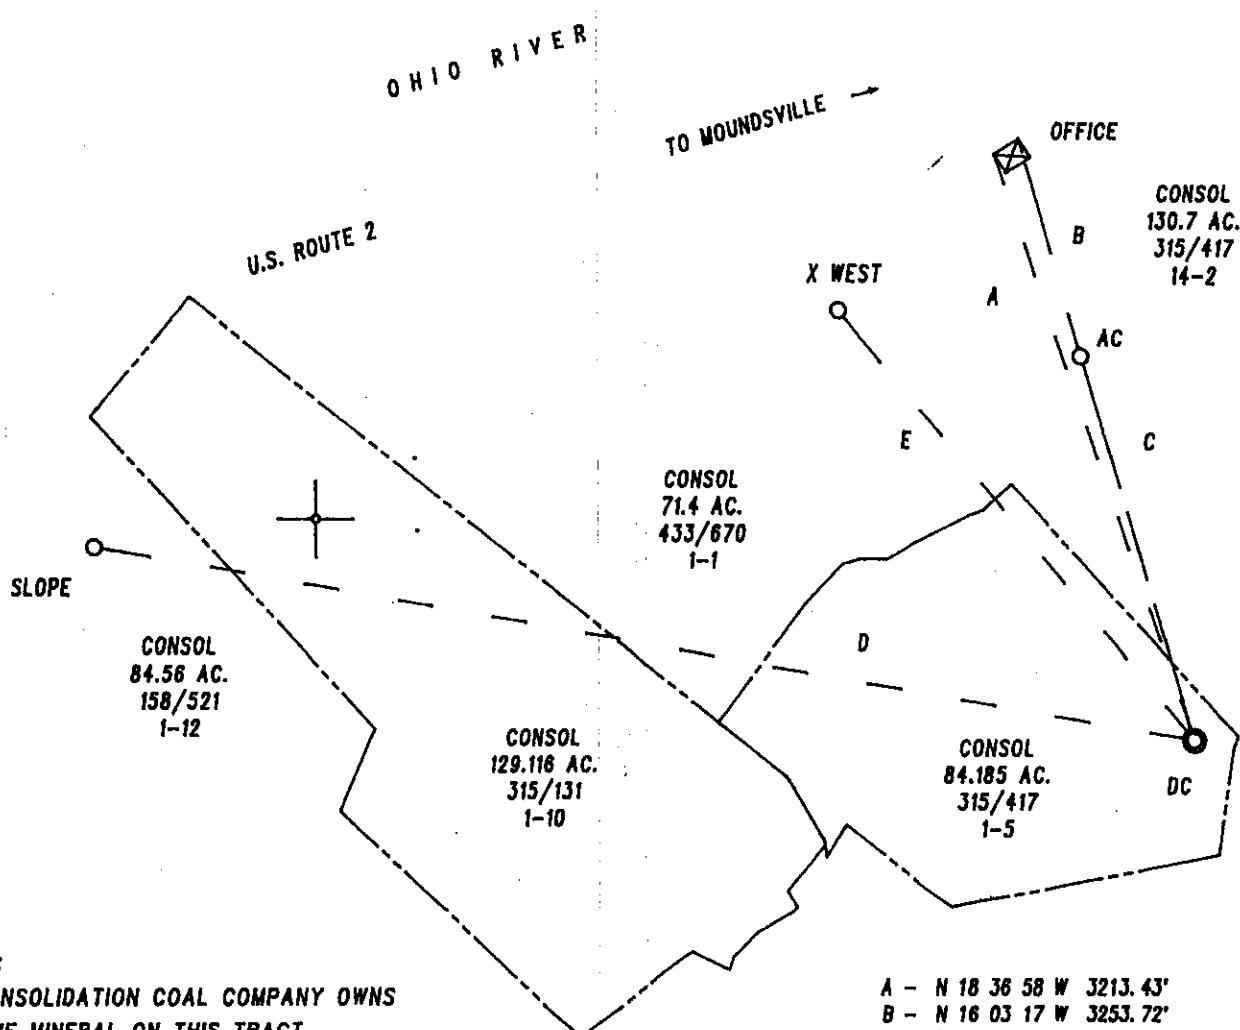


NOTE :

- 1) CONSOLIDATION COAL COMPANY OWNS THE MINERAL ON THIS TRACT.
- 2) THIS WELL IS AN EXISTING VENTILATION BOREHOLE BEING CONVERTED TO A CBM GOB WELL.

A - N 18 36 58 W 3213.43'
 B - N 16 03 17 W 3253.72'
 C - N 16 06 22 W 2086.42'
 D - N 80 03 27 W 5861.16'
 E - N 39 29 27 W 2903.00'

FILE NO.	02-IRE-04
DRAWN BY :	R.A. KITZMILLER
SCALE :	1 : 1000'
MIN. DEGREE OF ACCURACY	1 / 200'
PROVEN SOURCE OF ELEVATION :	GPS

I THE UNDERSIGNED, HEREBY CERTIFY THAT
THIS PLAT IS CORRECT TO THE BEST OF MY
KNOWLEDGE AND BELIEF AND SHOWS ALL THE
INFORMATION REQUIRED BY LAW AND THE REGU-
LATIONS ISSUED AND PRESCRIBED BY THE
DIVISION OF ENVIRONMENTAL PROTECTION.
(SIGNED) *Robert A. Kitzmiller*
Professional Surveyor No. 635

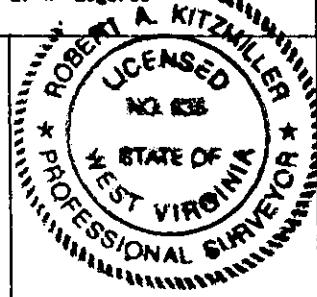

WV. DEPT. OF ENVIRONMENTAL PROTECTION
OFFICE OF OIL AND GAS DIVISION
1356 HANSFORD STREET
CHARLESTON, WV. 25301

DATE JUNE 19, 2002

OPERATOR'S WELL NO. DC

API WELL NO.

47 - 051 - 869C

STATE COUNTY

PERMIT NO.

WELL TYPE: OIL GAS CBM LIQUID INJECTION WASTE DISPOSAL

IF "GAS", PRODUCTION STORAGE DEEP SHALLOW

LOCATION: ELEVATION 680' WATERSHED HOG RUN OF THE OHIO RIVER

DISTRICT FRANKLIN COUNTY MARSHALL

QUADRANGLE POWHATAN POINT NEAREST TOWN MOUNDSVILLE

SURFACE OWNER CONSOLIDATION COAL COMPANY ACREAGE 84.185 AC.

OIL & GAS ROYALTY OWNER * See Note LEASE ACREAGE ---

01/16/2026

PROPOSED WORK: DRILL CONVERT DRILL DEEPER REDRILL FRACTURE OR STIMULATE

PLUG OFF OLD FORMATION PERFORATE NEW FORMATION

OTHER PHYSICAL CHANGE IN WELL (SPECIFY) EXISTING VENTILATION BOREHOLE BEING CONVERTED

PLUG AND ABANDON CLEAN OUT AND REPLUG TO GOB WELL.

TARGET FORMATION PITTSBURGH

ESTIMATED DEPTH

1162'

WELL OPERATOR CNX GAS COMPANY LLC. (NORTH)

DESIGNATED AGENT

EDWIN L. MERRIFIELD

ADDRESS 1800 WASHINGTON ROAD

ADDRESS

116 1/2 HUNSAKER STREET

PITTSBURGH, PA. 15421-1421

FAIRMONT, WV. 26554