


51-871C

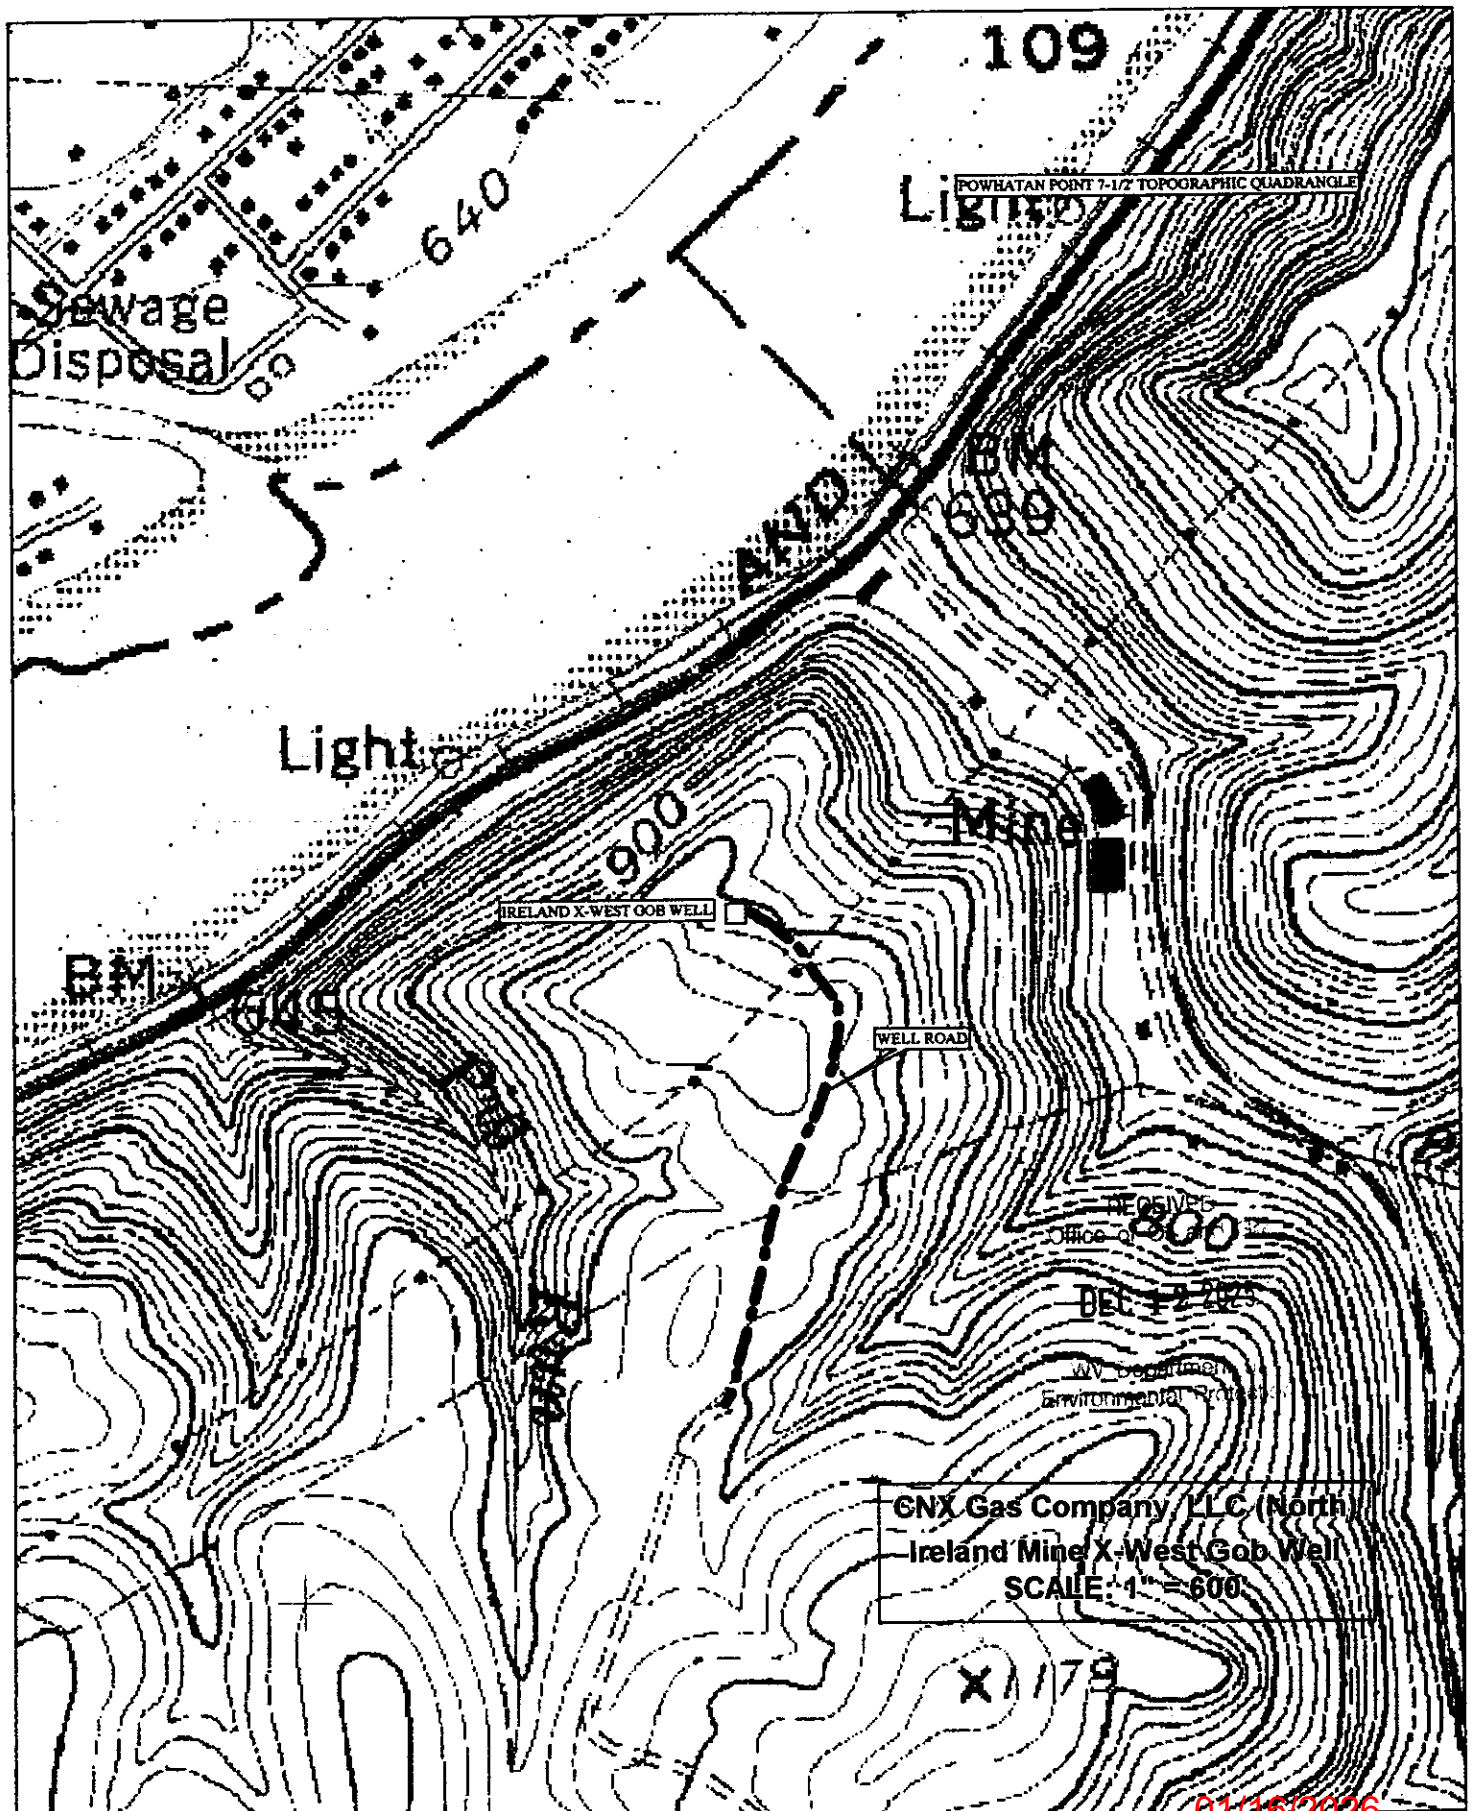


01/16/2026

(+) DENOTES LOCATION OF WELL
ON U.S.G.S. TOPOGRAPHIC MAP

LATITUDE 39° 52' 30"

N

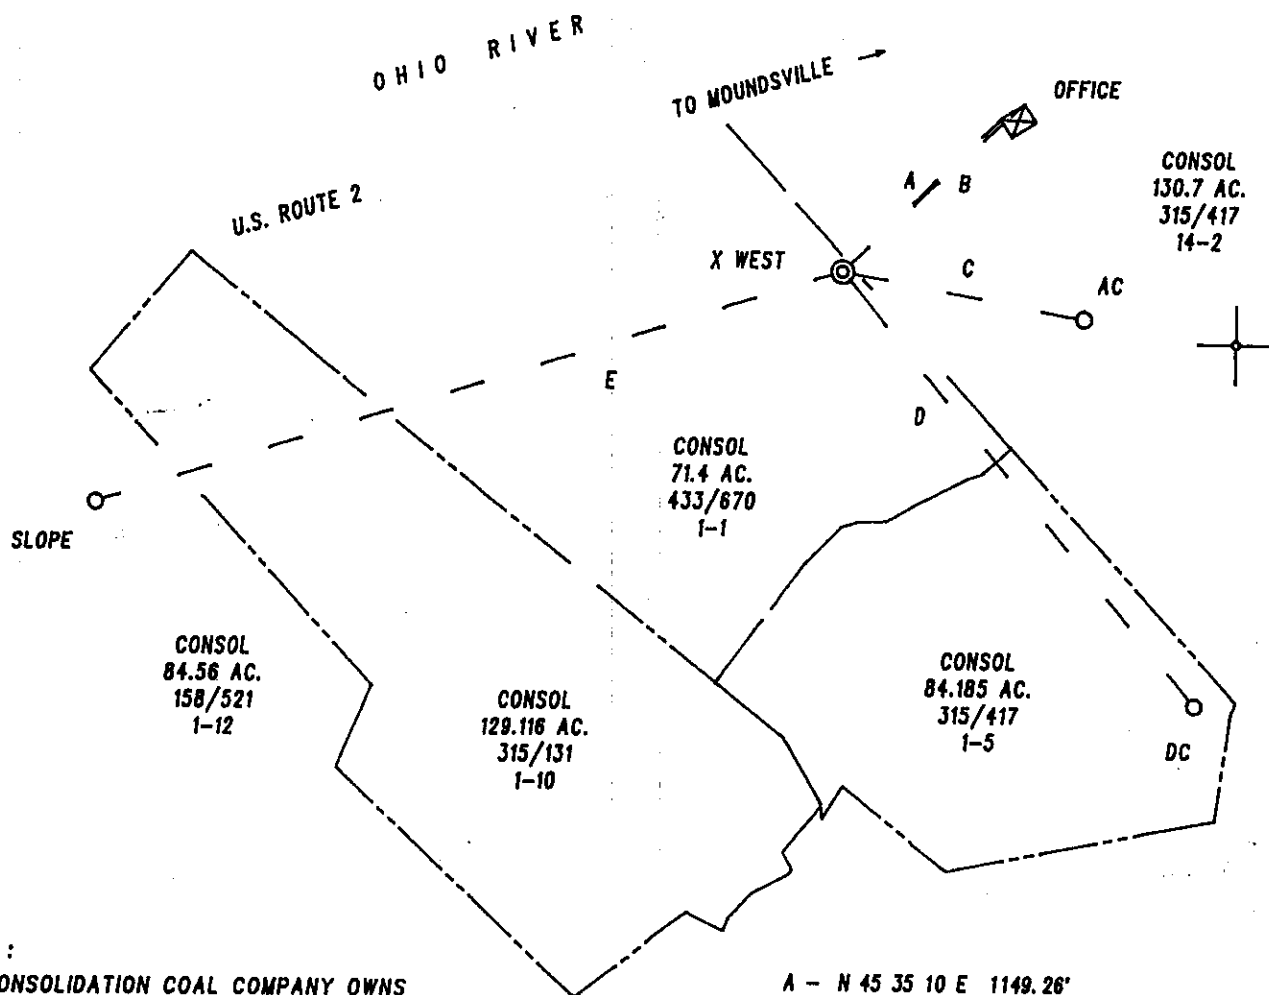

80 47' 30"

8845.3'

NOTE :


- 1) CONSOLIDATION COAL COMPANY OWNS THE MINERAL ON THIS TRACT.
- 2) THIS WELL IS AN EXISTING VENTILATION BORE-HOLE BEING CONVERTED TO A CBM GOB WELL.

A - N 45 35 10 E 1149.26'
B - N 46 54 32 E 1298.64'
C - S 79 26 06 E 1289.79'
D - S 39 29 27 E 2903.88'
E - S 72 37 09 W 4114.26'

FILE NO. 02-IRE-02
DRAWN BY : R.A. KITZMILLER
SCALE : 1 : 1000'
MIN. DEGREE OF ACCURACY 1 / 200'
PROVEN SOURCE OF ELEVATION :
GPS

I THE UNDERSIGNED, HEREBY CERTIFY THAT THIS PLAT IS CORRECT TO THE BEST OF MY KNOWLEDGE AND BELIEF AND SHOWS ALL THE INFORMATION REQUIRED BY LAW AND THE REGULATIONS ISSUED AND PRESCRIBED BY THE DIVISION OF ENVIRONMENTAL PROTECTION.

(SIGNED) Robert A. Kitzmiller
Professional Surveyor No. 635

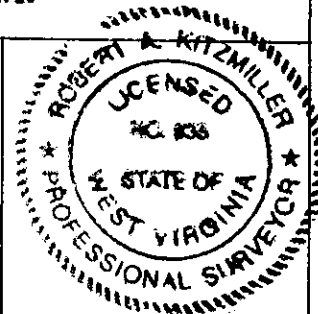

WV. DEPT. OF ENVIRONMENTAL PROTECTION
OFFICE OF OIL AND GAS DIVISION
1356 HANSFORD STREET
CHARLESTON, WV. 25301

DATE JUNE 19, 20 02

OPERATOR'S WELL NO. X WEST

API WELL NO.

47 - 051 - 871C
STATE COUNTY PERMIT NO.

WELL TYPE: OIL ☐ GAS ☐ CBM ☒ LIQUID INJECTION ☐ WASTE DISPOSAL ☐

IF "GAS", PRODUCTION ☒ STORAGE ☐ DEEP ☐ SHALLOW ☒

LOCATION: ELEVATION 1,005' WATERSHED HOG RUN OF THE OHIO RIVER

DISTRICT FRANKLIN

COUNTY MARSHALL

QUADRANGLE POWHATAN POINT

NEAREST TOWN MOUNDSVILLE

SURFACE OWNER CONSOLIDATION COAL COMPANY

ACREAGE 71.4 AC.

OIL & GAS ROYALTY OWNER * See Note

LEASE ACREAGE ---

LEASE NO. ---

PROPOSED WORK: DRILL ☐ CONVERT ☐ DRILL DEEPER ☐ REDRILL ☐ FRACTURE OR STIMULATE ☐
PLUG OFF OLD FORMATION ☐ PERFORATE NEW FORMATION ☐
OTHER PHYSICAL CHANGE IN WELL (SPECIFY) EXISTING VENTILATION BOREHOLE BEING CONVERTED
PLUG AND ABANDON CLEAN OUT AND REPLUG ☐ TO GOB WELL.

TARGET FORMATION PITTSBURGH

ESTIMATED DEPTH 1485'

WELL OPERATOR CNX GAS COMPANY LLC. (NORTH)

DESIGNATED AGENT EDWIN L. MERRIFIELD

ADDRESS 1800 WASHINGTON ROAD

ADDRESS 118 1/2 HUNSAKER STREET

PITTSBURGH, PA. 15421-1421

FAIRMONT, WV. 26554

01/16/2026