

4705100883F

WW-7
8-30-06



West Virginia Department of Environmental Protection
Office of Oil and Gas
WELL LOCATION FORM: GPS

API: 47-51-00883 WELL NO.: MH 18

FARM NAME: Consolidation Coal Co.

RESPONSIBLE PARTY NAME: Monument Oil & Gas LLC

COUNTY: Marshall DISTRICT: Liberty

QUADRANGLE: Littleton

SURFACE OWNER: WV DNR Wildlife Resources Section

ROYALTY OWNER: Consolidation Coal Co.

UTM GPS NORTHING: 4399991

UTM GPS EASTING: 539409 GPS ELEVATION: 932

The Responsible Party named above has chosen to submit GPS coordinates in lieu of preparing a new well location plat for a plugging permit or assigned API number on the above well. The Office of Oil and Gas will not accept GPS coordinates that do not meet the following requirements:

1. Datum: NAD 1983, Zone: 17 North, Coordinate Units: meters, Altitude: height above mean sea level (MSL) – meters.
2. Accuracy to Datum – 3.05 meters
3. Data Collection Method:

Survey grade GPS : Post Processed Differential

Real-Time Differential

Mapping Grade GPS : Post Processed Differential

Real-Time Differential

4. Letter size copy of the topography map showing the well location.

I the undersigned, hereby certify this data is correct to the best of my knowledge and belief and shows all the information required by law and the regulations issued and prescribed by the Office of Oil and Gas.


Dy Dr
Signature

Land Manager
Title

12-27-21
Date

02/25/2022

MH 18

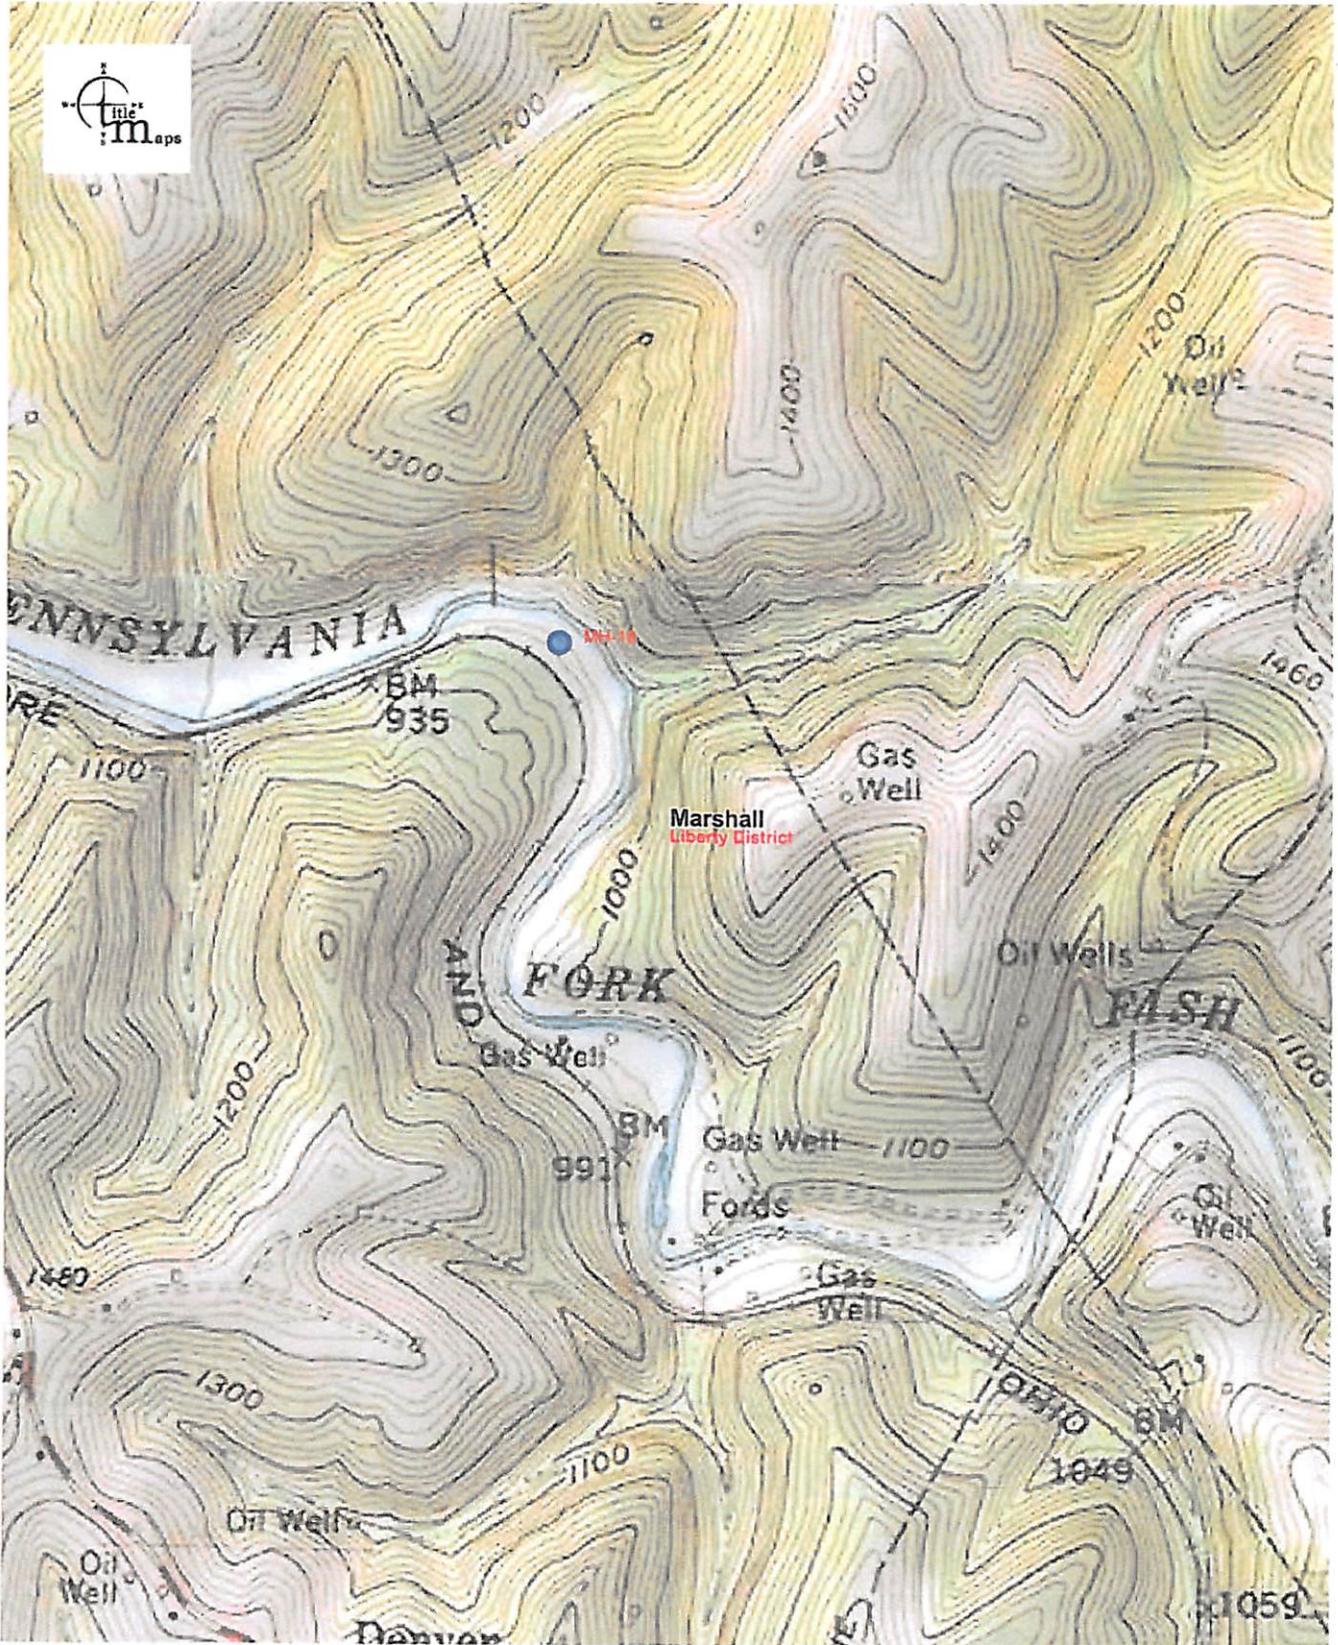

Approximate Scale 1:12,000

12/27/2021 - 02:52:12 PM

Disclaimer: The map information shown is from various sources including but not limited to tax maps and state and federal agency web sites. The map information does not represent and should not be relied upon as a land survey or legal depiction of the property or information shown. Title Maps LLC does not warrant the accuracy or correctness of the map information shown hereon.

02/25/2022