

4705100926P

WW-7
8-30-06



West Virginia Department of Environmental Protection
Office of Oil and Gas
WELL LOCATION FORM: GPS

API: 47-51-00926 WELL NO.: MH 13-REV

FARM NAME: Consolidation Coal Co.

RESPONSIBLE PARTY NAME: Monument Oil & Gas LLC

COUNTY: Marshall DISTRICT: Liberty

QUADRANGLE: Littleton

SURFACE OWNER: Consolidation Coal Co.

ROYALTY OWNER: _____

UTM GPS NORTHING: 4399252

UTM GPS EASTING: 539528 GPS ELEVATION: 934

The Responsible Party named above has chosen to submit GPS coordinates in lieu of preparing a new well location plat for a plugging permit or assigned API number on the above well. The Office of Oil and Gas will not accept GPS coordinates that do not meet the following requirements:

1. Datum: NAD 1983, Zone: 17 North, Coordinate Units: meters, Altitude: height above mean sea level (MSL) – meters.
2. Accuracy to Datum – 3.05 meters
3. Data Collection Method:

Survey grade GPS ____ : Post Processed Differential ____
Real-Time Differential ____

Mapping Grade GPS ____ : Post Processed Differential ____
Real-Time Differential ____

4. **Letter size copy of the topography map showing the well location.**

I the undersigned, hereby certify this data is correct to the best of my knowledge and belief and shows all the information required by law and the regulations issued and prescribed by the Office of Oil and Gas.


Dug Jan
Signature

Land Manager
Title

12/27/21
Date

02/25/2022

MH 13 REV

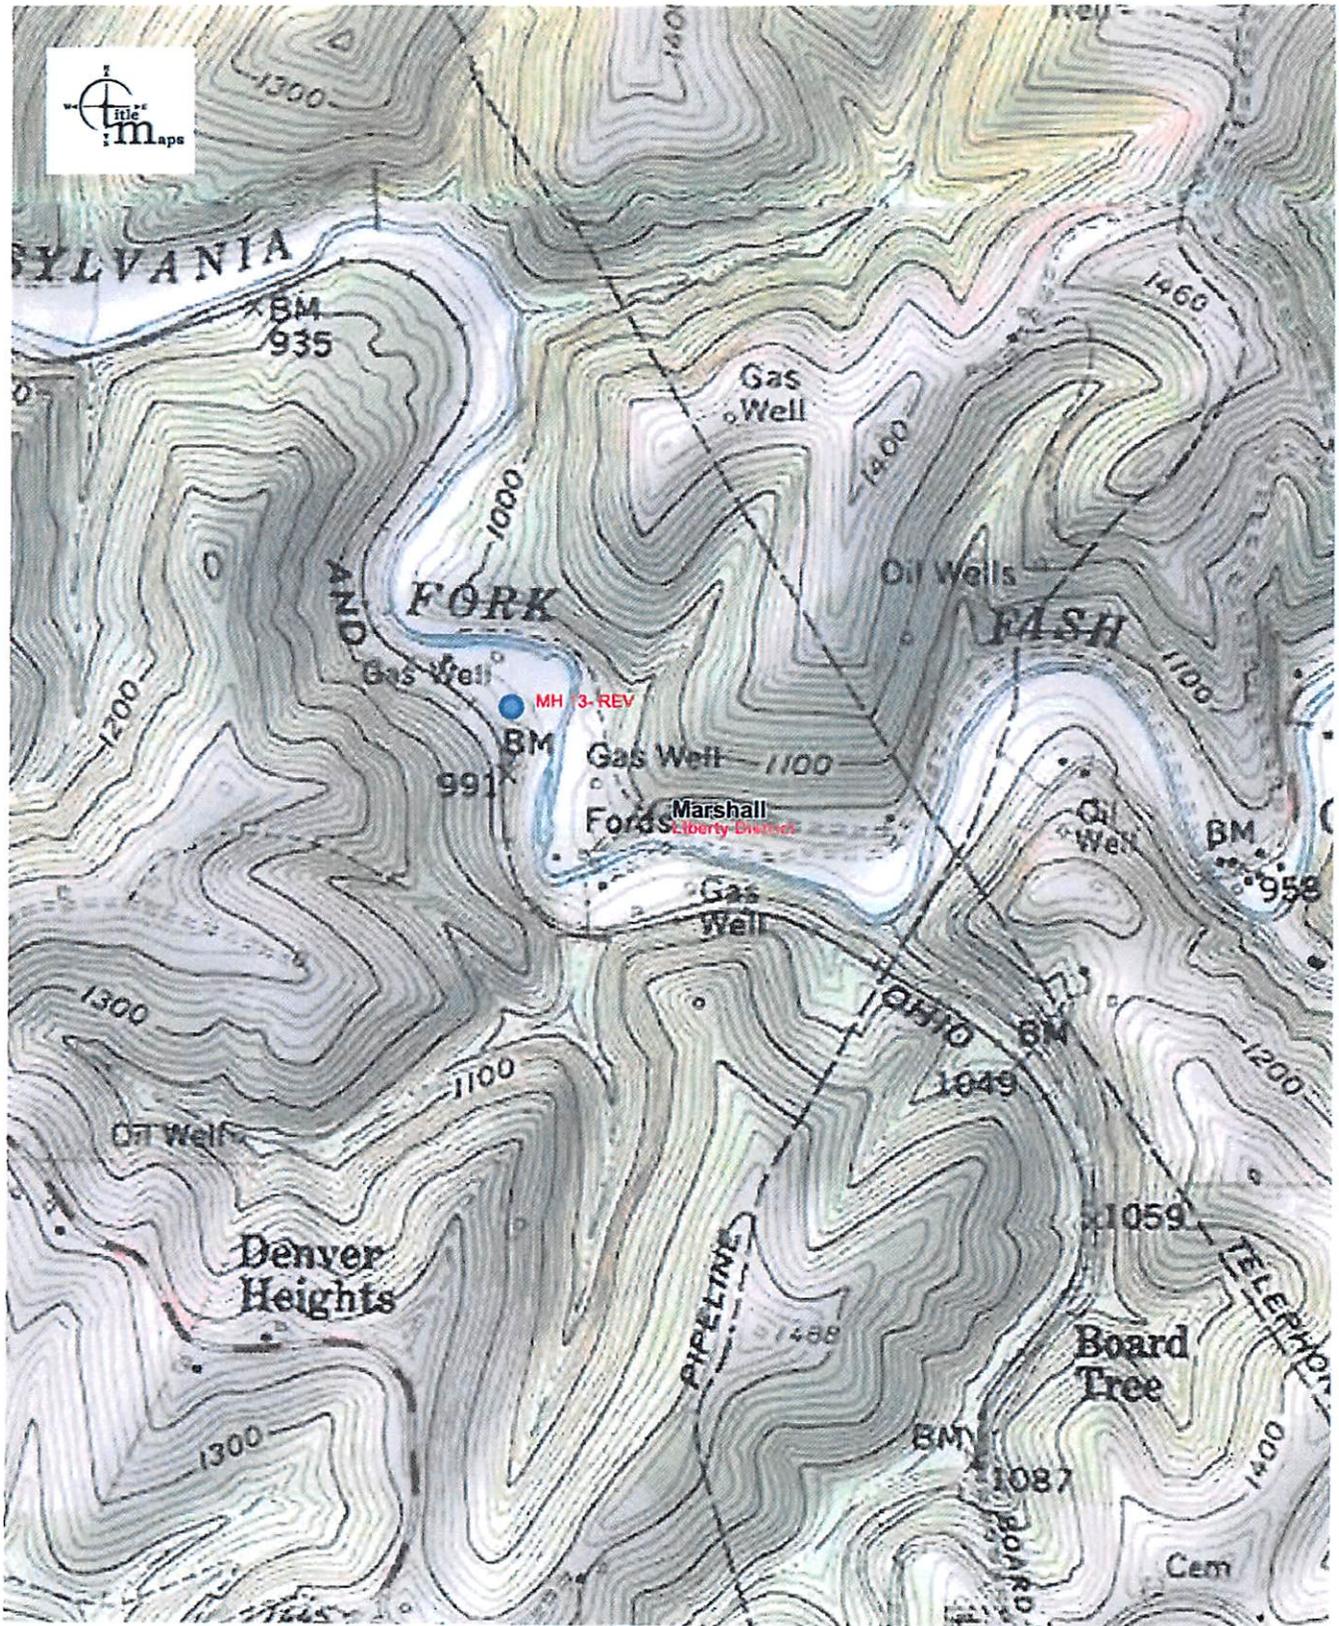

1000ft

Approximate Scale 1:12,000

12/27/2021 - 09:30:04 AM

Disclaimer: The map information shown is from various sources including but not limited to tax maps and state and federal agency web sites. The map information does not represent and should not be relied upon as a land survey or legal depiction of the property or information shown. Title Maps LLC does not warrant the accuracy or correctness of the map information shown hereon.

02/25/2022