

WW-7  
8-30-06



West Virginia Department of Environmental Protection  
Office of Oil and Gas  
**WELL LOCATION FORM: GPS**

API: 4705101026 WELL NO.: 4N AC

FARM NAME: RAE Mac Corp.

RESPONSIBLE PARTY NAME: CNX

COUNTY: Marshall DISTRICT: Franklin

QUADRANGLE: Powhatan

SURFACE OWNER: Jason Miller, et al

ROYALTY OWNER: Jason Miller, et al

UTM GPS NORTHING: 4410648.82

UTM GPS EASTING: 520876.84 GPS ELEVATION: 1342.00

The Responsible Party named above has chosen to submit GPS coordinates in lieu of preparing a new well location plat for a plugging permit or assigned API number on the above well. The Office of Oil and Gas will not accept GPS coordinates that do not meet the following requirements:

1. Datum: NAD 1983, Zone: 17 North, Coordinate Units: meters, Altitude: height above mean sea level (MSL) – meters.
2. Accuracy to Datum – 3.05 meters
3. Data Collection Method:

Survey grade GPS  : Post Processed Differential \_\_\_\_\_

Real-Time Differential

Mapping Grade GPS \_\_\_\_\_ : Post Processed Differential \_\_\_\_\_

Real-Time Differential \_\_\_\_\_

4. Letter size copy of the topography map showing the well location.

I the undersigned, hereby certify this data is correct to the best of my knowledge and belief and shows all the information required by law and the regulations issued and prescribed by the Office of Oil and Gas.

  
Signature

Project MANAGER  
Title

12-3-20  
Date


03/19/2021

RECEIVED  
Office of Oil and Gas

DEC 10 2020

WV Department of  
Environmental Protection

4705101826P  
Z

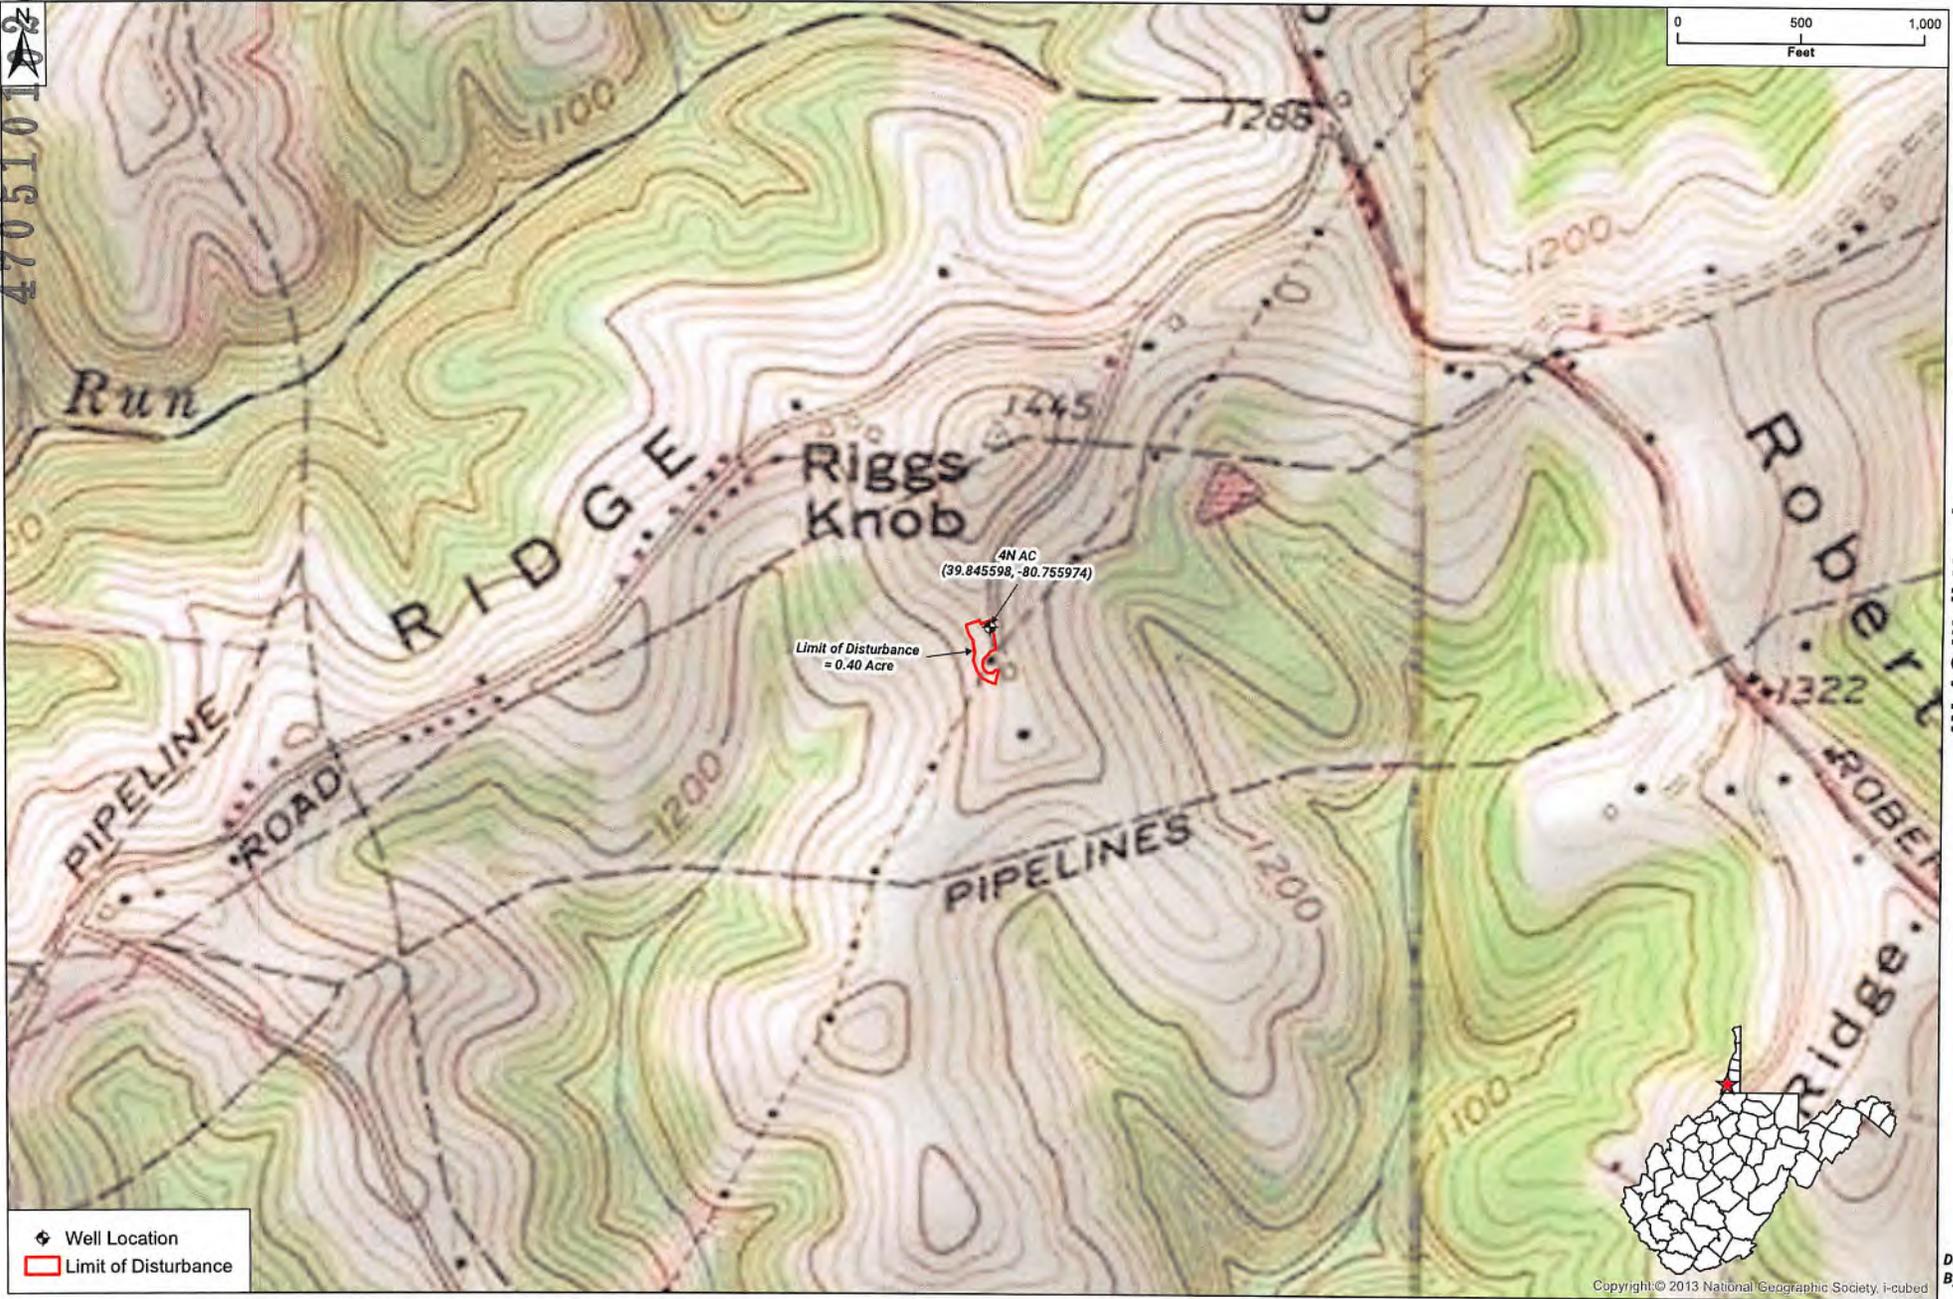

4N AC Well Head  
Site Location Topographic Map  
Marshall County, West Virginia



Date: 11/19/21  
By: R. Kenner

Copyright © 2013 National Geographic Society, i-cubed