

WW-7  
8-30-06



West Virginia Department of Environmental Protection  
Office of Oil and Gas  
**WELL LOCATION FORM: GPS**

API: 47-051-01061 WELL NO.: MH26

FARM NAME: Consolidation Coal Company

RESPONSIBLE PARTY NAME: Chuck Shaynak

COUNTY: Marshall DISTRICT: Liberty

QUADRANGLE: Littleton

SURFACE OWNER: Consolidation Coal Company

ROYALTY OWNER: Consolidation Coal Company

UTM GPS NORTHING: 4399919.19

UTM GPS EASTING: 539036.82 GPS ELEVATION: 934.91'

The Responsible Party named above has chosen to submit GPS coordinates in lieu of preparing a new well location plat for a plugging permit or assigned API number on the above well. The Office of Oil and Gas will not accept GPS coordinates that do not meet the following requirements:

1. Datum: NAD 1983, Zone: 17 North, Coordinate Units: meters, Altitude: height above mean sea level (MSL) – meters.
2. Accuracy to Datum – 3.05 meters
3. Data Collection Method:  
Survey grade GPS X : Post Processed Differential X

Real-Time Differential \_\_\_\_\_

Mapping Grade GPS \_\_\_\_\_ : Post Processed Differential \_\_\_\_\_

Real-Time Differential \_\_\_\_\_

4. Letter size copy of the topography map showing the well location.

I the undersigned, hereby certify this data is correct to the best of my knowledge and belief and shows all the information required by law and the regulations issued and prescribed by the Office of Oil and Gas.

Charles Shaynak  
Signature


Senior Vice President PA Ops  
Title

9-16-15  
Date

Received  
Office of Oil & Gas

OCT 01 2015

10/23/2015

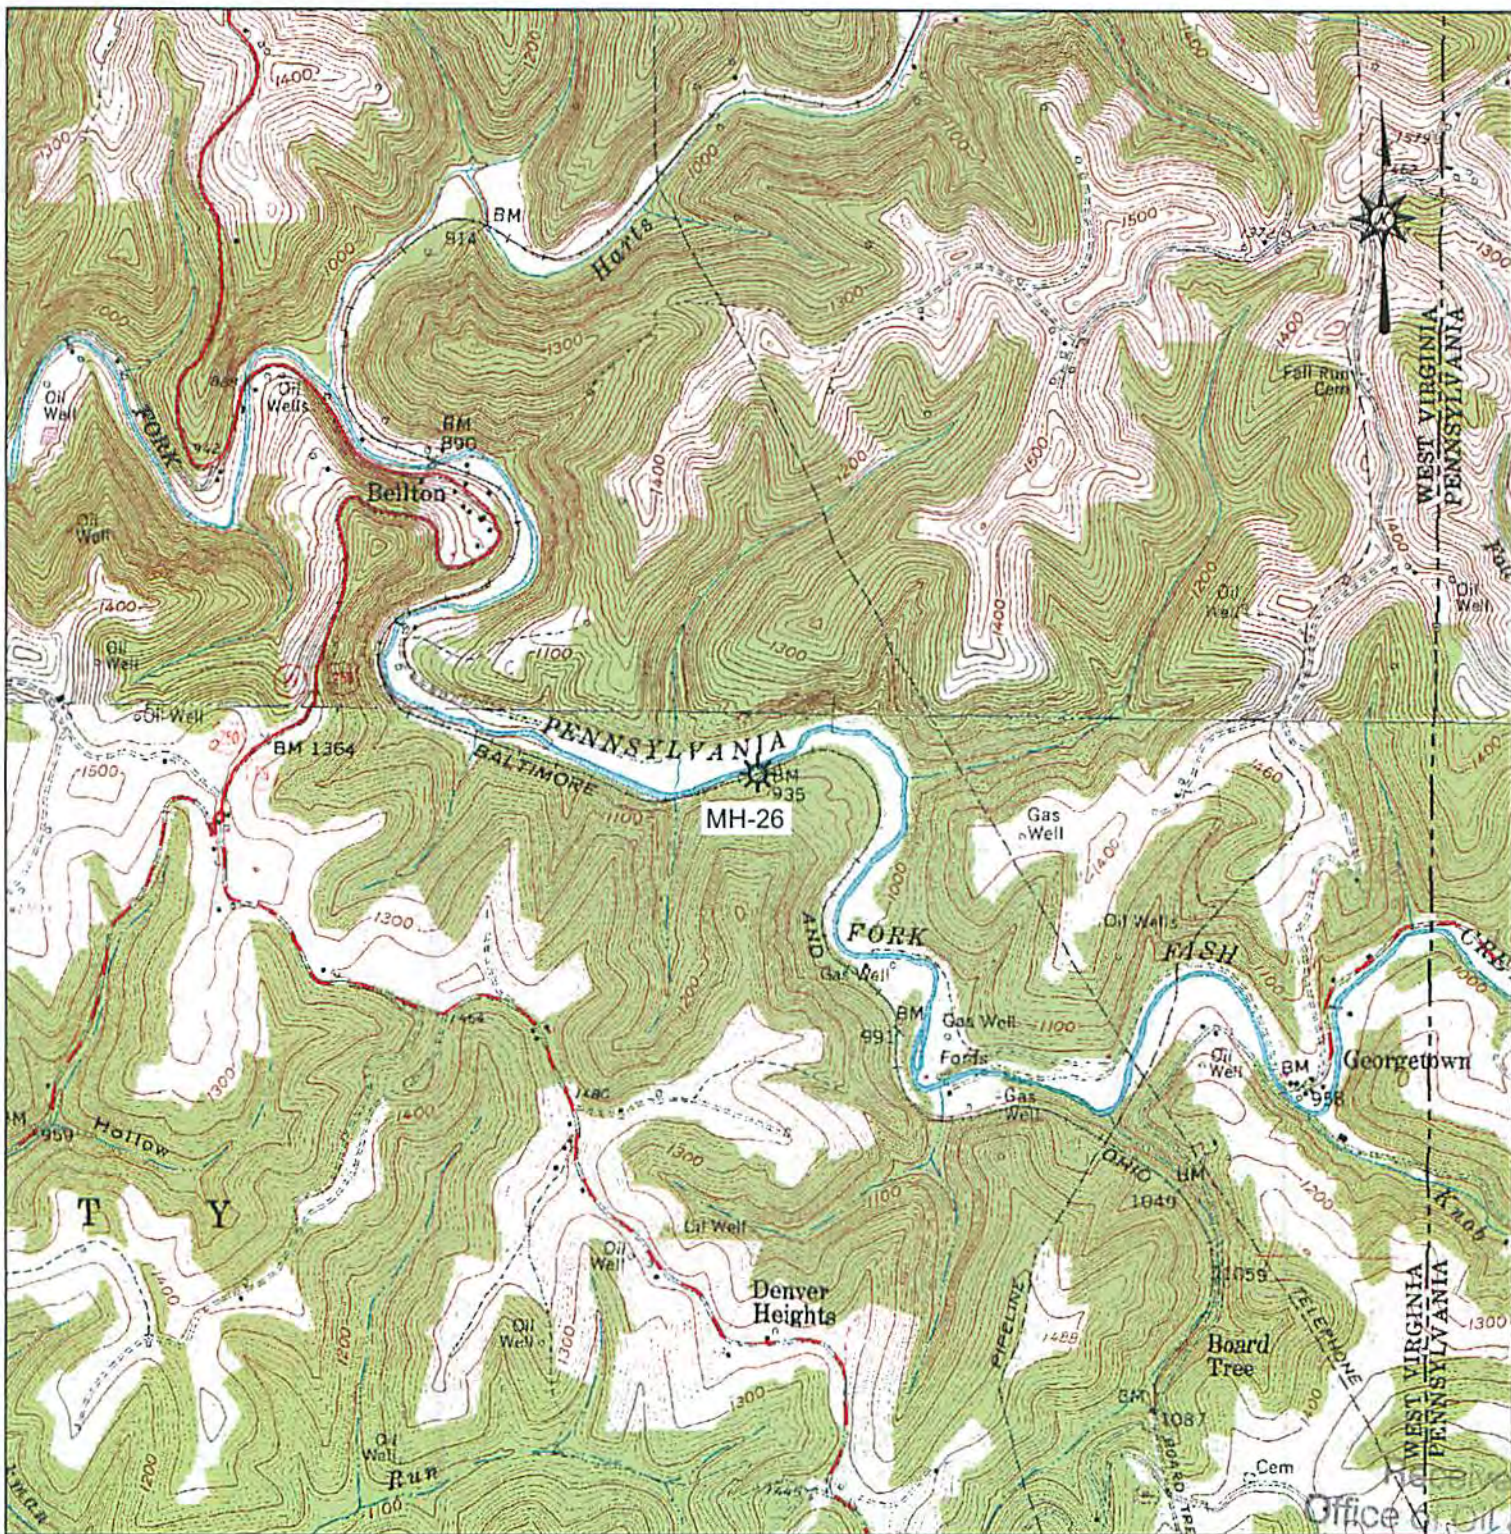


**Blue Mountain Inc.**  
 10125 MASON DIXON HIGHWAY  
 BURTON, WV 26562  
 PHONE: (304) 662-6486

**PREPARED FOR:**  
 CNX GAS COMPANY LLC  
 200 EVERGREENE DRIVE  
 WAYNESBURG, PA 15370

**COORDINATES:**  
 UTM 17-NAD83: N:4399919.19  
 (METERS) E:539036.82  
 NAD27, WV NORTH: N:456332.349  
 (FEET) E:1706300.305  
 EL:934.91

**MH-26 OCT 01 2015**  
**LOCATION MAP**  
**MARSHALL COUNTY**  
**LIBERTY DISTRICT**  
**WEST VIRGINIA**

TOPO QUAD: LITTLETON, WV  
 SCALE: 1" = 2000'  
 DATE: SEPTEMBER 17, 2015