

WW-7
8-30-06



West Virginia Department of Environmental Protection
Office of Oil and Gas

WELL LOCATION FORM: GPS

API: 47-051-01084 WELL NO.: 4A2
 FARM NAME: Carroll & Anna Morris
 RESPONSIBLE PARTY NAME: Monument Oil & Gas LLC
 COUNTY: Marshall DISTRICT: Liberty
 QUADRANGLE: Glen Easton
 SURFACE OWNER: Carroll & Anna Morris
 ROYALTY OWNER: Carroll & Anna Morris
 UTM GPS NORTHING: 4407118
 UTM GPS EASTING: 531455 GPS ELEVATION: 1180

The Responsible Party named above has chosen to submit GPS coordinates in lieu of preparing a new well location plat for a plugging permit or assigned API number on the above well. The Office of Oil and Gas will not accept GPS coordinates that do not meet the following requirements:

1. Datum: NAD 1983, Zone: 17 North, Coordinate Units: meters, Altitude: height above mean sea level (MSL) – meters.
2. Accuracy to Datum – 3.05 meters
3. Data Collection Method:

Survey grade GPS ____ : Post Processed Differential ____

Real-Time Differential ____

Mapping Grade GPS ____ : Post Processed Differential ____

Real-Time Differential ____

4. Letter size copy of the topography map showing the well location.

I the undersigned, hereby certify this data is correct to the best of my knowledge and belief and shows all the information required by law and the regulations issued and prescribed by the Office of Oil and Gas.


Don Land Manager 03/02/22
 Signature Title Date

RECEIVED
Office of Oil and Gas

MAR 7 2022

WV Department of
Environmental Protection

CNX 4A2

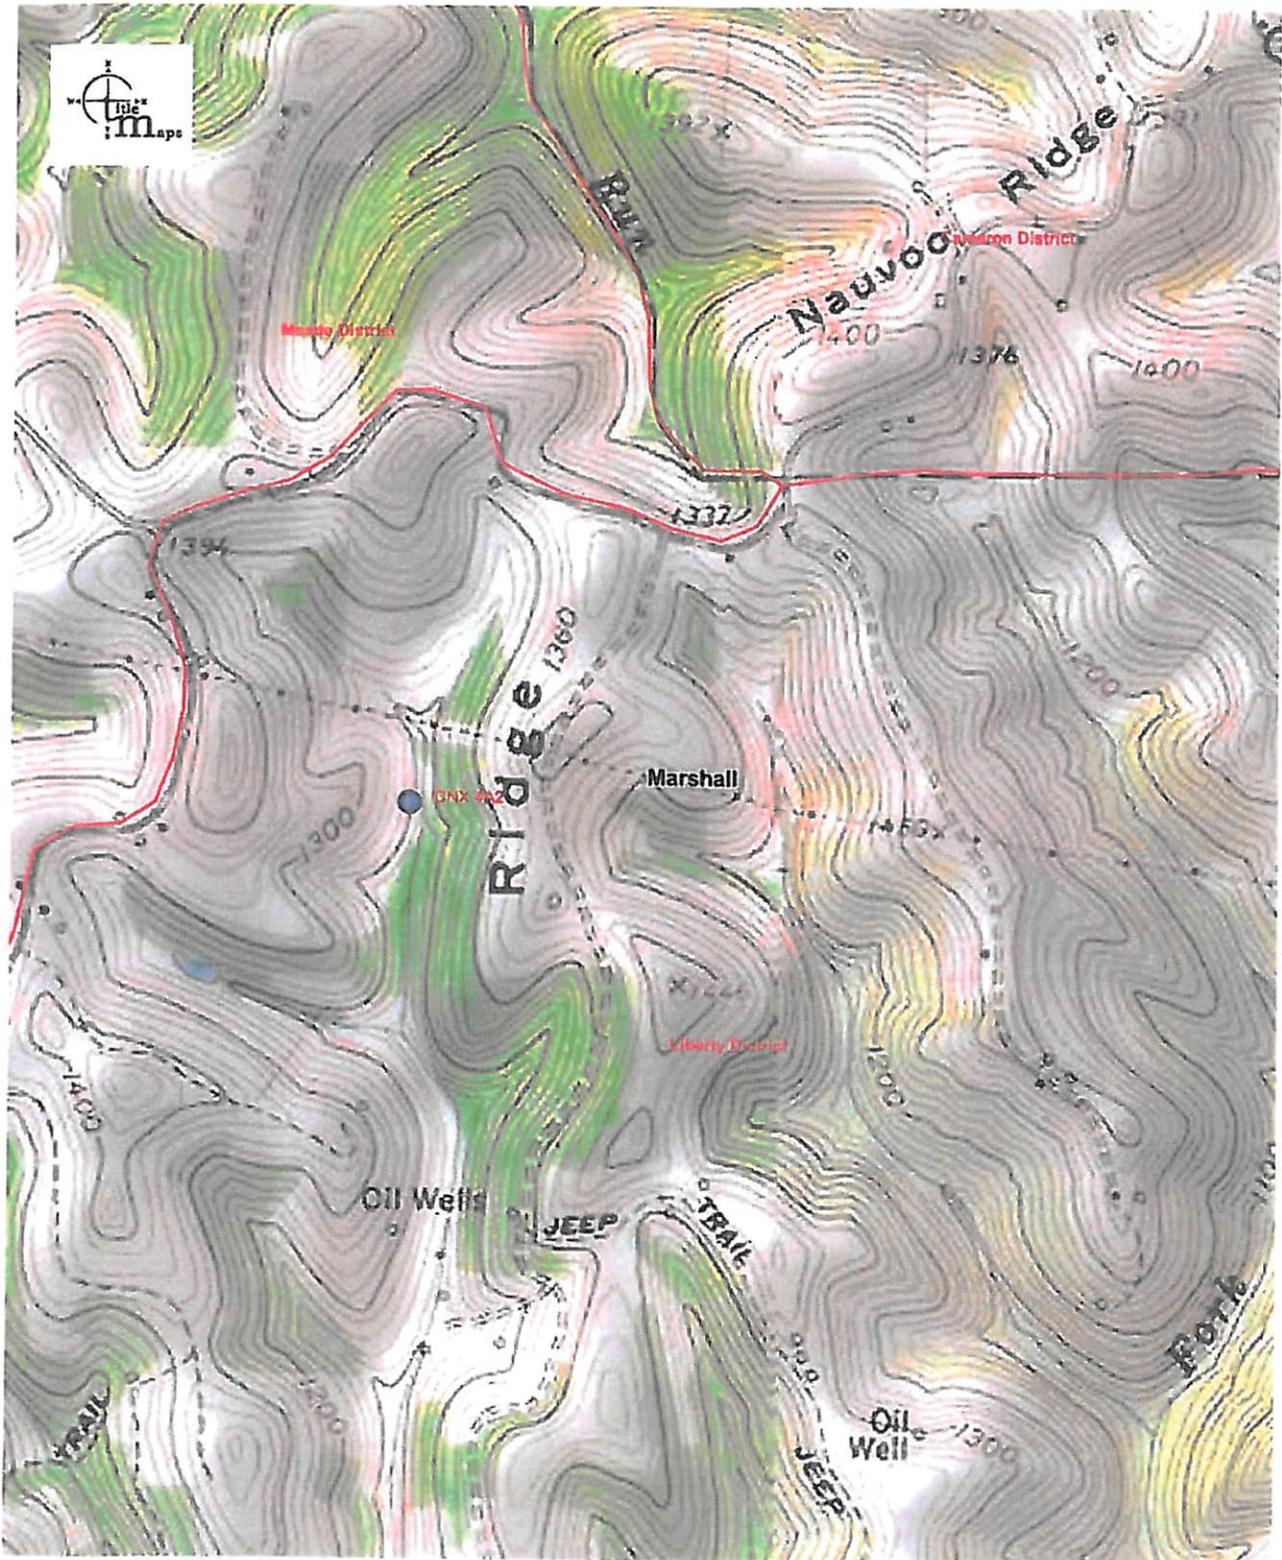

Approximate Scale 1:12,000

RECEIVED 03/07/2022 - 12:44:41 PM
Office of Oil and Gas

MAR 7 2022

WV Department of
Environmental Protection

Disclaimer: The map information shown is from various sources including but not limited to tax maps and state and federal agency web sites. The map information does not represent and should not be relied upon as a land survey or legal depiction of the property or information shown. Title Maps LLC does not warrant the accuracy or correctness of the map information shown hereon.

03/25/2022