

47-051-01149C

WW-7
8-30-06



West Virginia Department of Environmental Protection
Office of Oil and Gas

WELL LOCATION FORM: GPS

API: 47-051-01149C WELL NO.: MC-110A

FARM NAME: DAVID W. SCHRACK

RESPONSIBLE PARTY NAME: WEST VIRGINIA LAND RESOURCES INC.

COUNTY: MARSHALL DISTRICT: WEBSTER

QUADRANGLE: MAJORSVILLE WV, PA

SURFACE OWNER: DAVID W. SCHRACK

ROYALTY OWNER: _____

UTM GPS NORTHING: 4,419,057 m (1148')

UTM GPS EASTING: 533,625 m GPS ELEVATION: 347 m

The Responsible Party named above has chosen to submit GPS coordinates in lieu of preparing a new well location plat for a plugging permit or assigned API number on the above well. The Office of Oil and Gas will not accept GPS coordinates that do not meet the following requirements:

- Datum: NAD 1983, Zone: 17 North, Coordinate Units: meters, Altitude: height above mean sea level (MSL) – meters.
- Accuracy to Datum – 3.05 meters
- Data Collection Method:

Survey grade GPS : Post Processed Differential _____
Real-Time Differential

Mapping Grade GPS _____ : Post Processed Differential _____
Real-Time Differential _____

RECEIVED
Office of Oil and Gas

APR 8 2021

WV Department of
Environmental Protection

4. **Letter size copy of the topography map showing the well location.**

I the undersigned, hereby certify this data is correct to the best of my knowledge and belief and shows all the information required by law and the regulations issued and prescribed by the Office of Oil and Gas.

Signature

Professional Surveyor

Title

FEBRUARY 10, 2021

Date

11/19/2021

47-051-01149P

57°30"


4422

4863 1 NW
(MOUNDSVILLE)

4420

55'

MOUNDSVILLE 9.3 MI.
3.5 MI. TO W. VA. 68

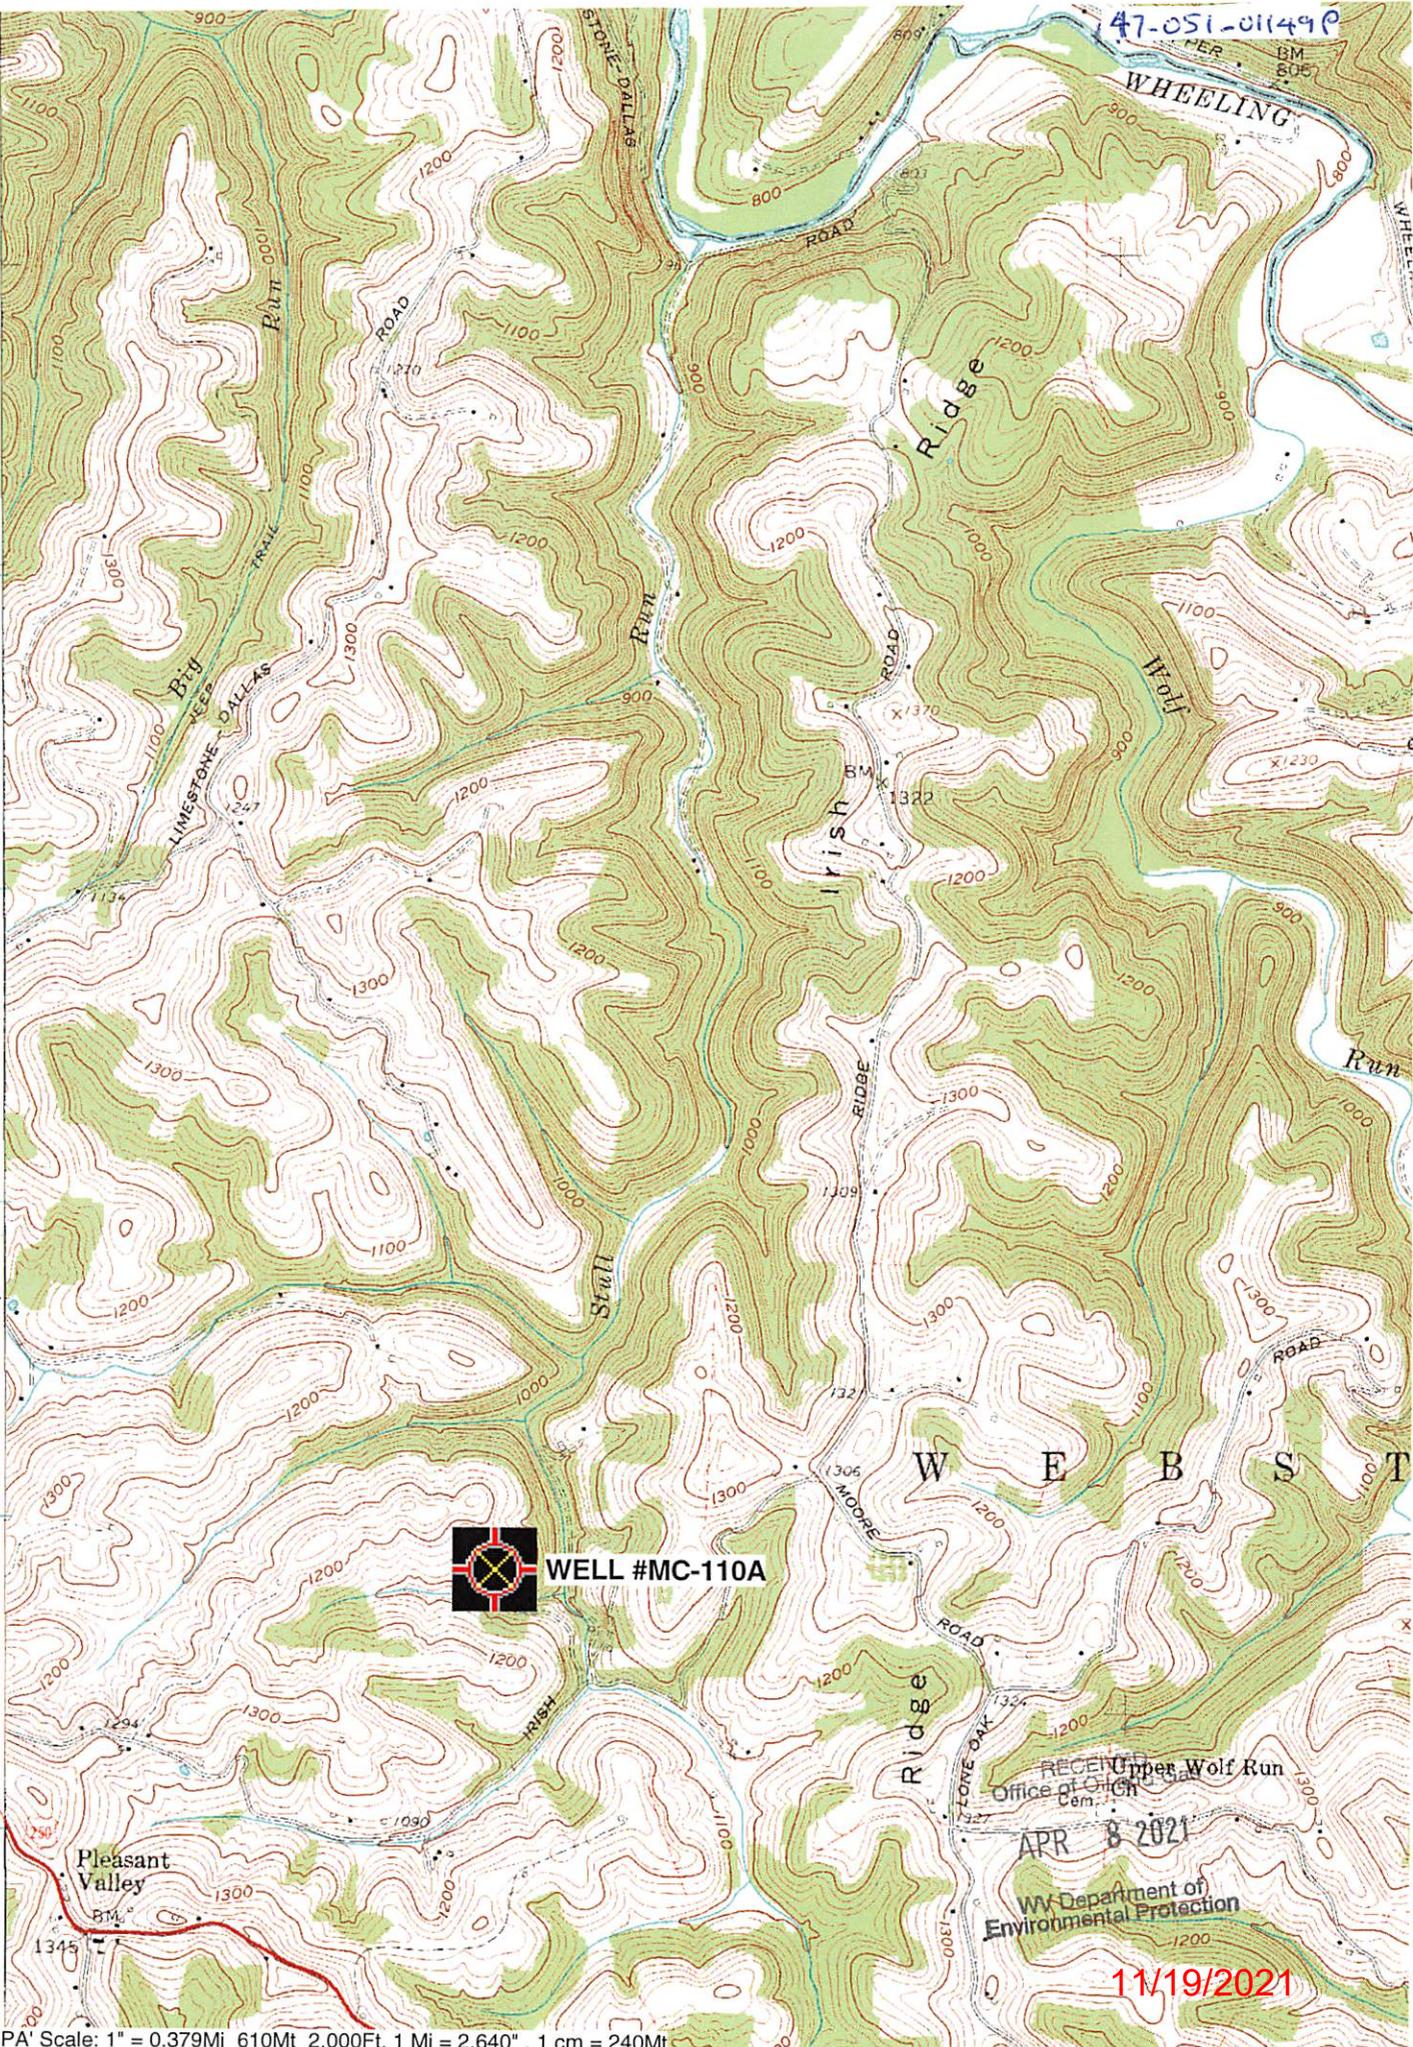

WELL #MC-110A

RECEIVED
Office of Oil & Gas
Cem. Ch.
APR 8 2021
WV Department of
Environmental Protection

11/19/2021