

WW-7
8-30-06



West Virginia Department of Environmental Protection
Office of Oil and Gas
WELL LOCATION FORM: GPS

API: 47-51-01198C WELL NO.: MC34

FARM NAME: N/A

RESPONSIBLE PARTY NAME: CNX Gas Company LLC

COUNTY: Marshall DISTRICT: Liberty

QUADRANGLE: Glen Easton, WV 7.5'

SURFACE OWNER: Donald Ray Baker

ROYALTY OWNER: _____

UTM GPS NORTHING: 4400224.6 (1301.5')

UTM GPS EASTING: 530310.73 GPS ELEVATION: 396.8

The Responsible Party named above has chosen to submit GPS coordinates in lieu of preparing a new well location plat for a plugging permit or assigned API number on the above well. The Office of Oil and Gas will not accept GPS coordinates that do not meet the following requirements:

1. Datum: NAD 1983, Zone: 17 North, Coordinate Units: meters, Altitude: height above mean sea level (MSL) – meters.
2. Accuracy to Datum – 3.05 meters
3. Data Collection Method:

Survey grade GPS _____; Post Processed Differential _____

Real-Time Differential _____

Mapping Grade GPS : Post Processed Differential _____

Real-Time Differential

4. Letter size copy of the topography map showing the well location.

I the undersigned, hereby certify this data is correct to the best of my knowledge and belief and shows all the information required by law and the regulations issued and prescribed by the Office of Oil and Gas.

Raymond Hearn
Signature


PERMITTING - SUPERVISOR
Title

11-6-18
Date

RECEIVED
Office of Oil and Gas

DEC 4 2018

WV Department of
Environmental Protection

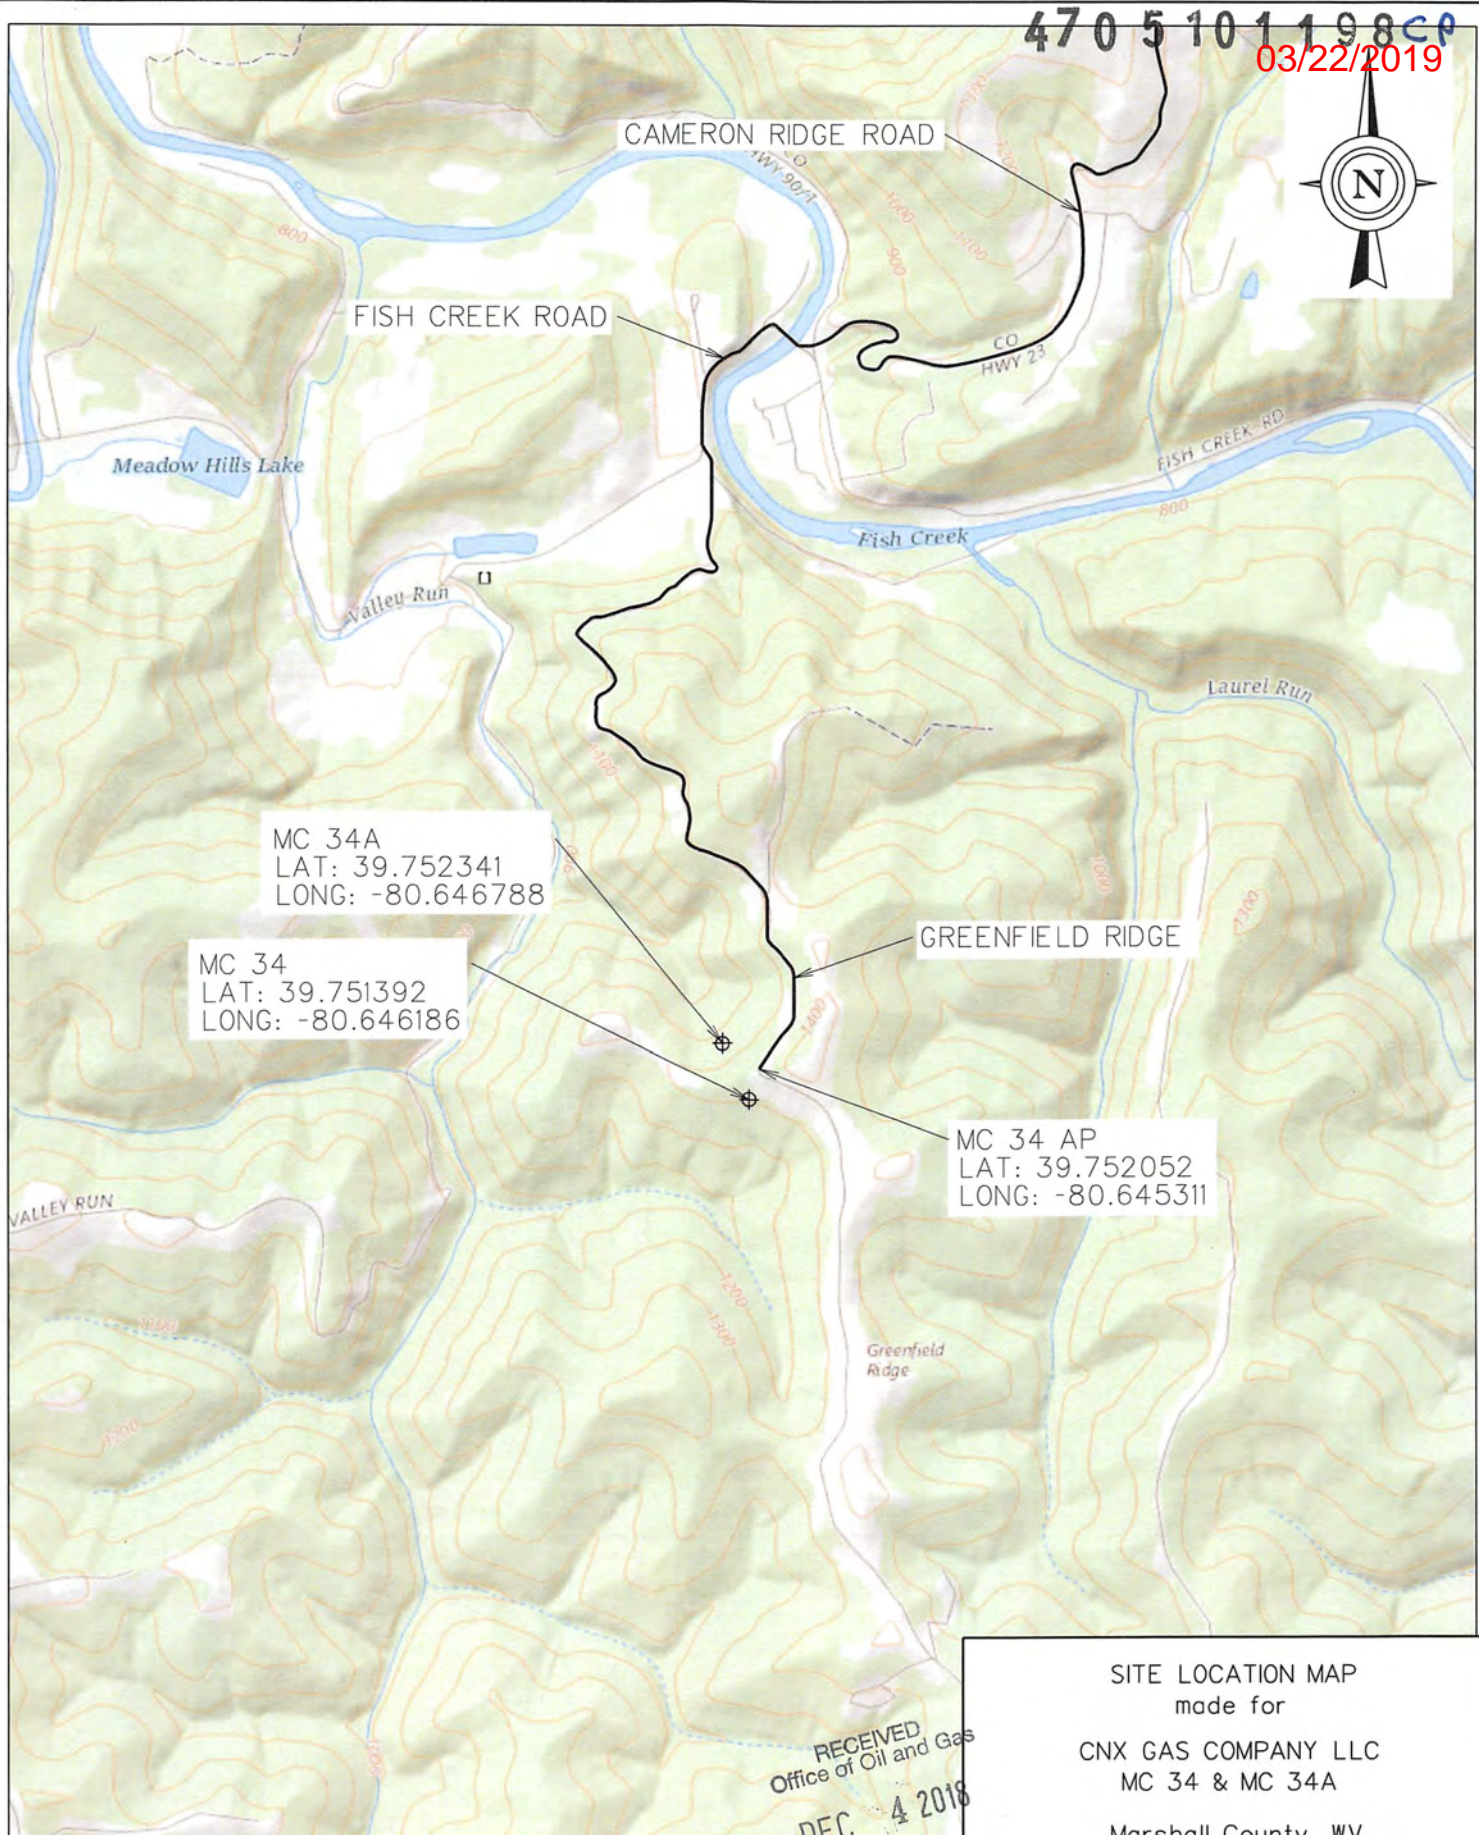

MC 34A
LAT: 39.752341
LONG: -80.646788

MC 34
LAT: 39.751392
LONG: -80.646186

MC 34 AP
LAT: 39.752052
LONG: -80.645311

RECEIVED
Office of Oil and Gas
DEC 4 2018

WV Department of
Environmental Protection

REFERENCES: IMAGERY PROVIDED BY USGS:
CAMERON, WV QUADRANGLE;
STATE 7.5 MINUTE SERIES



SITE LOCATION MAP
made for
CNX GAS COMPANY LLC
MC 34 & MC 34A
Marshall County, WV
prepared by
STAHL SHEAFFER ENGINEERING
6000 Town Center Blvd., Suite 215
Canonsburg, PA. 15317
Phone: 724.960.1111 Fax: 724.960.1162