


LATITUDE 39°50'00"

LONGITUDE 80°30'00"

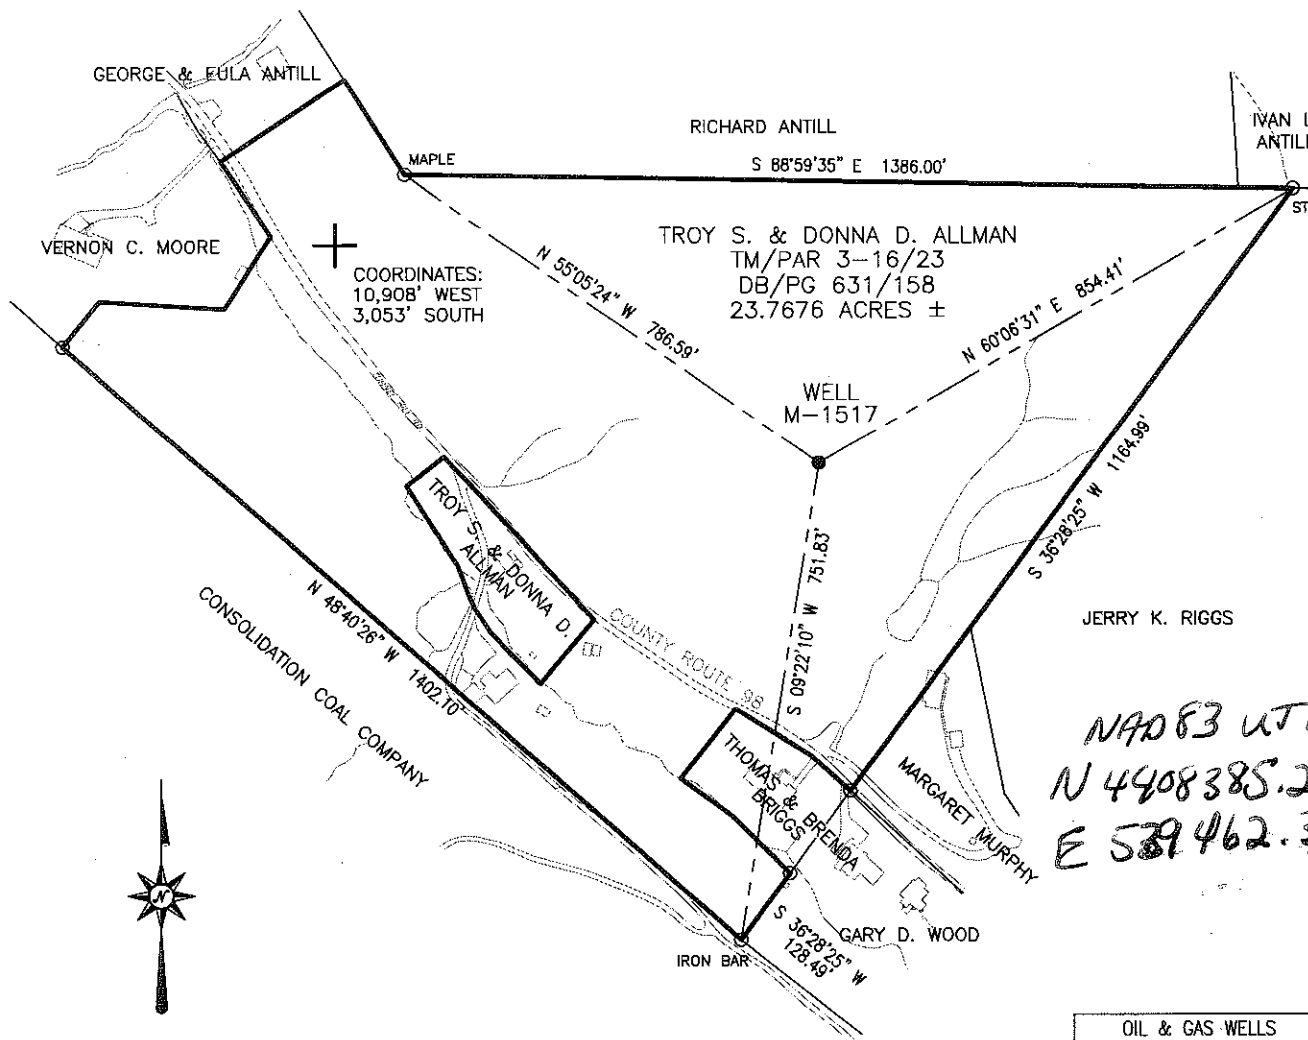


*NAD83 UTM  
N 4408385.222  
E 589462.377*



**Blue Mountain Engineering**  
11023 MASON DIXON HIGHWAY  
BURTON, WV 26562  
PHONE: (304) 662-6486


NOTE:

It is not the purpose or intention of this plat to represent surveyed locations of the surface or mineral parcels depicted hereon. The location of the boundary lines, as shown, are based on record deed descriptions, field evidence found and/or tax map position, unless otherwise noted.

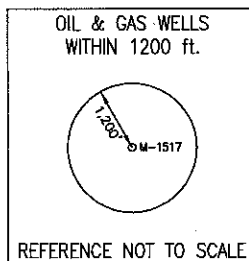

FILE #: M-1517  
DRAWING #: M-1517  
SCALE: 1" = 300'  
MINIMUM DEGREE OF ACCURACY: 1/2500  
PROVEN SOURCE OF ELEVATION: U.S.G.S. MONUMENT THOMAS 1498.81'

I, THE UNDERSIGNED, HEREBY CERTIFY THAT THIS PLAT IS CORRECT TO THE BEST OF MY KNOWLEDGE AND BELIEF AND SHOWS ALL THE INFORMATION REQUIRED BY LAW AND THE REGULATIONS ISSUED AND PRESCRIBED BY THE DEPARTMENT OF ENVIRONMENTAL PROTECTION.  
Signed: \_\_\_\_\_  
R.P.E.: \_\_\_\_\_ L.L.S.: P.S. No. 2000

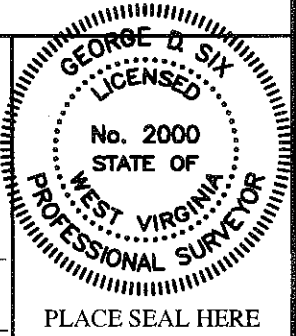

(+) DENOTES LOCATION OF WELL ON UNITED STATES TOPOGRAPHIC MAPS WVDEP  
OFFICE OF OIL & GAS  
601 57TH STREET  
CHARLESTON, WV 25304



DATE: MARCH 1, 2012  
OPERATOR'S WELL #: M-1517  
API WELL #: 47 STATE 51 COUNTY PERMIT 01560P

Well Type:  Oil  Waste Disposal  Production  Deep  
 Gas  Liquid Injection  Storage  Shallow

WATERSHED: UNNAMED TRIBUTARY TO GRAVE CREEK ELEVATION: 1220.76'

COUNTY/DISTRICT: MARSHALL/CAMERON QUADRANGLE: CAMERON, WV-PA 7.5'

SURFACE OWNER: TROY S. & DONNA D. ALLMAN ACREAGE: 23.7676±

OIL & GAS ROYALTY OWNER: \_\_\_\_\_ ACREAGE: \_\_\_\_\_

DRILL  CONVERT  DRILL DEEPER  REDRILL  FRACTURE OR STIMULATE   
PLUG OFF OLD FORMATION  PERFORATE NEW FORMATION  PLUG & ABANDON   
CLEAN OUT & REPLUG  OTHER CHANGE  (SPECIFY): \_\_\_\_\_

TARGET FORMATION: NONE ESTIMATED DEPTH: \_\_\_\_\_

WELL OPERATOR: McELROY COAL COMPANY DESIGNED AGENT: MICHELE O'NEIL  
Address: 6126 ENERGY DRIVE Address: 6126 ENERGY DRIVE  
City: MOUNDSVILLE State: WV Zip Code: 26041 City: MOUNDSVILLE State: WV Zip Code: 26041

04/06/2012



51-01560 P



**Blue Mountain Engineering**  
 11023 MASON DIXON HIGHWAY  
 BURTON, WV 26562  
 PHONE: (304) 662-6486

RECEIVED  
 Office of Oil & Gas  
 McELROY WELL # M-1517  
 CAMERON QUADRANGLE  
 WEST VIRGINIA  
 MAR 21 2012

LOCATION MAP  
 MARCH 1, 2012

SCALE 1" = 2000'

0' 2000' 4000' 6000'



**BLUE MOUNTAIN ENGINEERING**

Department of  
 Environmental Protection

04/06/2012