

6,870' to Top Hole

39° 52' 30"
5298' to Bottom Hole

WELL: MND1 AHS Coordinates

WV SPC North (NAD 27)

SURFACE LOCATION
N - 494,217.9
E - 1,642,179.9

LANDING POINT
N - 495,763.9
E - 1,644,164.4

BOTTOM HOLE
N - 496,295.9
E - 1,643,781.9

UTM NAD 83 (mlr)

SURFACE LOCATION
N - 4,411,134.3
E - 519,309.0

BOTTOM HOLE
N - 4,411,775.5
E - 519,786.5

LAT/LONG (NAD 83)

SURFACE LOCATION
39.850009°
80.774265°

BOTTOM HOLE
39.855775°
80.768865°

Powhatan Point, OH

Captina Island (USA)



NOTES ON SURVEY

- No water supply wells or developed springs are located within 1,500' of proposed well
- No occupied dwellings or buildings 2500 sq. ft. or larger are located within 625' of proposed well
- Latitude/Longitude offset measurements are referenced to NAD 1927. Well tie lines are referenced to UTM Zone 17 North (NAD 83).
- The location of boundary lines shown herein are based on deed descriptions and boundary data supplied by PVE as shown on the original plats submitted with permit applications in 2015 and 2018. This plat is not intended to represent a boundary survey as defined in §23-5-2 of the W.Va. Legislative Rules.
- Lease Boudaries shown herein are located as described in the provided Certified Title Opinions.

LEGEND

- 100 Surface Parcel No.
- 2 Lease Reference No.
- Lease Boundary
- Surface Boundary
- Proposed Horizontal Lateral
- Proposed Curve Section
- Stream

North

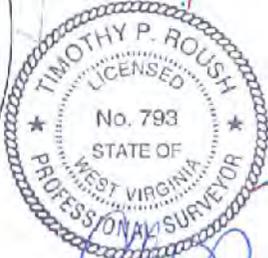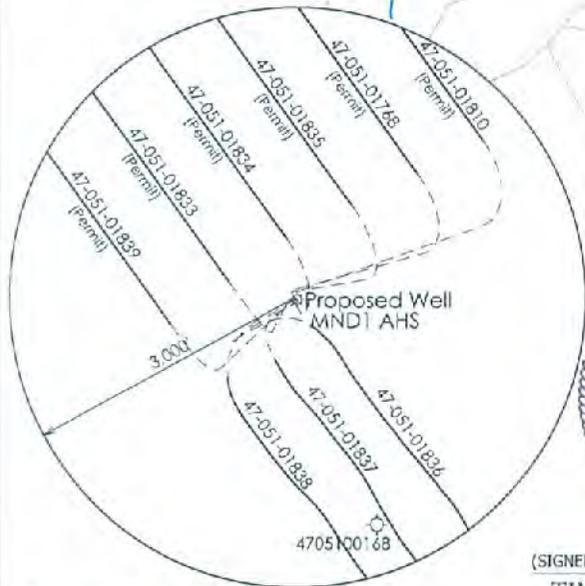

(SIGNED) TIMOTHY P. ROUSH PS 793

- DENOTES LOCATION OF WELL ON UNITED STATES TOPOGRAPHIC MAPS.

I, THE UNDERSIGNED, HEREBY CERTIFY THAT THIS PLAT IS CORRECT TO THE BEST OF MY KNOWLEDGE AND BELIEF AND SHOWS ALL THE INFORMATION REQUIRED BY LAW AND THE REGULATIONS ISSUED AND PRESCRIBED BY THE DEPARTMENT OF ENVIRONMENTAL PROTECTION.

FILE NO. _____
 SCALE: 1" = 1,500'
 MINIMUM DEGREE OF ACCURACY: Sub-Meter
 PROVEN SOURCE OF ELEVATION: DGPS Survey



WEST VIRGINIA
 Department of Environmental Protection
 Office of Oil and Gas
 601 57th Street
 Charleston, West Virginia 25301

DATE: September 14, 2021
 WELL NAME: MND1 AHS
 API WELL NO.: 47 - 051 - 01810
 State County Permit

WELL TYPE: OIL ___ GAS LIQUID INJECTION ___ WASTE DISPOSAL ___ (IF "GAS") PRODUCTION STORAGE ___ DEEP ___ SHALLOW

LOCATION: ELEVATION 1,150' WATERSHED Hog Run - Ohio River
 DISTRICT: Clay COUNTY: Marshall QUADRANGLE: Powhatan Point 7.5'
 SURFACE OWNER: Marshall County Coal Resources, Inc. ACREAGE: 128.32 Ac.

OIL & GAS ROYALTY OWNER: HG Energy II Appalachia, LLC LEASE ACREAGE: 128.32 Ac. LEASE NO. _____
 PROPOSED WORK: DRILL CONVERT ___ DRILL DEEPER ___ REDRILL ___ FRACTURE OR STIMULATE PLUG OFF OLD FORMATION ___
 PERFORATE NEW FORMATION ___ OTHER PHYSICAL CHANGE IN WELL (SPECIFY) MOD Plat - Revised BHL and TVD
 PLUG AND ABANDON ___ CLEAN OUT AND REPLUG ___ TARGET FORMATION Marcellus Shale ESTIMATED DEPTH 6,290' TVD 8,172' TMD

WELL OPERATOR: HG Energy II Appalachia, LLC ADDRESS: 5260 DuPont Road Parkersburg, WV 26101
 DESIGNATED AGENT: Diane White ADDRESS: 5260 DuPont Road Parkersburg, WV 26101

7,029' to Bottom Hole 80° 45' 00"

9,129' to Top Hole

10/29/2021

6,870' to Top Hole

39° 52' 30"
5298' to Bottom Hole

WELL: MND1 AHS Coordinates

WV SPC North (NAD 27)

SURFACE LOCATION
N - 494,217.9
E - 1,642,179.9

LANDING POINT
N - 495,763.9
E - 1,644,154.4

BOTTOM HOLE
N - 496,295.9
E - 1,643,781.9

UTM NAD 83 (mtr)

SURFACE LOCATION
N - 4,411,134.3
E - 519,309.0

BOTTOM HOLE
N - 4,411,775.5
E - 519,786.5


LAT/LONG (NAD 83)

SURFACE LOCATION
39.850009°
80.774286°

BOTTOM HOLE
39.855775°
80.768685°

LEASE TABLE

①	HG ENERGY II APPALACHIA, LLC	TMP 04-14-10
②	HG ENERGY II APPALACHIA, LLC	TMP 04-14-09
⑬	HG ENERGY II APPALACHIA, LLC	TMP 04-14-08

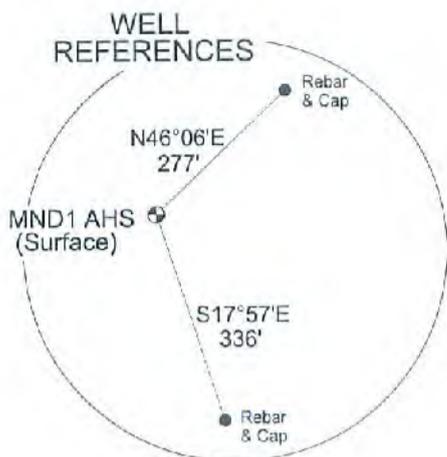


7,029' to Bottom Hole
80° 45' 00"
9,129' to Top Hole

North

SURFACE PARCEL TABLE

100	Marshall County Coal Resources, Inc.	TMP 04-14-09
101	Marshall County Coal Resources, Inc.	TMP 04-14-10
113	Marshall County Coal Resources, Inc.	TMP 04-14-08
124	Eugene C. & Elizabeth A. Estep	TMP 04-13-02

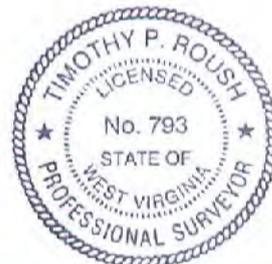

I, THE UNDERSIGNED, HEREBY CERTIFY THAT THIS PLAT IS CORRECT TO THE BEST OF MY KNOWLEDGE AND BELIEF AND SHOWS ALL THE INFORMATION REQUIRED BY LAW AND THE REGULATIONS ISSUED AND PRESCRIBED BY THE DEPARTMENT OF ENVIRONMENTAL PROTECTION.

(SIGNED) *Timothy P. Roush*
TIMOTHY P. ROUSH PS 793

+ DENOTES LOCATION OF WELL ON UNITED STATES TOPOGRAPHIC MAPS.

FILE NO. _____
SCALE: 1" = 1,500'
MINIMUM DEGREE OF ACCURACY: Sub-Meter
PROVEN SOURCE OF ELEVATION: DGPS Survey



WEST VIRGINIA
Department of Environmental Protection
Office of Oil and Gas
601 57th Street
Charleston, West Virginia 25301

DATE: September 14, 2021
WELL NAME: MND1 AHS
API WELL NO.: 47-051-01810
State County Permit

WELL TYPE: OIL ___ GAS LIQUID INJECTION ___ WASTE DISPOSAL ___ (IF "GAS") PRODUCTION STORAGE ___ DEEP ___ SHALLOW

LOCATION: ELEVATION 1,150' WATERSHED Hog Run - Ohio River

10/29/2021

DISTRICT: Clay COUNTY: Marshall QUADRANGLE: Powhatan Point 7.5'

SURFACE OWNER: Marshall County Coal Resources, Inc. ACREAGE: 128.32 Ac.

OIL & GAS ROYALTY OWNER: HG Energy II Appalachia, LLC LEASE ACREAGE: 128.32 Ac. LEASE NO. _____

PROPOSED WORK: DRILL CONVERT ___ DRILL DEEPER ___ REDRILL ___ FRACTURE OR STIMULATE PLUG OFF OLD FORMATION ___

PERFORATE NEW FORMATION ___ OTHER PHYSICAL CHANGE IN WELL (SPECIFY) MOD Plat - Revised BHL and TVD

PLUG AND ABANDON ___ CLEAN OUT AND REPLUG ___ TARGET FORMATION Marcellus Shale ESTIMATED DEPTH 6,290' TVD
8,172' TMD

WELL OPERATOR: HG Energy II Appalachia, LLC
ADDRESS: 5260 DuPont Road
Parkersburg, WV 26101

DESIGNATED AGENT: Diane White
ADDRESS: 5260 DuPont Road
Parkersburg, WV 26101

6,870' to Top Hole

39° 52' 30"
5298' to Bottom Hole

80° 45' 00"

7,029' to Bottom Hole

9,129' to Top Hole

WELL: MND1 AHS Coordinates

WV SPC North (NAD 27)

SURFACE LOCATION
N - 494,217.9
E - 1,642,179.9

LANDING POINT
N - 495,763.9
E - 1,644,154.4

BOTTOM HOLE
N - 496,295.9
E - 1,643,781.9

UTM NAD 83 (mtr)

SURFACE LOCATION
N - 4,411,134.3
E - 519,309.0

BOTTOM HOLE
N - 4,411,775.5
E - 519,788.5

LAT/LONG (NAD 83)

SURFACE LOCATION
39.850009°
80.774286°

BOTTOM HOLE
39.855775°
80.768685°



Powhatan Point, OH

- NOTES ON SURVEY**
- No water supply wells or developed springs are located within 1,500' of proposed well.
 - No occupied dwellings or buildings 2500 sq. ft. or larger are located within 625' of proposed well.
 - Latitude/Longitude offset measurements are referenced to NAD 1927. Well tie lines are referenced to UTM Zone 17 North (NAD 83).
 - The location of boundary lines shown hereon are based on deed descriptions and boundary data supplied by PVE as shown on the original plats submitted with permit applications in 2015 and 2018. This plat is not intended to represent a boundary survey as defined in §23-5-2 of the W.Va. Legislative Rules.
 - Lease boundaries shown hereon are located as described in the provided Certified Title Opinions.

LEGEND

- 100 Surface Parcel No.
- ② Lease Reference No.
- Lease Boundary
- Surface Boundary
- Proposed Horizontal Lateral
- Proposed Curve Section
- Stream

North

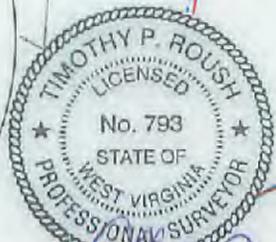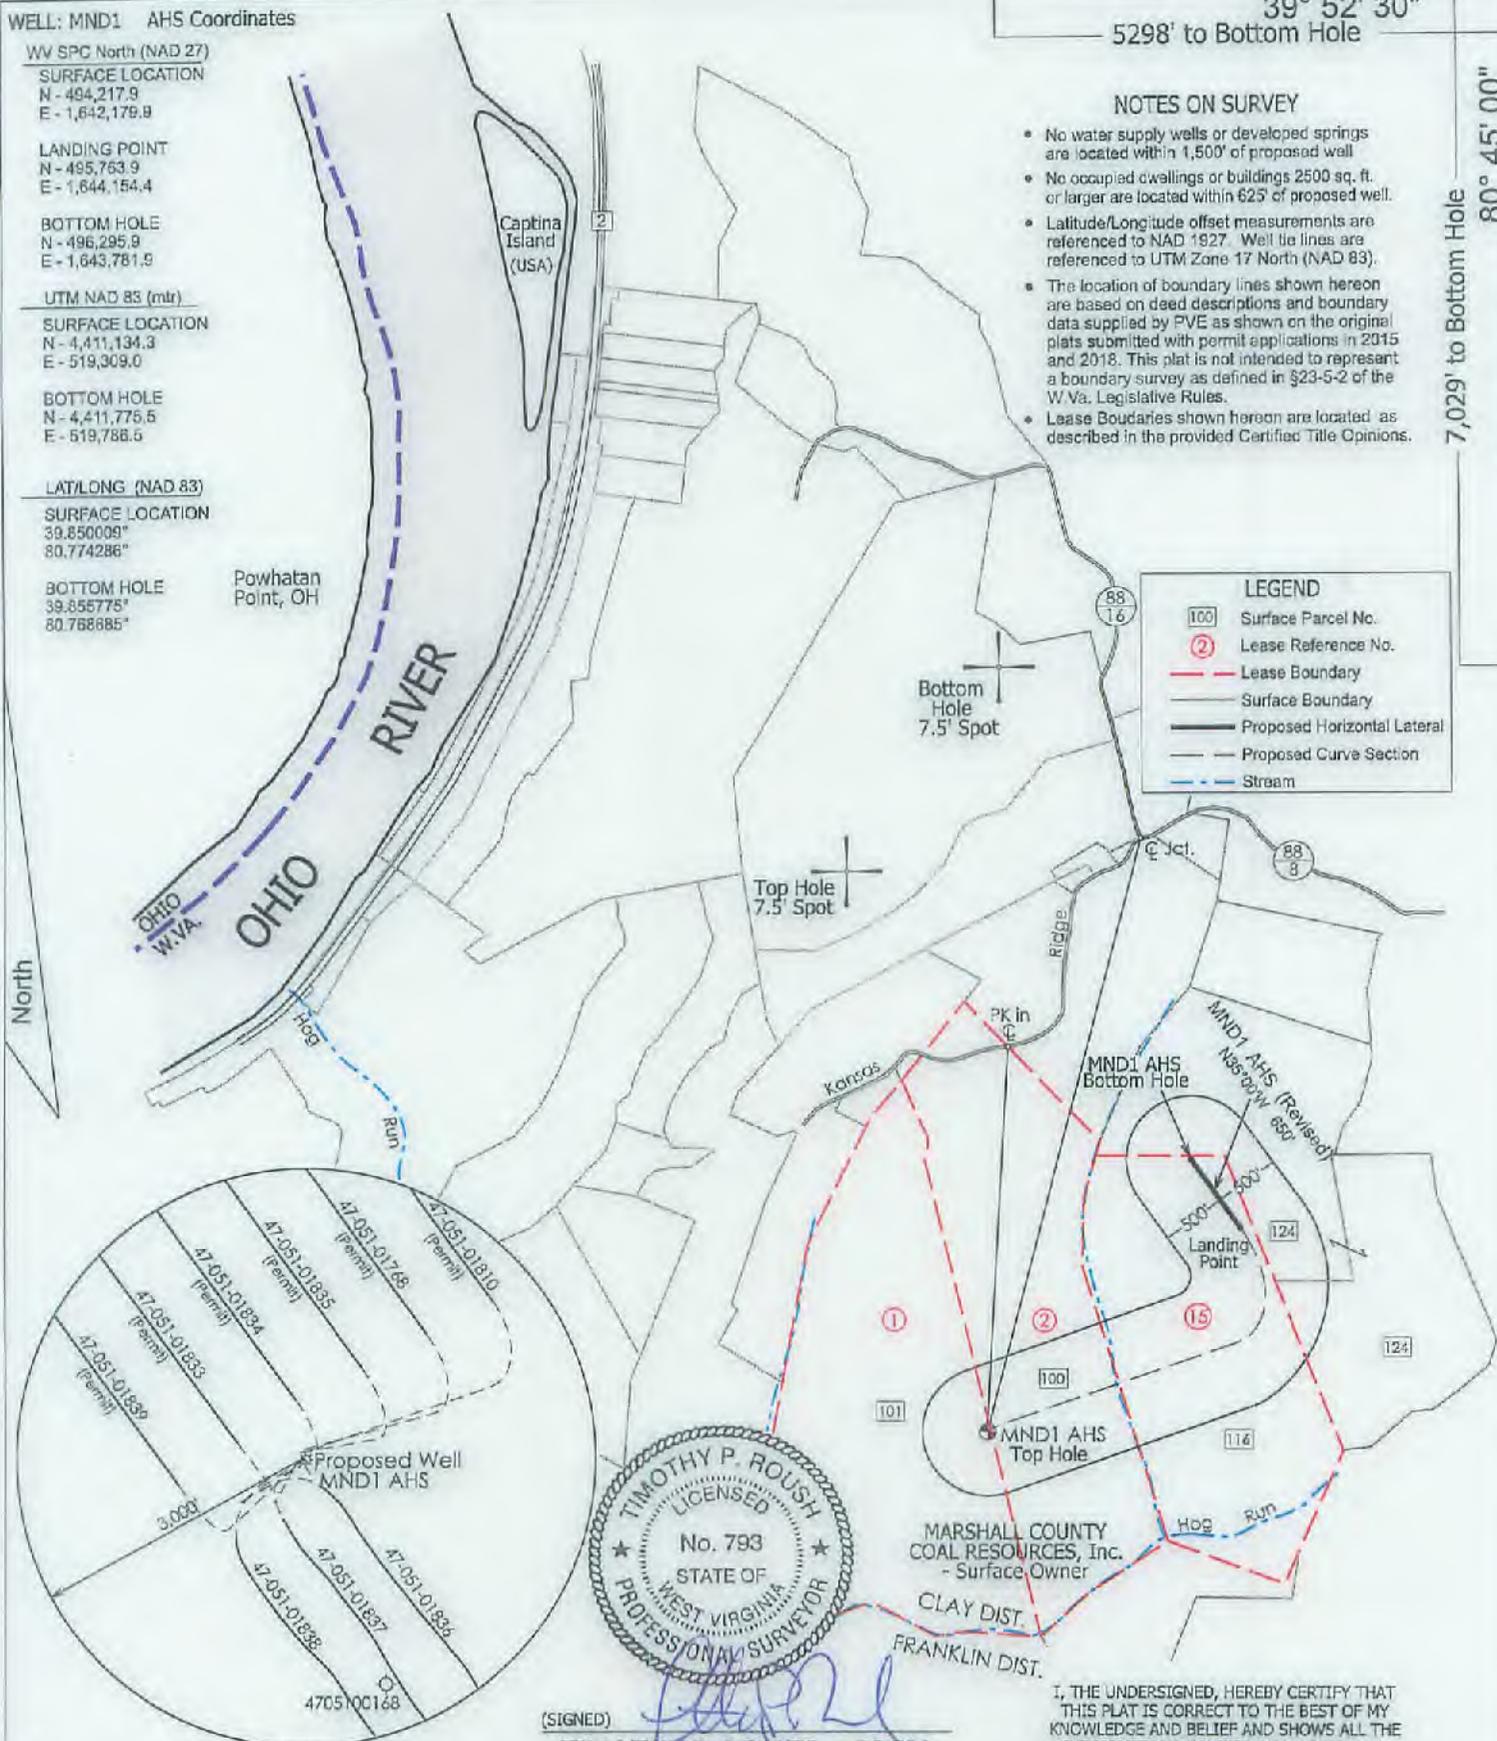

(SIGNED) *Timothy P. Roush*
TIMOTHY P. ROUSH PS 793

I, THE UNDERSIGNED, HEREBY CERTIFY THAT THIS PLAT IS CORRECT TO THE BEST OF MY KNOWLEDGE AND BELIEF AND SHOWS ALL THE INFORMATION REQUIRED BY LAW AND THE REGULATIONS ISSUED AND PRESCRIBED BY THE DEPARTMENT OF ENVIRONMENTAL PROTECTION.

— DENOTES LOCATION OF WELL ON UNITED STATES TOPOGRAPHIC MAPS.

FILE NO. _____
 SCALE: 1" = 1,500'
 MINIMUM DEGREE OF ACCURACY: Sub-Meter
 PROVEN SOURCE OF ELEVATION: DGPS Survey



WEST VIRGINIA
 Department of Environmental Protection
 Office of Oil and Gas
 601 57th Street
 Charleston, West Virginia 25301

DATE: September 14, 2021
 WELL NAME: MND1 AHS
 API WELL NO.: 47 - 051 - 01810
 State County Permit

WELL TYPE: OIL _____ GAS LIQUID INJECTION _____ WASTE DISPOSAL _____ (IF "GAS") PRODUCTION STORAGE _____ DEEP _____ SHALLOW

LOCATION: ELEVATION: 1,150' WATERSHED: Hog Run - Ohio River

DISTRICT: Clay COUNTY: Marshall QUADRANGLE: Powhatan Point 7.5'

SURFACE OWNER: Marshall County Coal Resources, Inc. ACREAGE: 128.32 Ac.

OIL & GAS ROYALTY OWNER: HG Energy II Appalachia, LLC LEASE ACREAGE: 128.32 Ac. LEASE NO. _____

PROPOSED WORK: DRILL CONVERT _____ DRILL DEEPER _____ REDRILL _____ FRACTURE OR STIMULATE PLUG OFF OLD FORMATION _____
 PERFORATE NEW FORMATION _____ OTHER PHYSICAL CHANGE IN WELL (SPECIFY) MOD Plat - Revised BHL and TVD
 PLUG AND ABANDON _____ CLEAN OUT AND REPLUG _____ TARGET FORMATION Marcellus Shale ESTIMATED DEPTH 6,290' TVD
 8,172' TMD

WELL OPERATOR: HG Energy II Appalachia, LLC DESIGNATED AGENT: Diane White
 ADDRESS: 5260 DuPont Road ADDRESS: 5260 DuPont Road
 Parkersburg, WV 26101 Parkersburg, WV 26101

10/29/2021

6,870' to Top Hole

39° 52' 30"
5298' to Bottom Hole

WELL: MND1 AHS Coordinates

WV SPC North (NAD 27)

SURFACE LOCATION
N - 494,217.9
E - 1,642,179.9

LANDING POINT
N - 495,763.9
E - 1,644,154.4

BOTTOM HOLE
N - 496,295.9
E - 1,643,781.9

UTM NAD 83 (mtr)

SURFACE LOCATION
N - 4,411,134.3
E - 519,309.0


BOTTOM HOLE
N - 4,411,775.5
E - 519,786.5

LAT/LONG (NAD 83)

SURFACE LOCATION
39.85009°
80.774286°

BOTTOM HOLE
39.855775°
80.768685°

WELL REFERENCES

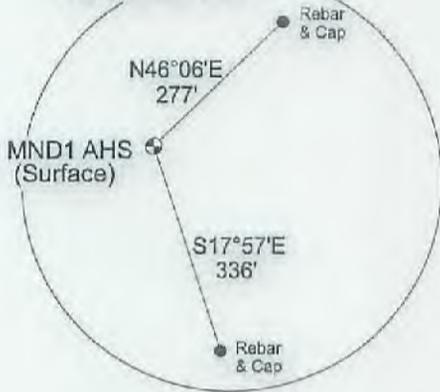

LEASE TABLE

①	HG ENERGY II APPALACHIA, LLC	TMP 04-14-10
②	HG ENERGY II APPALACHIA, LLC	TMP 04-14-09
⑬	HG ENERGY II APPALACHIA, LLC	TMP 04-14-08

7,029' to Bottom Hole
80° 45' 00"


9,129' to Top Hole



North

SURFACE PARCEL TABLE

100	Marshall County Coal Resources, Inc.	TMP 04-14-09
101	Marshall County Coal Resources, Inc.	TMP 04-14-10
116	Marshall County Coal Resources, Inc.	TMP 04-14-08
124	Eugene C. & Elizabeth A. Estap	TMP 04-13-02

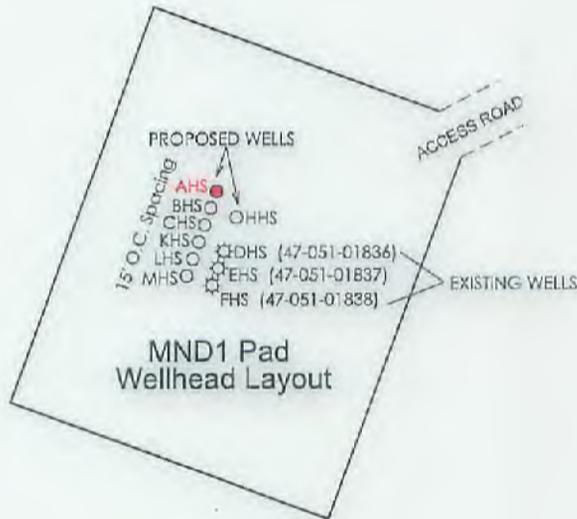

I, THE UNDERSIGNED, HEREBY CERTIFY THAT THIS PLAT IS CORRECT TO THE BEST OF MY KNOWLEDGE AND BELIEF AND SHOWS ALL THE INFORMATION REQUIRED BY LAW AND THE REGULATIONS ISSUED AND PRESCRIBED BY THE DEPARTMENT OF ENVIRONMENTAL PROTECTION.

(SIGNED)

Timothy P. Roush

TIMOTHY P. ROUSH PS 793

- DENOTES LOCATION OF WELL ON UNITED STATES TOPOGRAPHIC MAPS.

FILE NO. _____
SCALE: 1" = 1,500'
MINIMUM DEGREE OF ACCURACY: Sub-Meter
PROVEN SOURCE OF ELEVATION: DGPS Survey



WEST VIRGINIA
Department of Environmental Protection
Office of Oil and Gas
601 57th Street
Charleston, West Virginia 25301

DATE: September 14, 2021
WELL NAME: MND1 AHS
API WELL NO.: 47 - 051 - 01810
State County Permit

WELL TYPE: OIL ___ GAS LIQUID INJECTION ___ WASTE DISPOSAL ___ (IF "GAS") PRODUCTION STORAGE ___ DEEP ___ SHALLOW

LOCATION: ELEVATION 1,150' WATERSHED Hog Run - Ohio River

10/29/2021

DISTRICT: Clay COUNTY: Marshall QUADRANGLE: Powhatan Point 7.5'

SURFACE OWNER: Marshall County Coal Resources, Inc. ACREAGE: 128.32 Ac.

OIL & GAS ROYALTY OWNER: HG Energy II Appalachia, LLC LEASE ACREAGE: 128.32 Ac. LEASE NO. _____

PROPOSED WORK: DRILL CONVERT ___ DRILL DEEPER ___ REDRILL ___ FRACTURE OR STIMULATE PLUG OFF OLD FORMATION ___


PERFORATE NEW FORMATION ___ OTHER PHYSICAL CHANGE IN WELL (SPECIFY) MOD Plat - Revised BHL and TVD

PLUG AND ABANDON ___ CLEAN OUT AND REPLUG ___ TARGET FORMATION Marcellus Shale ESTIMATED DEPTH 6,290' TVD
8,172' TMD

WELL OPERATOR: HG Energy II Appalachia, LLC
ADDRESS: 5260 DuPont Road
Parkersburg, WV 26101

DESIGNATED AGENT: Diane White
ADDRESS: 5260 DuPont Road
Parkersburg, WV 26101

SUBJECT WELL
MND1 AHS

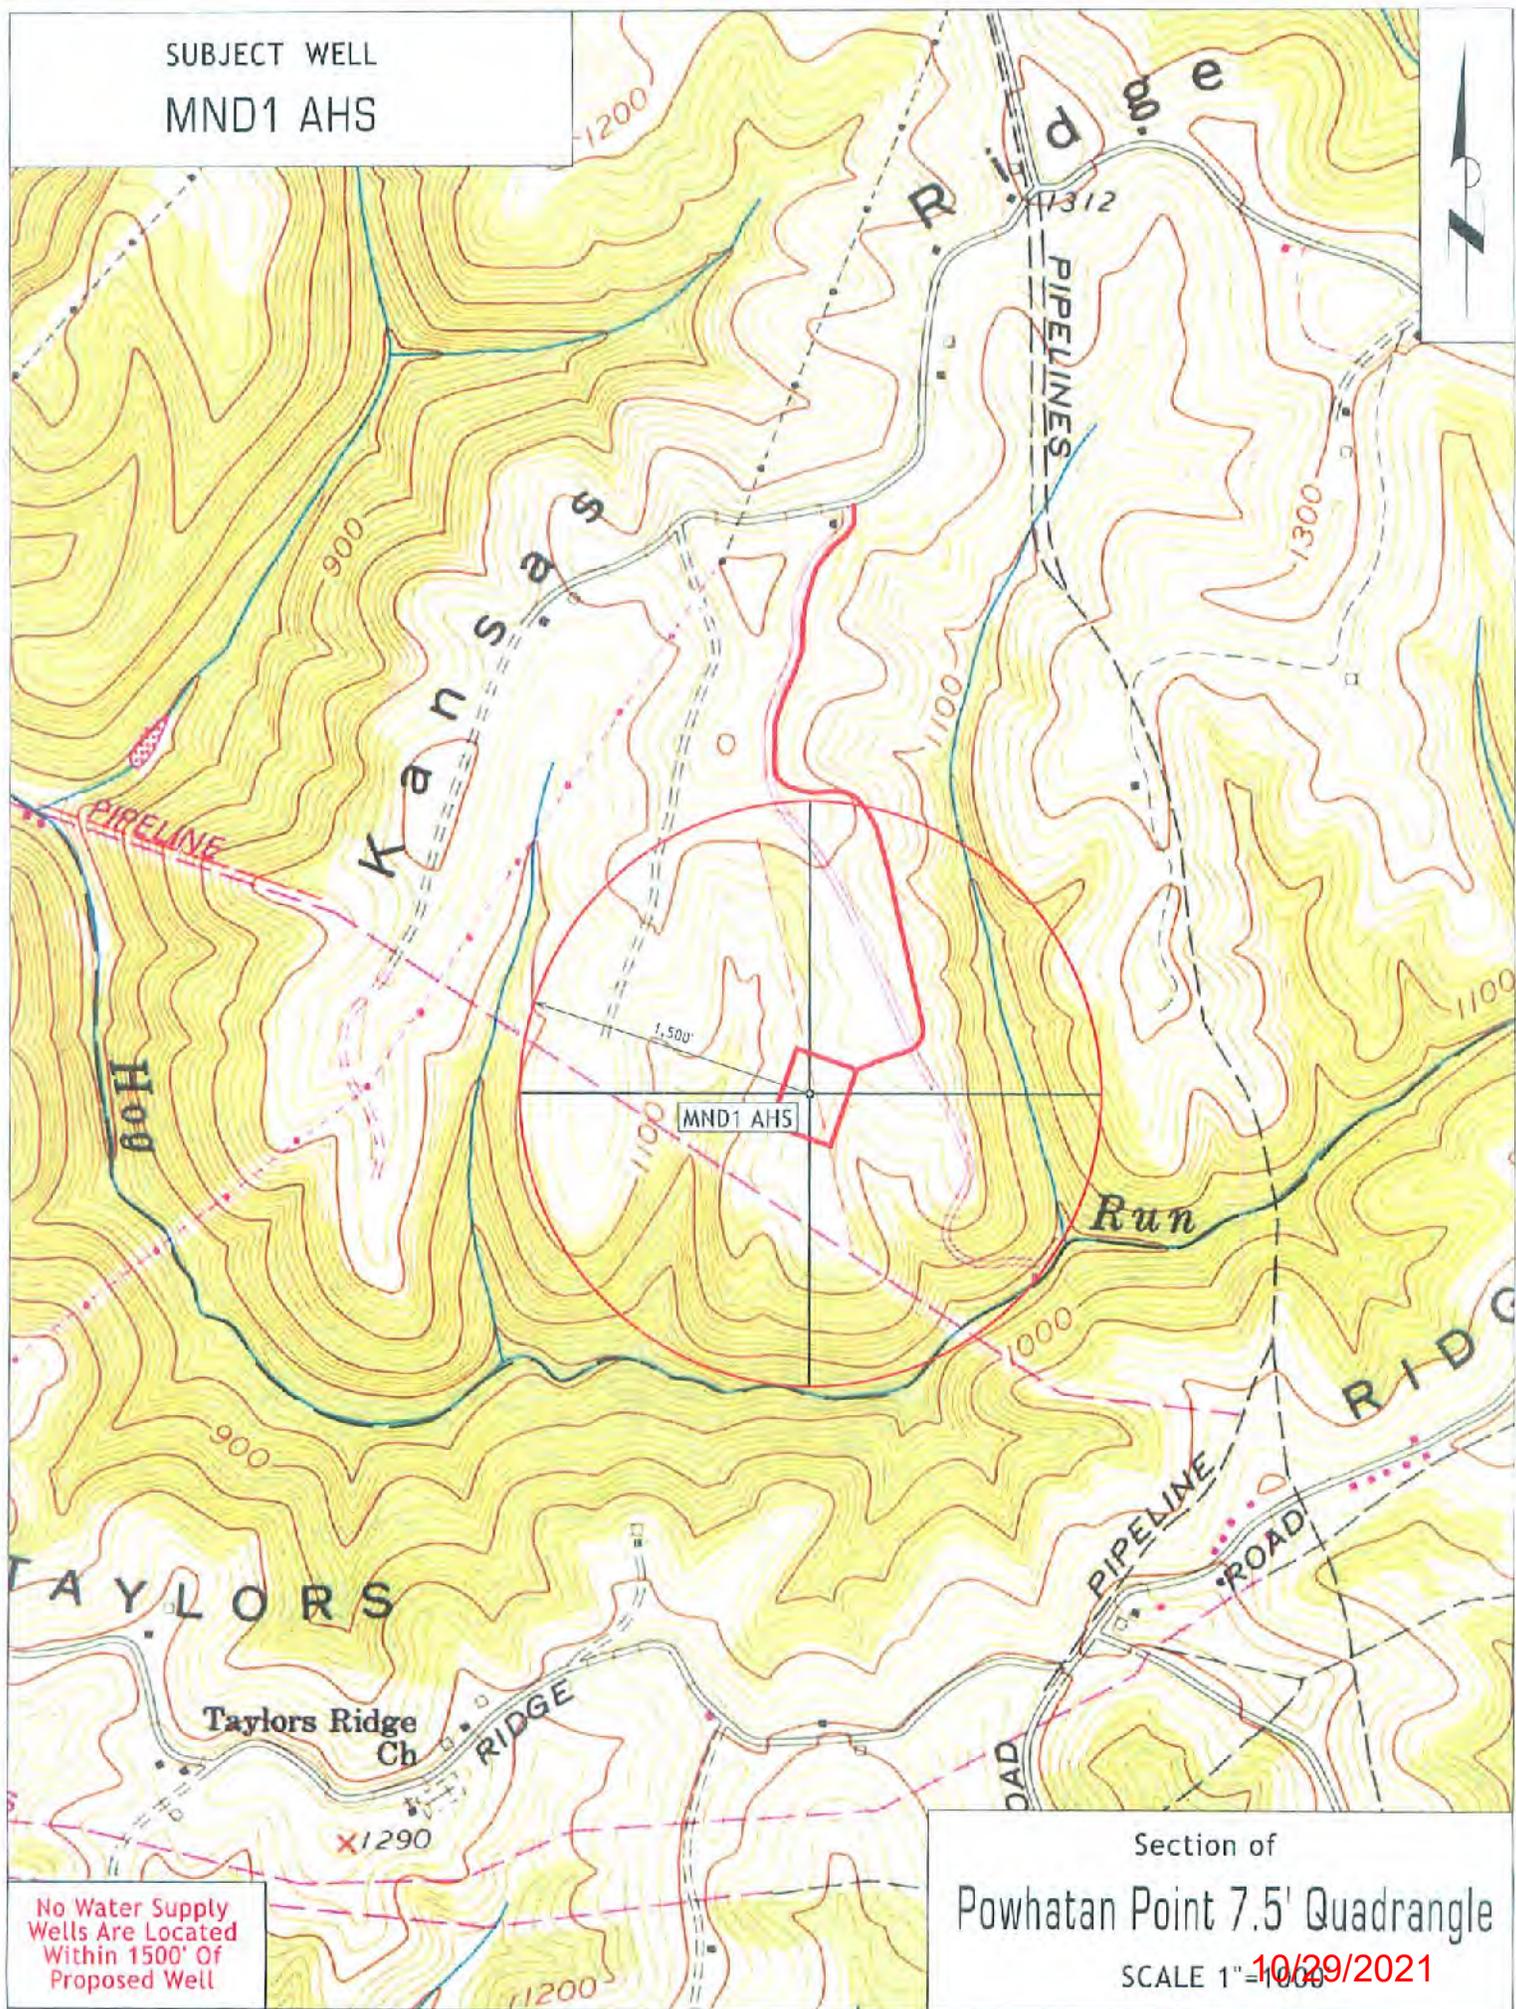

No Water Supply
Wells Are Located
Within 1500' Of
Proposed Well

Section of
Powhatan Point 7.5' Quadrangle
SCALE 1"=1000' 10/29/2021