

WW-7  
8-30-06



West Virginia Department of Environmental Protection  
Office of Oil and Gas  
**WELL LOCATION FORM: GPS**

API: 4705102069 WELL NO.: MAJ10DHSU  
FARM NAME: CNX Gas Company  
RESPONSIBLE PARTY NAME: CNX Gas Company  
COUNTY: Marshall DISTRICT: Webster  
QUADRANGLE: Majorsville  
SURFACE OWNER: CNX Gas Company  
ROYALTY OWNER: CNX Gas Company  
UTM GPS NORTHING: 4418809.40  
UTM GPS EASTING: 539573.54 GPS ELEVATION: 1317

RECEIVED  
Office of Oil and Gas  
APR 4 2022  
WV Department of  
Environmental Protection

The Responsible Party named above has chosen to submit GPS coordinates in lieu of preparing a new well location plat for a plugging permit or assigned API number on the above well. The Office of Oil and Gas will not accept GPS coordinates that do not meet the following requirements:

- Datum: NAD 1983, Zone: 17 North, Coordinate Units: meters, Altitude: height above mean sea level (MSL) – meters.
- Accuracy to Datum – 3.05 meters
- Data Collection Method:  
Survey grade GPS  : Post Processed Differential \_\_\_\_\_  
Real-Time Differential  \_\_\_\_\_  
Mapping Grade GPS \_\_\_\_\_ : Post Processed Differential \_\_\_\_\_  
Real-Time Differential \_\_\_\_\_

4. Letter size copy of the topography map showing the well location.

I the undersigned, hereby certify this data is correct to the best of my knowledge and belief and shows all the information required by law and the regulations issued and prescribed by the Office of Oil and Gas.


[Signature]  
Signature

Project Manager  
Title

4-1-22  
Date

04/15/2022

4705102069P

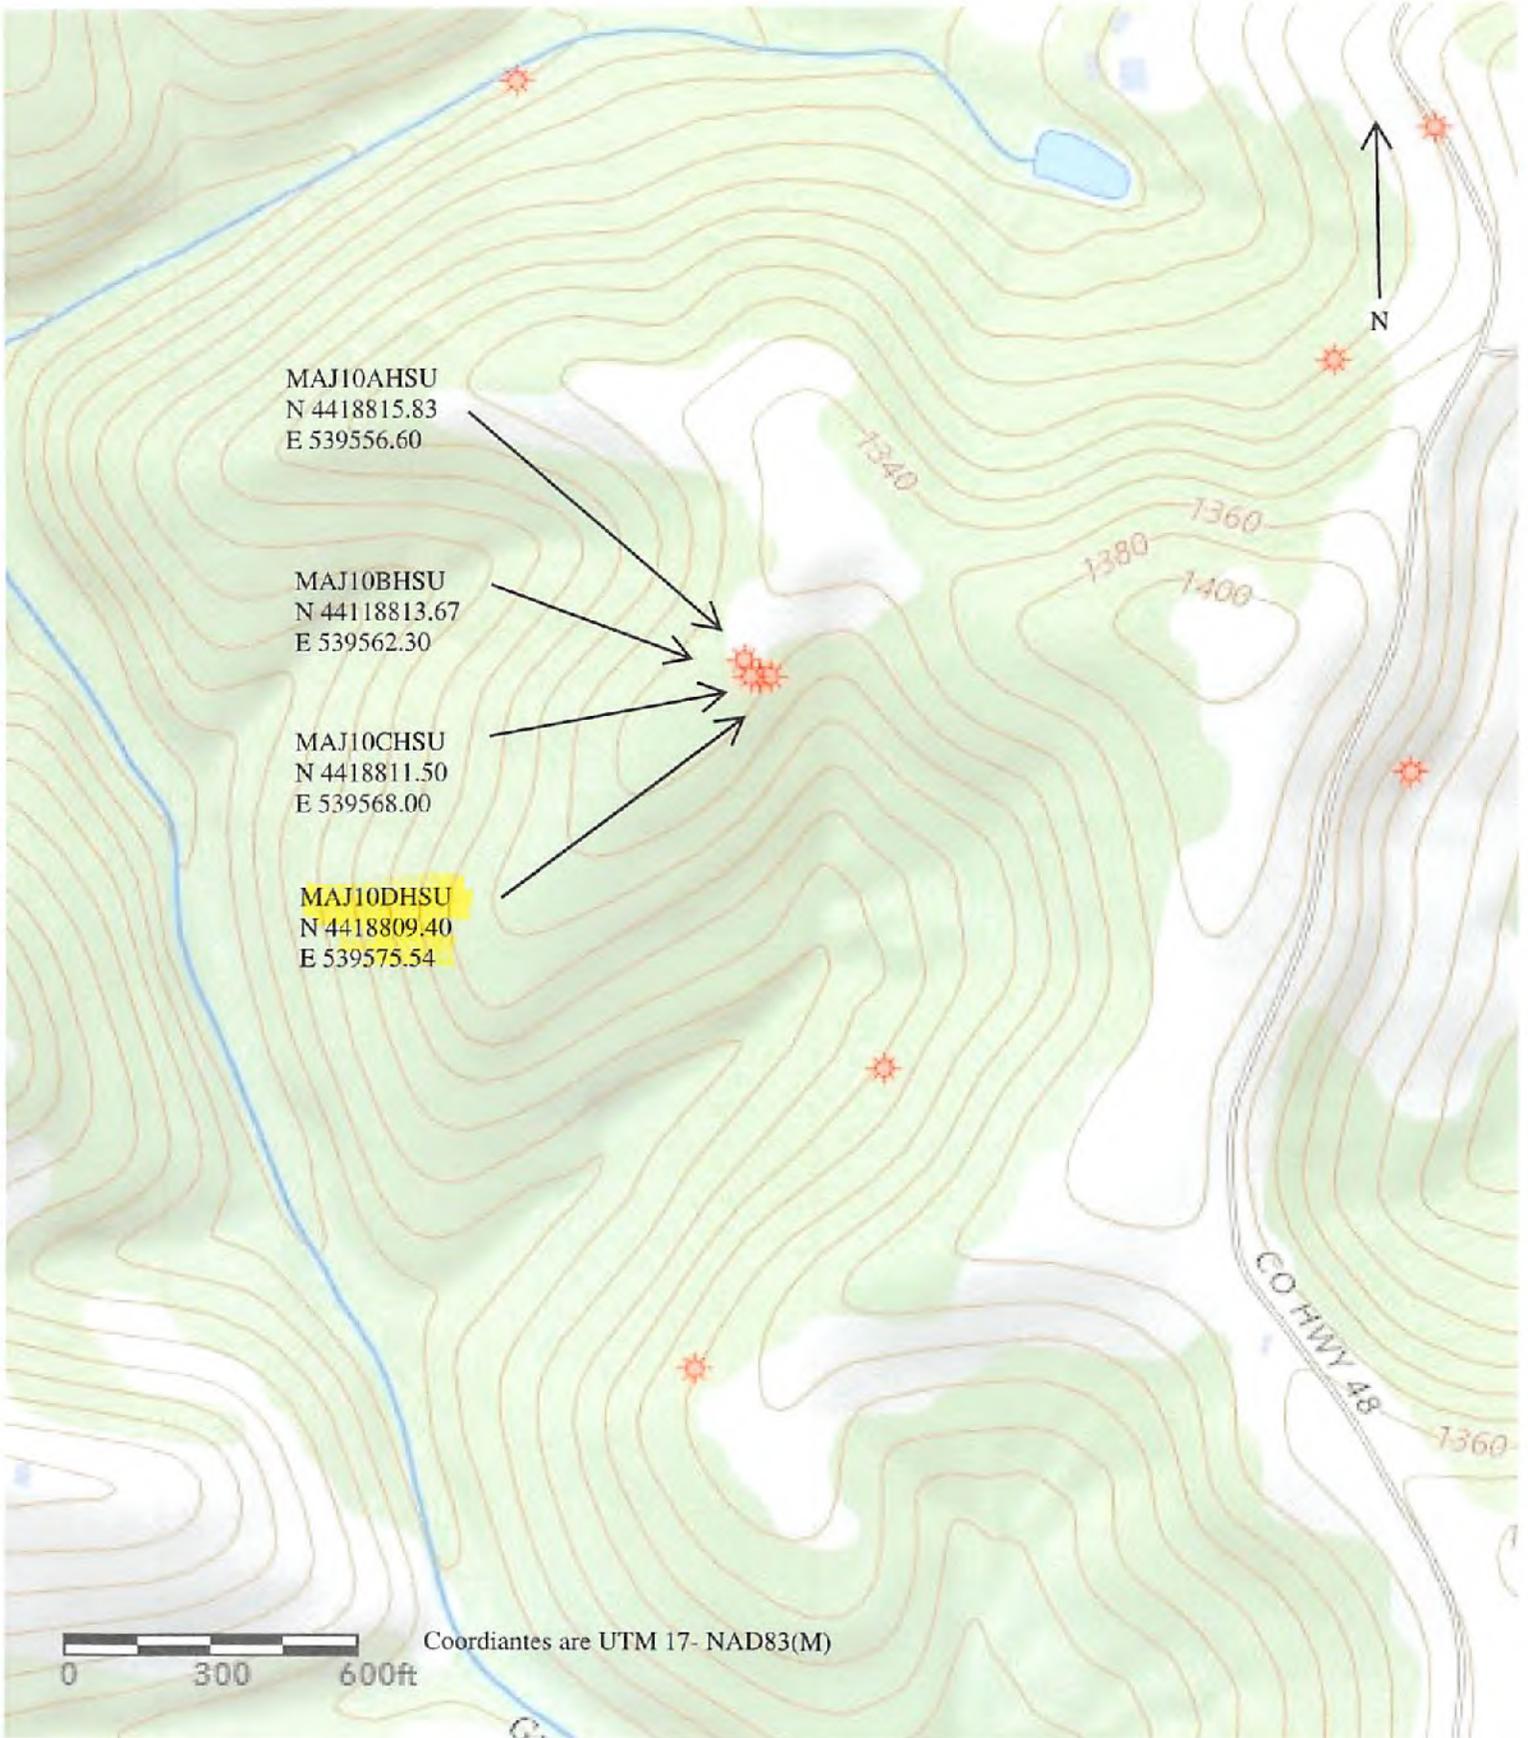

Coordiantes are UTM 17- NAD83(M)

04/15/2022