

**BRECKENRIDGE S LEASE
WELL 25HM
EQT PRODUCTION CO.**

TAG	SURFACE OWNER	PARCEL	ACRES
A	CNX LAND, LLC	3-19-76	33.25
B	CNX LAND, LLC	3-19-75	47.40
C	CNX LAND, LLC	P.O. 3-18-1	P.O. 30
D	CNX LAND, LLC	P.O. 3-18-1	P.O. 30
E	KEVIN R. EVANS	3-14-18	101.80
F	CNX LAND, LLC	3-14-19	146.875
G	CNX LAND, LLC	3-18-10	30
H	EUGENE AND RUTH EVANS ESTATES C/O TERRY EVANS	3-18-17	50.41
I	EUGENE AND RUTH EVANS ESTATES C/O TERRY EVANS	3-18-16	2.37
J	WYDOH	N.A.	2.15
K	MARSHALL COUNTY COAL RESOURCES INC	3-18-15	58.47
L	WILLIAM E. PARSONS ET UX	7-2-12	83.08
M	WILLIAM E. PARSONS ET UX	7-2-17	29.312
N	WILLIAM E. PARSONS ET UX	7-2-18	56.06
O	CNX LAND, LLC	7-2-19	54.6
P	CNX LAND, LLC	P.O. 7-2-22	P.O. 48 AC 150 P
Q	CNX LAND, LLC	3-14-17	17.08

(S.P.C. NORTH ZONE) (UTM(M) ZONE 17)

NAD83 S.P.C. (FT) N. 486,521.83 E. 1,652,052.28
NAD83 GEO. LAT. (N) 39.830299 LONG. (W) 80.626818
NAD83 UTM (M) N. 4,408,988.93 E. 531,933.48

LANDING POINT

NAD83 S.P.C. (FT) N. 486,944.0 E. 1,656,207.8
NAD83 GEO. LAT. (N) 39.831600 LONG. (W) 80.612041
NAD83 UTM (M) N. 4,409,138.7 E. 533,197.3

BOTTOM HOLE

NAD83 S.P.C. (FT) N. 478,347.6 E. 1,660,972.8
NAD83 GEO. LAT. (N) 39.808162 LONG. (W) 80.594701
NAD83 UTM (M) N. 4,406,544.0 E. 534,692.8

**AS DRILLED COORDINATES
FOR WELL NO. S-25HM**

(S.P.C. NORTH ZONE) (UTM(M) ZONE 17)

NAD83 S.P.C. (FT) N. 486,521.83 E. 1,652,052.28
NAD83 GEO. LAT. (N) 39.830299 LONG. (W) 80.626818
NAD83 UTM (M) N. 4,408,988.93 E. 531,933.48

LANDING POINT

NAD83 S.P.C. (FT) N. 486,904.5 E. 1,656,224.1
NAD83 GEO. LAT. (N) 39.831492 LONG. (W) 80.611981
NAD83 UTM (M) N. 4,409,126.7 E. 533,202.5

BOTTOM HOLE

NAD83 S.P.C. (FT) N. 478,354.1 E. 1,660,972.8
NAD83 GEO. LAT. (N) 39.808160 LONG. (W) 80.594688
NAD83 UTM (M) N. 4,406,546.0 E. 534,694.0

RECEIVED
Office of Oil and Gas

JUL 16 2025

WV Department of
Environmental Protection

LINE	BEARING	DISTANCE
L1	N 10°34' W	8.66'
L2	N 79°37' E	2423.61'
L3	S 08°39' W	1279.65'


CURVE	RADIUS	ARC LENGTH	CHORD LENGTH	CHORD BEARING
C1	1317.32'	256.05'	255.65'	N 64°07' E
C2	1096.70'	330.69'	329.43'	N 68°15' E
C3	13900.59'	657.65'	657.59'	N 78°58' E
C4	422.54'	290.43'	284.74'	S 78°30' E
C5	840.39'	456.99'	451.38'	S 43°50' E



12 Vannoy Drive | P.O. Box 150 | Glenville, WV 26031 | 804.482.5654
1412 Kanawha Boulevard, East | Charleston, WV 25301 | 804.246.3952
254 East Beckley Bypass | Beckley, WV 25801 | 804.255.5296
www.sls.com

NOTES ON SURVEY

- NO WATER WELLS WERE FOUND WITHIN 250' OF PROPOSED GAS WELL. NO AGRICULTURAL BUILDINGS > 2500 SQ. FT. WERE FOUND WITHIN 625' OF THE CENTER OF PROPOSED WELL PAD.
- SEE REFERENCES FOR DWELLINGS LOCATED WITHIN 625' OF THE CENTER OF PROPOSED WELL PAD.
- PLAT UPDATED TO SHOW AS-DRILLED PATH. AS-DRILLED DATA PROVIDED BY EQT PRODUCTION CO.

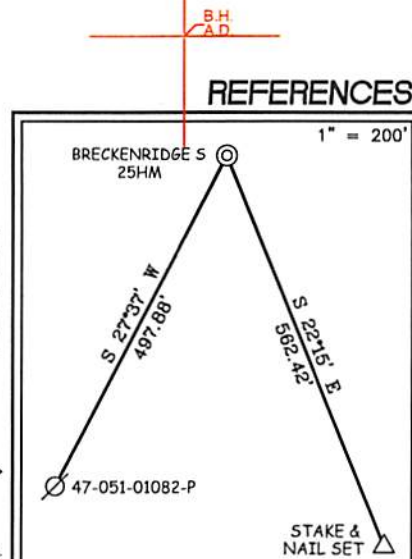

I THE UNDERSIGNED, HEREBY CERTIFY THAT THIS PLAT IS CORRECT TO THE BEST OF MY KNOWLEDGE AND BELIEF AND SHOWS ALL THE INFORMATION REQUIRED BY LAW AND THE REGULATIONS ISSUED AND PRESCRIBED BY THE DIVISION OF ENVIRONMENTAL PROTECTION.

P.S.
677 Gregory A. Smith



(+) DENOTES LOCATION OF WELL ON UNITED STATES TOPOGRAPHIC MAPS

DATE OCTOBER 9, 20 24

REVISED DECEMBER 11, 20 24

OPERATORS WELL NO. BRECKENRIDGE S-25HM

API WELL NO. 47-051-02432
STATE COUNTY PERMIT

MINIMUM DEGREE OF ACCURACY 1 / 2500 FILE NO. 9026EQT-P25HMR7 AD.dwg

HORIZONTAL & VERTICAL SCALE 1" = 2000'
CONTROL DETERMINED BY: DGPS (SURVEY GRADE TIE TO CORS NETWORK)

STATE OF WEST VIRGINIA
DIVISION OF ENVIRONMENTAL PROTECTION
OFFICE OF OIL AND GAS



WELL TYPE: OIL GAS LIQUID WASTE IF
INJECTION DISPOSAL "GAS" PRODUCTION STORAGE DEEP SHALLOW

LOCATION :

ELEVATION 1,370.61' WATERSHED GRAVE CREEK (HUC 10) & LAUREL RUN
DISTRICT CAMERON COUNTY MARSHALL QUADRANGLE GLEN EASTON 7.5'

SURFACE OWNER CNX LAND LLC

ACREAGE 53.25±

ROYALTY OWNER COUNTRY ROADS MINERALS, LLC, ET AL

ACREAGE 53.25±

PROPOSED WORK :

LEASE NO. SEE WW-6A1

DRILL X CONVERT DRILL DEEPER REDRILL FRACTURE OR STIMULATE X PLUG OFF OLD
FORMATION PERFORATE NEW FORMATION PLUG AND ABANDON CLEAN OUT AND REPLUG OTHER

PHYSICAL CHANGE IN WELL (SPECIFY) TARGET FORMATION MARCELLUS

ESTIMATED DEPTH TVD: 6,977' / TMD: 18,604'

WELL OPERATOR EQT PRODUCTION COMPANY
ADDRESS 400 WOODCLIFF DRIVE
CANONSBURG, PA 15317


DESIGNATED AGENT JOSEPH C. MALLOW
ADDRESS 427 MIDSTATE DRIVE
CLARKSBURG, WV 26301

12/19/2025

**BRECKENRIDGE S LEASE
WELL 25HM
EQT PRODUCTION CO.**

T.H. LATITUDE 39°50'00"
B.H. LATITUDE 39°50'00"

T.H. LONGITUDE 80°37'30"
B.H. LONGITUDE 80°35'00"

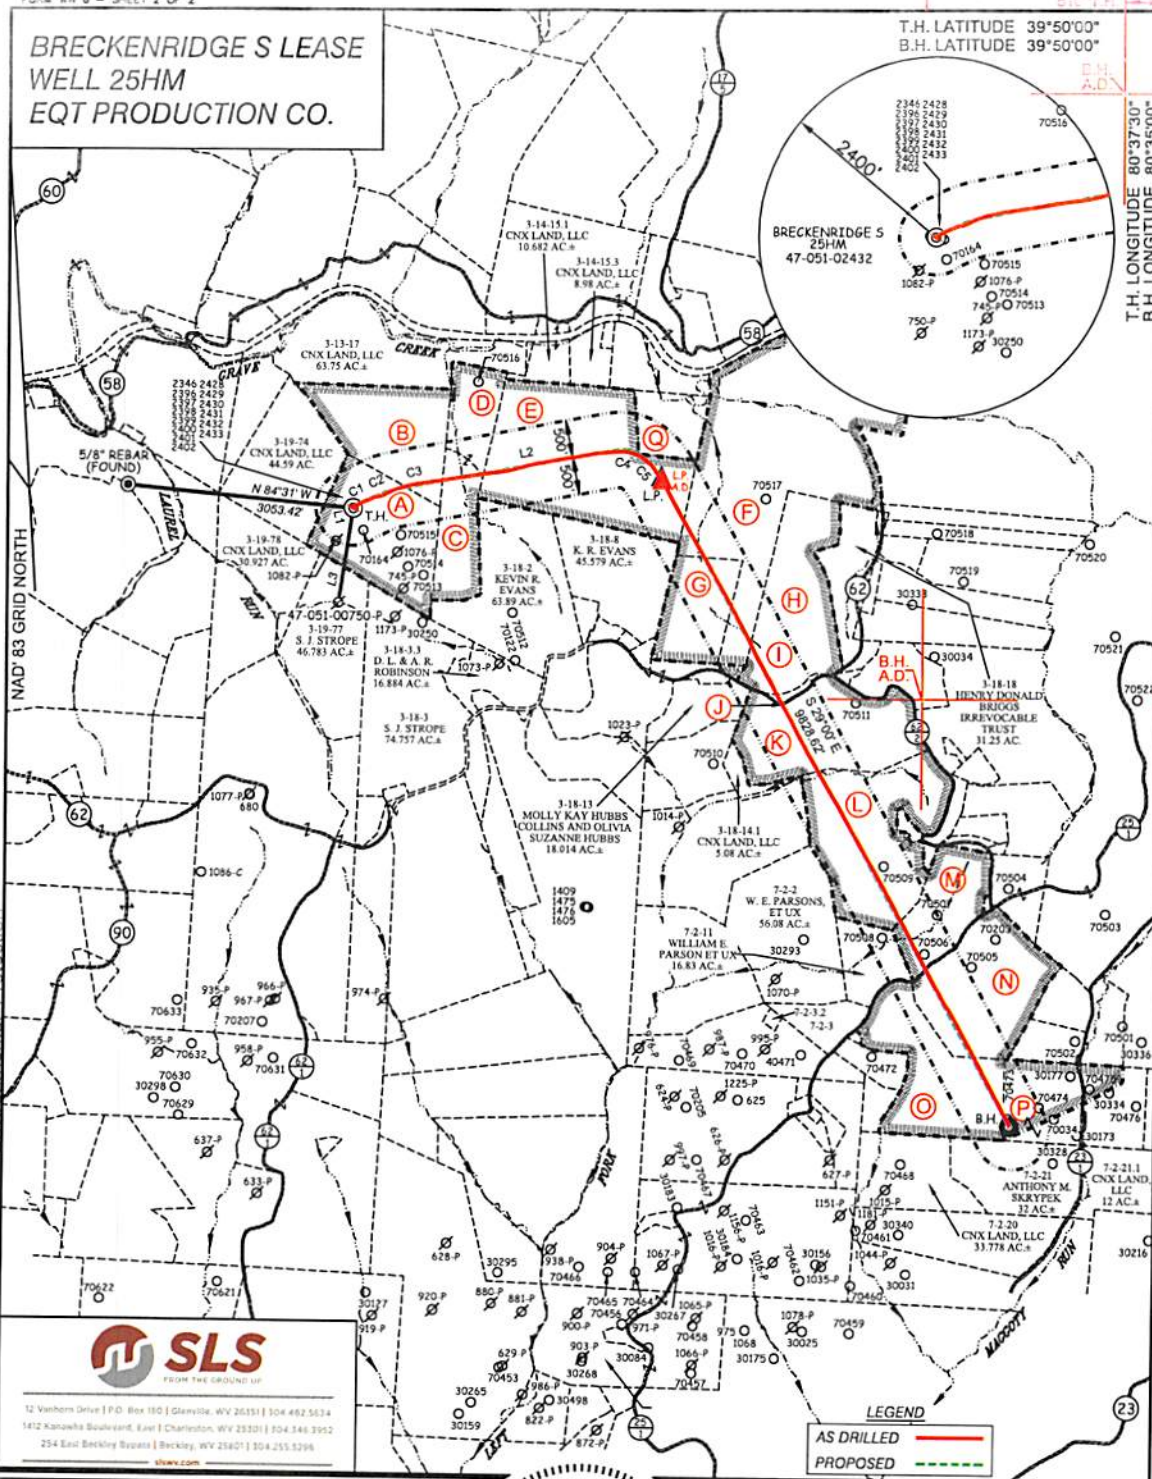

RECEIVED
Office of Oil and Gas

JUL 16 2025

WV Department of
Environmental Protection



12 Vanhorn Drive | P.O. Box 180 | Glenville, WV 26031 | 304.462.5634
1412 Kanawha Boulevard, East | Charleston, WV 25301 | 304.346.3902
254 East Beckley Square | Beckley, WV 25801 | 304.255.5296
sls.com

(S.P.C. NORTH ZONE) (UTM(M) ZONE 17)
NAD83 S.P.C.(FT) N. 486,521.83 E. 1,652,052.28
NAD83 GEO. LAT-(N) 39.830299 LONG-(W) 80.626818
NAD83 UTM (M) N. 4,408,988.93 E. 531,933.48
LANDING POINT
NAD83 S.P.C.(FT) N. 486,944.0 E. 1,656,207.8
NAD83 GEO. LAT-(N) 39.831600 LONG-(W) 80.612041
NAD83 UTM (M) N. 4,409,138.7 E. 533,197.3
BOTTOM HOLE
NAD83 S.P.C.(FT) N. 478,347.6 E. 1,660,972.8
NAD83 GEO. LAT-(N) 39.808162 LONG-(W) 80.594701
NAD83 UTM (M) N. 4,406,544.0 E. 534,692.8

SCALE 1" = 2000' FILE NO. 9026EQT-P25H-MR7 AD.dwg

DATE OCTOBER 9, 20 24


REVISED DECEMBER 9, 20 24

OPERATORS WELL NO. BRECKENRIDGE S-25HM

API WELL 47-051-02432

NO. STATE COUNTY PERMIT

WELL OPERATOR EQT PRODUCTION COMPANY
ADDRESS 400 WOODCLIFF DRIVE
CANONSBURG, PA 15317

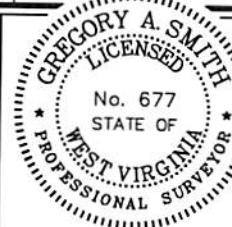

STATE OF WEST VIRGINIA
DIVISION OF
ENVIRONMENTAL PROTECTION
OFFICE OF OIL AND GAS



(+) DENOTES LOCATION OF WELL ON UNITED STATES TOPOGRAPHIC MAPS

P.S. 677 Gregory A. Smith

LEGEND

LEASE LINE
SURFACE LINE
WELL LATERAL
OFFSET LINE
TIE LINE
CREEK
ROAD
COUNTY ROUTE
PROPOSED WELL
EXISTING WELL
PERMITTED WELL
TAX MAP-PARCEL
SURFACE OWNER (SEE TABLE)
LEASE # (SEE WW-6A1)

COUNTY NAME PERMIT

DESIGNATED AGENT JOSEPH C. MALLOW

ADDRESS 427 MIDSTATE DRIVE
CLARKSBURG, WV 26301

12/19/2025