

BRECKENRIDGE S LEASE WELL 26HM EQT PRODUCTION CO.

LINE	BEARING	DISTANCE
L1	S 68°01' E	180.53'
L2	N 50°34' E	3416.27'
L3	S 18°51' E	210.20'
L4	S 21°15' E	447.75'
L5	S 09°11' W	1278.61'

T.H. LATITUDE 39°50'00"
B.H. LATITUDE 39°50'00"

TAG	SURFACE OWNER	PARCEL	ACRES
A	CNX LAND, LLC	3-19-76	53.25
B	CNX LAND, LLC	3-19-75	47.40
C	CNX LAND, LLC	P/O 3-18-1	P/O 30
D	CNX LAND, LLC	P/O 3-18-1	P/O 30
E	KEVIN R. EVANS	3-14-18	101.80
F	CNX LAND, LLC	3-14-15.1	10.682
G	CNX LAND, LLC	3-14-15.3	8.98
H	CNX LAND, LLC	3-14-15.2	1.15
I	CNX LAND, LLC	3-14-15	11.21
J	CNX LAND, LLC	3-14-16	6.7
K	CNX LAND, LLC	3-13-18	82.47
L	CHELSIE N & JOHN J DEANGELO	3-14-13	31.887
M	CNX LAND, LLC	3-14-17	17.08
N	CNX LAND, LLC	3-14-19	146.875
O	EUGENE AND RUTH EVANS ESTATES C/O TERRY EVANS	3-18-17	50.41
P	HENRY DONALD BRIGGS IRREVOCABLE TRUST	3-18-18	31.25
Q	EUGENE AND RUTH EVANS ESTATES C/O TERRY EVANS	3-18-22	44.50
R	MOLLY KAY HUBBS ET AL	3-18-21.1	1.45
S	MOLLY KAY HUBBS COLLINS AND OLIVIA SUZANNE HUBBS	3-18-21	17.042
T	MARSHALL COUNTY COAL RESOURCES INC	3-18-15	58.47
U	WILLIAM E. PARSONS ET UX	7-2-12	83.08
V	GATHIA M. CECIL	P/O 7-2-14.3	3.898
W	WV DOI	N/A	2.15
X	LAIKEN JANELEE BOYD	7-2-14.4	5
Y	WILLIAM E. PARSONS ET UX	7-2-17	29.312
Z	WILLIAM E. PARSONS ET UX	7-2-18	56.06
AA	CNX LAND, LLC	7-2-24	10.21
BB	CNX LAND, LLC	7-2-23	10.48
CC	CNX LAND, LLC	P/O 7-2-22	P/O 48 AC 150 P
DD	CNX LAND, LLC	7-2-14.2	2.321

(S.P.C. NORTH ZONE) (UTM(M) ZONE 17)

NAD83 S.P.C.(FT) N. 486,518.95 E. 1,652,063.93
NAD83 GEO. LAT.(N) 39.830291 LONG.(W) 80.626776
NAD83 UTM (M) N. 4,408,988.11 E. 531,937.04

LANDING POINT

NAD83 S.P.C.(FT) N. 488,529.7 E. 1,656,472.1
NAD83 GEO. LAT.(N) 39.835962 LONG.(W) 80.611170
NAD83 UTM (M) N. 4,409,623.2 E. 533,269.8

BOTTOM HOLE

NAD83 S.P.C.(FT) N. 478,762.6 E. 1,661,886.1
NAD83 GEO. LAT.(N) 39.809332 LONG.(W) 80.591469
NAD83 UTM (M) N. 4,406,675.1 E. 534,968.9

AS DRILLED COORDINATES FOR WELL NO. S-26HM

(S.P.C. NORTH ZONE) (UTM(M) ZONE 17)

NAD83 S.P.C.(FT) N. 486,518.95 E. 1,652,063.93
NAD83 GEO. LAT.(N) 39.830291 LONG.(W) 80.626776
NAD83 UTM (M) N. 4,408,988.11 E. 531,937.04

LANDING POINT

NAD83 S.P.C.(FT) N. 488,529.7 E. 1,656,472.1
NAD83 GEO. LAT.(N) 39.835962 LONG.(W) 80.611170
NAD83 UTM (M) N. 4,409,623.2 E. 533,269.8

BOTTOM HOLE

NAD83 S.P.C.(FT) N. 478,762.6 E. 1,661,886.1
NAD83 GEO. LAT.(N) 39.809332 LONG.(W) 80.591469
NAD83 UTM (M) N. 4,406,675.1 E. 534,968.9

REFERENCES


CURVE	RADIUS	ARC LENGTH	CHORD LENGTH	CHORD BEARING
C1	83.51'	83.65'	80.20'	S 36°29' E
C2	260.67'	147.15'	145.20'	S 76°38' E
C3	644.13'	277.30'	275.16'	N 72°55' E
C4	1728.59'	331.91'	331.40'	N 56°09' E
C5	591.61'	766.00'	713.61'	S 87°59' E
C6	774.61'	271.81'	270.42'	S 40°33' E
C7	1906.88'	506.27'	504.78'	S 36°36' E
C8	1913.79'	868.98'	861.53'	S 31°52' E
C9	1911.90'	79.89'	79.89'	S 20°03' E
C10	1911.35'	270.95'	270.72'	S 25°18' E

NOTES ON SURVEY

- NO WATER WELLS WERE FOUND WITHIN 250' OF PROPOSED GAS WELL. NO AGRICULTURAL BUILDINGS > 2500 SQ. FT. WERE FOUND WITHIN 625' OF THE CENTER OF PROPOSED WELL PAD.
- WELL SPOT CIRCLE & TOPO MARK SCALE IS 1"=2000'
- PLAT UPDATED TO SHOW AS-DRILLED PATH. AS-DRILLED DATA PROVIDED BY EQT PRODUCTION CO.




12 Vantage Drive | P.O. Box 151 | Glenview, WV 26031 | 804.462.5434
1412 Kanawha Boulevard, East | Charleston, WV 25301 | 804.546.5952
254 East Beckley Bypass | Beckley, WV 25801 | 804.255.6296
sls.com

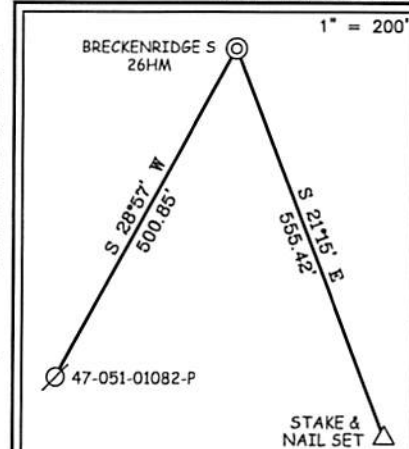

I THE UNDERSIGNED, HEREBY CERTIFY THAT THIS PLAT IS CORRECT TO THE BEST OF MY KNOWLEDGE AND BELIEF AND SHOWS ALL THE INFORMATION REQUIRED BY LAW AND THE REGULATIONS ISSUED AND PRESCRIBED BY THE DIVISION OF ENVIRONMENTAL PROTECTION.

P.S.
677

Gregory A. Smith

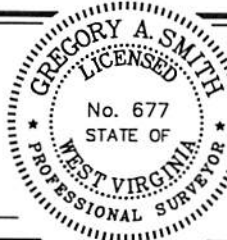

(+) DENOTES LOCATION OF WELL ON UNITED STATES TOPOGRAPHIC MAPS

DATE OCTOBER 9, 20 24

REVISED DECEMBER 23, 20 24

OPERATORS WELL NO. BRECKENRIDGE S-26HM

API WELL NO. 47 - 051 - 02433

STATE COUNTY PERMIT

MINIMUM DEGREE OF ACCURACY 1 / 2500 FILE NO. 9026EQT-P26HMR7 AD.dwg

HORIZONTAL & VERTICAL SCALE 1" = 2000'
CONTROL DETERMINED BY: DGPS (SURVEY GRADE TIE TO CORS NETWORK)

STATE OF WEST VIRGINIA
DIVISION OF ENVIRONMENTAL PROTECTION
OFFICE OF OIL AND GAS



WELL TYPE: OIL GAS ☒ LIQUID INJECTION ☐ WASTE DISPOSAL ☐ IF "GAS" PRODUCTION ☒ STORAGE ☐ DEEP ☐ SHALLOW ☒

LOCATION:

ELEVATION 1,370.61' WATERSHED GRAVE CREEK (HUC 10) & LAUREL RUN

DISTRICT CAMERON COUNTY MARSHALL QUADRANGLE GLEN EASTON 7.5'

SURFACE OWNER CNX LAND LLC

ACREAGE 53.25±

ROYALTY OWNER COUNTRY ROADS MINERALS, LLC, ET AL

ACREAGE 53.25±

PROPOSED WORK:

LEASE NO. SEE WW-6A1

DRILL ☒ CONVERT ☐ DRILL DEEPER ☐ REDRILL ☐ FRACTURE OR STIMULATE ☒ PLUG OFF OLD

FORMATION PERFORATE NEW FORMATION ☐ PLUG AND ABANDON ☐ CLEAN CUT AND REPLUG ☐ OTHER ☐

PHYSICAL CHANGE IN WELL (SPECIFY) TARGET FORMATION MARCELLUS

ESTIMATED DEPTH TVD: 6,977' / TMD: 21,265'

WELL OPERATOR EQT PRODUCTION COMPANY
ADDRESS 400 WOODCLIFF DRIVE
CANONSBURG, PA 15317


DESIGNATED AGENT JOSEPH C. MALLOW
ADDRESS 427 MIDSTATE DRIVE
CLARKSBURG, WV 26301

12/19/2025

COUNTY NAME PERMIT

RECEIVED
Office of Oil and Gas
JUL 16 2025
WV Department of
Environmental Protection

**BRECKENRIDGE S LEASE
WELL 26HM
EQT PRODUCTION CO.**

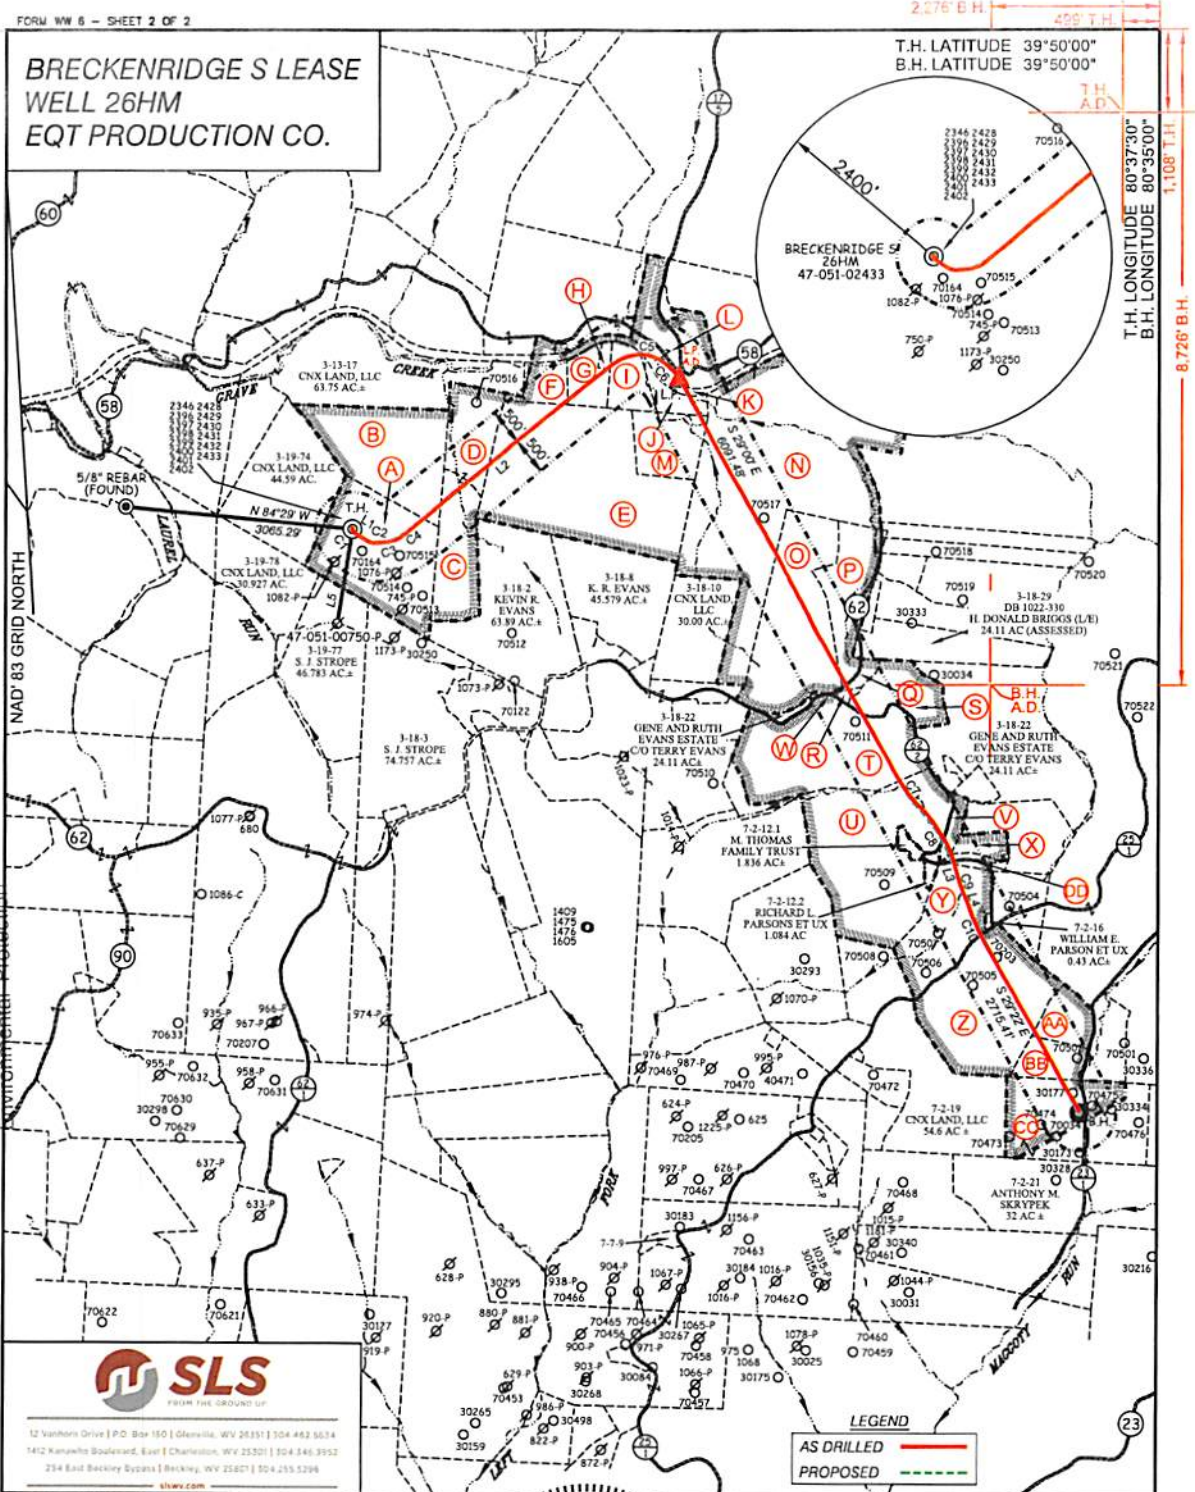

12 Vashon Drive | P.O. Box 180 | Glenville, WV 26031 | 304.483.5634
1412 Kanawha Boulevard, East | Charleston, WV 25301 | 304.346.9952
234 East Beckley Square | Beckley, WV 26027 | 304.253.5296
www.sls.com

(S.P.C. NORTH ZONE) (UTM(M) ZONE 17)
NAD83 S.P.C.(FT) N. 486,518.95 E. 1,652,063.93
NAD83 GEO. LAT-(N) 39.830291 LONG-(W) 80.626776
NAD83 UTM (M) N. 4,408,988.11 E. 531,937.04
LANDING POINT
NAD83 S.P.C.(FT) N. 488,529.7 E. 1,656,472.1
NAD83 GEO. LAT-(N) 39.835962 LONG-(W) 80.611170
NAD83 UTM (M) N. 4,409,623.2 E. 533,269.8
BOTTOM HOLE
NAD83 S.P.C.(FT) N. 478,762.6 E. 1,661,886.1
NAD83 GEO. LAT-(N) 39.809332 LONG-(W) 80.591469
NAD83 UTM (M) N. 4,406,675.1 E. 534,968.9

SCALE 1" = 2000' FILE NO. 9026EQT-P26HMR7 AD.dwg

DATE OCTOBER 9, 20 24
REVISED DECEMBER 23, 20 24
OPERATORS WELL NO. BRECKENRIDGE S-26HM
API WELL NO. 47-051-02433
STATE COUNTY PERMIT

WELL OPERATOR EQT PRODUCTION COMPANY
ADDRESS 400 WOODCLIFF DRIVE
CANONSBURG, PA 15317



STATE OF WEST VIRGINIA
DIVISION OF
ENVIRONMENTAL PROTECTION
OFFICE OF OIL AND GAS



(+) DENOTES LOCATION OF WELL ON UNITED STATES TOPOGRAPHIC MAPS

P.S. Gregory A. Smith
677

LEGEND

LEASE LINE
SURFACE LINE
WELL LATERAL
OFFSET LINE
TIE LINE
CREEK
ROAD
COUNTY ROUTE
PROPOSED WELL
EXISTING WELL
PERMITTED WELL
TAX MAP-PARCEL
SURFACE OWNER (SEE TABLE)
LEASE # (SEE WW-6A1)

COUNTY NAME PERMIT

12/19/2025