

Latitude: 40°00'00"

SURFACE HOLE 10,242'


Latitude: 39°57'30"

BOTTOM HOLE 7,268'

JACKSON SURVEYING INC.




2413 EAST PIKE ST. # 112
Clarksburg, WV 26302
304-623-5851

SURFACE HOLE LOCATION (SHL):
UTM (NAD83, ZONE 17, METERS): NORTHING: 4,427,007.356 EASTING: 528,892.356
LANDING POINT LOCATION (LPL):
UTM (NAD83, ZONE 17, METERS): NORTHING: 4,426,628.705 EASTING: 528,086.018
AZIMUTH POINT LOCATION (AZL1):
UTM (NAD83, ZONE 17, METERS): NORTHING: 4,426,066.049 EASTING: 528,285.181
BOTTOM HOLE LOCATION (BHL):
UTM (NAD83, ZONE 17, METERS): NORTHING: 4,421,728.136 EASTING: 529,820.230

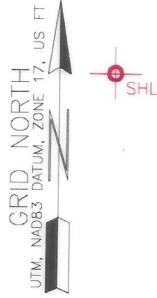

SURFACE HOLE LOCATION (SHL):
UTM (NAD83, ZONE 17, METERS): NORTHING: 4,427,007.318 EASTING: 528,892.239
LANDING POINT LOCATION (LPL):
UTM (NAD83, ZONE 17, METERS): NORTHING: 4,426,634.720 EASTING: 528,087.303
AZIMUTH POINT LOCATION (AZL1):
UTM (NAD83, ZONE 17, METERS): NORTHING: 4,426,079.526 EASTING: 528,284.927
BOTTOM HOLE LOCATION (BHL):
UTM (NAD83, ZONE 17, METERS): NORTHING: 4,421,726.251 EASTING: 529,820.683

LINE	BEARING	DISTANCE	DESCRIPTION	MONUMENT
L1	N 17°10'37" W	1,063.88'	SHL TO LANDMARK	FD. FENCE CORNER
L2	N 57°48'31" W	1,267.17'	SHL TO LANDMARK	FD. FENCE CORNER
L4	S 19°35'36" E	1,933.45'	LPL TO AZL1	
LINE	BEARING	DISTANCE	CURVE LENGTH	DESCRIPTION
L3	S 65°09'40" W	2910.06'	3,367.81'	SHL TO LP

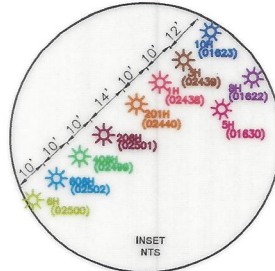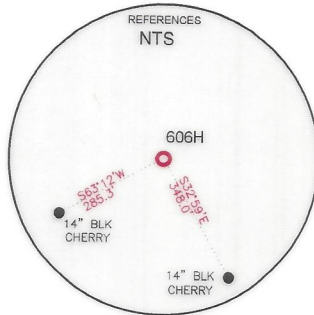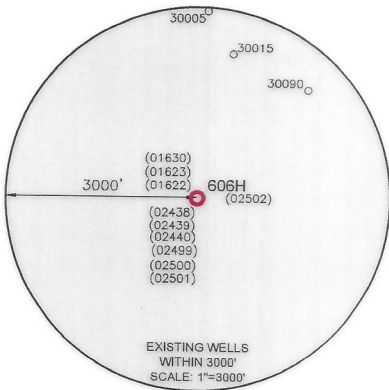

WELL RESTRICTIONS

1. NO OCCUPIED DWELLINGS > 2500 SQ FT. WITHIN 625 FEET OF CENTER OF PAD.
2. NO AGRICULTURE BUILDINGS > 2500 SQ FT. WITHIN 625 FEET OF CENTER OF PAD.
3. NO WATER WELLS OR DEVELOPED SPRINGS ARE WITHIN 250 FEET OF PROPOSED WELL.
4. NO PERENNIAL STREAMS, LAKES, PONDS, OR RESERVOIRS WITHIN 100 FEET OF THE LIMITS OF DISTURBANCE.
5. NO NATURALLY PRODUCING TROUT STREAM WITHIN 300 FEET OF LIMITS OF DISTURBANCE.
6. NO GROUND INTAKE OR PUBLIC WATER SUPPLY WITHIN 1000 FEET OF WELL PAD, LIMITS OF DISTURBANCE, E & S CONTROLS OR PUBLIC WATER SUPPLY.


NOTES ON SURVEY

1. SURFACE AND ROYALTY OWNER INFORMATION AND THEIR BOUNDARIES SHOWN HEREON WERE PLOTTED FROM DEEDS AND/OR TAX PARCEL MAPS PROVIDED BY CLIENT AND/OR FIELD LOCATIONS.
2. THIS PLAT DOES NOT REPRESENT A BOUNDARY SURVEY OF THE PARCELS SHOWN HEREON.
4. ALL INSETS ARE GRID NORTH UNLESS OTHERWISE DEPICTED.

I, THE UNDERSIGNED, HEREBY CERTIFY THAT THIS PLAT IS CORRECT TO THE BEST OF MY KNOWLEDGE AND BELIEF AND SHOWS ALL THE INFORMATION REQUIRED BY LAW AND REGULATIONS ISSUED AND PRESCRIBED BY THE DEPARTMENT OF ENVIRONMENTAL PROTECTION.

P.S. 708

David L Jackson

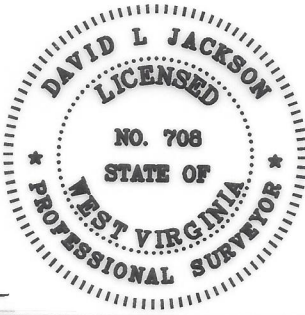

2000 0 2000

GRAPHIC SCALE IN FEET

COMPANY:
SWN **SWN** ^R/_A ^V/_T ⁺/₊
Production Company, LLC Production Company™



(+) DENOTES LOCATION OF WELL ON UNITED STATES TOPOGRAPHIC MAPS
WVDEP
OFFICE OF OIL & GAS
601 57TH STREET
CHARLESTON, WV 25034

MINIMUM DEGREE OF ACCURACY: 1/200
PROVEN SURVEY SOURCE OF GRADE GPS ELEVATION: (NAVD 88, US FT)

DAVID REINBEAU MSH
OPERATOR'S WELL #: 606H
API WELL #: **47** **051** **02502**
STATE COUNTY PERMIT

WELL TYPE: OIL WASTE DISPOSAL PRODUCTION DEEP GAS LIQUID INJECTION STORAGE SHALLOW

WATERSHED: HOLLIDAYS RUN OF WHEELING CREEK (HUC-10) ELEVATION: 1,251.2'

DISTRICT: UNION COUNTY: MARSHALL QUADRANGLE: MOUNDSVILLE, WV

SURFACE OWNER: SHELLY A. & DAVID W. REINBEAU ACREAGE: ±50.88

OIL & GAS ROYALTY OWNER: SHELLY A. & DAVID W. REINBEAU ACREAGE: ±50.88

DRILL DRILL DEEPER REDRILL FRACTURE OR STIMULATE PLUG OFF OLD FORMATION PERFORATE NEW FORMATION

CONVERT PLUG & ABANDON CLEAN OUT & REPLUG OTHER CHANGE (SPECIFY) **ASDRILLED** **06/14/2024**

TARGET FORMATION: MARCELLUS ESTIMATED DEPTH: 6,478 TVD 24,610 TMD

WELL OPERATOR: SWN PRODUCTION COMPANY, LLC
ADDRESS: 1300 FORT PIERPONT ROAD, SUITE 200
CITY: MORGANTOWN STATE: WV ZIP CODE: 26508

DESIGNATED AGENT: BRITTANY WOODY
ADDRESS: 1300 FORT PIERPONT ROAD, SUITE 200
CITY: MORGANTOWN STATE: WV ZIP CODE: 26508






LEGEND:

	PROPOSED SURFACE HOLE / BOTTOM HOLE		SURVEYED BOUNDARY
	EXISTING / PRODUCING WELLHEAD		DRILLING UNIT
	LANDING POINT LOCATION		LEASE BOUNDARY
	EXISTING WATER WELL		ASDRILLED PATH
	EXISTING SPRING		PROPOSED PATH

REVISIONS:	DATE: 10-05-2023
	DRAWN BY: N. MANO
	SCALE: 1" = 2000'
	DRAWING NO:
	WELL LOCATION PLAT

**JACKSON SURVEYING
INC.**

2413 EAST PIKE ST. # 112
Clarksburg, WV 26302
304-623-5851

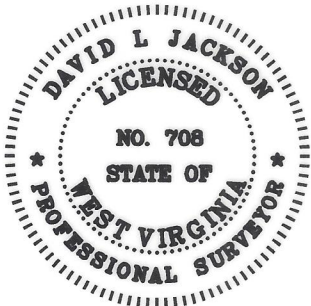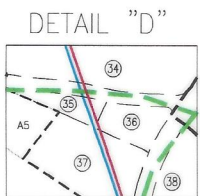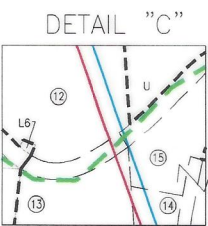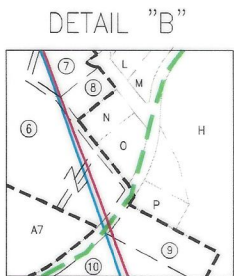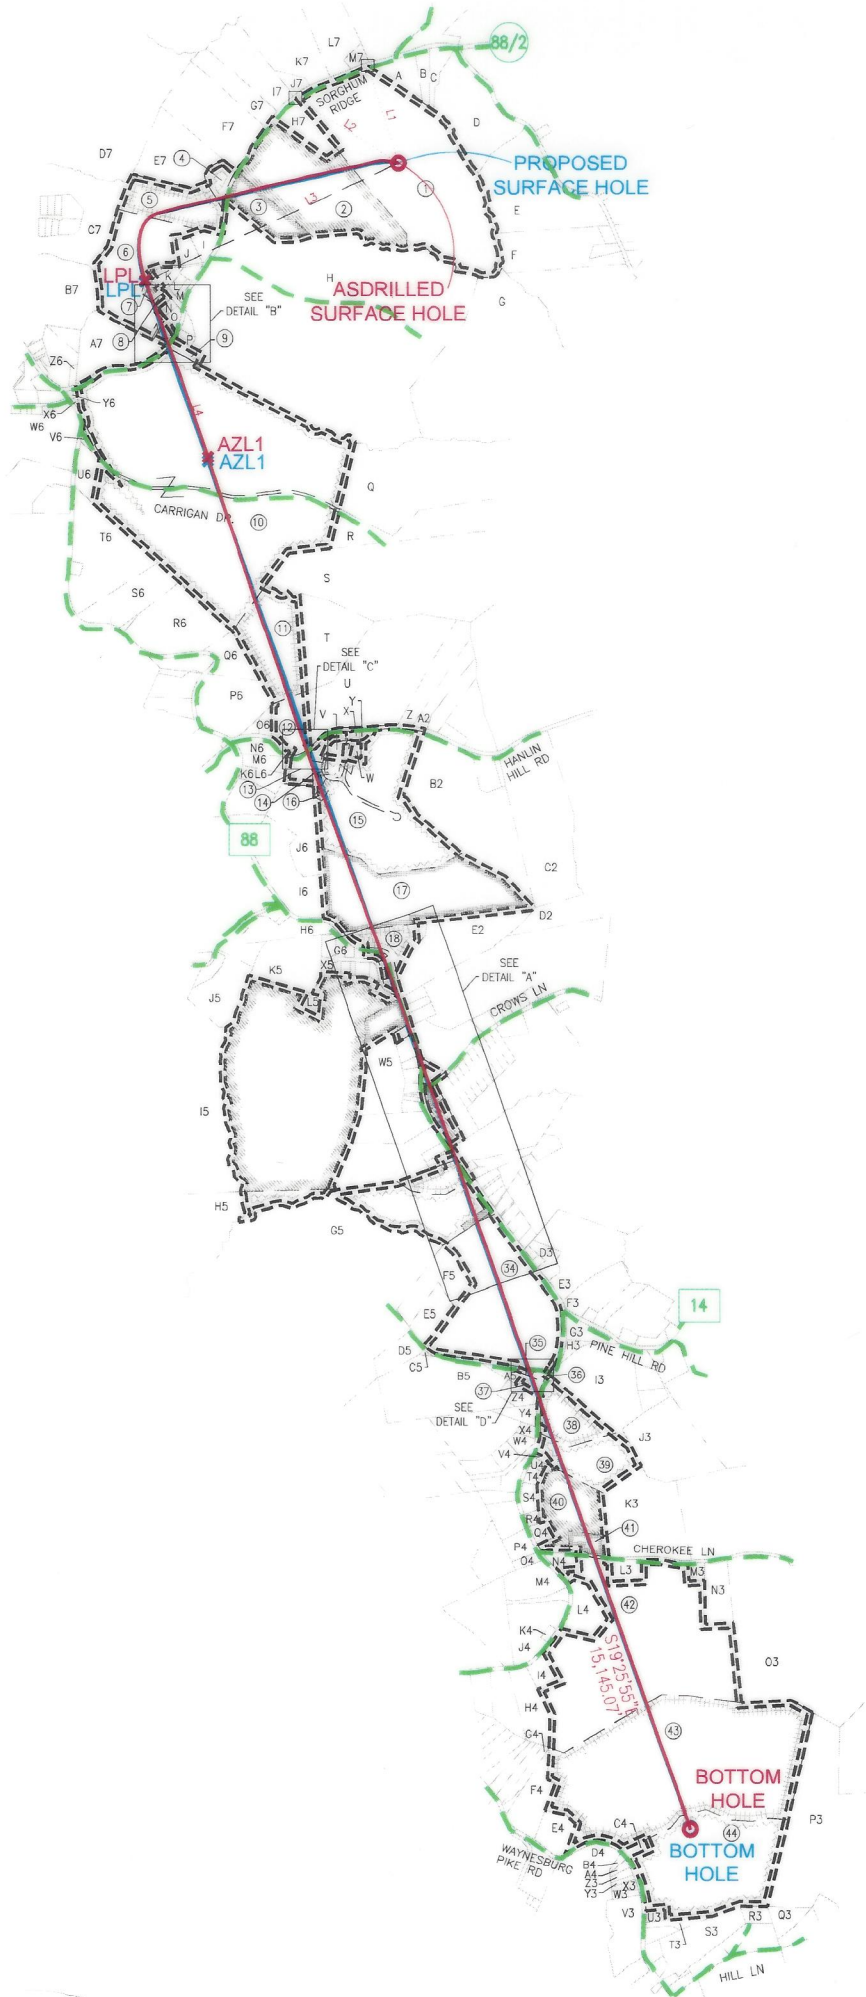

I, THE UNDERSIGNED, HEREBY CERTIFY THAT THIS PLAT IS CORRECT TO THE BEST OF MY KNOWLEDGE AND BELIEF AND SHOWS ALL THE INFORMATION REQUIRED BY LAW AND REGULATIONS ISSUED AND PRESCRIBED BY THE DEPARTMENT OF ENVIRONMENTAL PROTECTION.

P.S. 708

David L Jackson



GRAPHIC SCALE IN FEET

06/14/2024

REVISIONS:	COMPANY:		
	OPERATOR'S	DAVID REINBEAU MSH	API #:
	WELL #:	606H	47-051-02502
	DISTRICT:	COUNTY:	STATE:
	UNION	MARSHALL	WV
			DATE: 10-05-2023
			DRAWN BY: N. MANO
			SCALE: N/A
			DRAWING NO:
			WELL LOCATION PLAT 2



**JACKSON SURVEYING
INC.**

2413 EAST PIKE ST. # 112
Clarksburg, WV 26302
304-623-5851


ADJOINING OWNERS TABLE		
TRACT	SURFACE OWNER	TAX PARCEL
C2	JONES NICHOLAS & EVELINE J	13-09-08
D2	EDISON MARK C ET UX	13-09-09
E2	METS PROPERTIES LLC	13-10-23
F2	METS PROPERTIES LLC	13-10-24.1
G2	MILLER KENNETH LEE - TOD	13-09-33
H2	CHAMBERS ROBIN L & DENICE E	13-09-33.1
I2	CHAMBERS ROBIN L & DENICE E	13-09-33.2
J2	EAGLE LTD	13-09-32.1
K2	VEMURI HOME & GARDEN LLC	13-09-34
L2	FRYE JACQUELINE L & CHARLES G	13-09-31.1
M2	PARSONS JAY D ET UX	13-14-01
N2	CAMPBELL CODIE JOHNELLE	13-14-02
O2	FREEMAN RAYMOND CHRISTOPHER	13-14-03
P2	TROWBRIDGE ROBEYN & JOSHUA SKIDGEL	13-14-05
Q2	TROWBRIDGE ROBEYN & JOSHUA SKIDGEL	13-14-6.1
R2	CLOVIS JUSTIN	13-14-6.3
S2	KENDZIERSKI ALAN B ET UX	13-14-6.4
T2	GIVENS BRUCE E ET UX	13-14-06
U2	GIVENS BRUCE E ET UX	13-14-7.2
V2	CHAMBERS DOROTHY-LIFE	13-14-07
W2	COTTRELL COLE T	13-14-7.5
X2	DORAN BRIAN W ET UX	13-14-7.4
Y2	LEWEY CHARLES L & MARGARET A	13-14-7.1
Z2	BECKNER DAVID E & DEBORAH K	13-14-7.3
A3	GANTZER MARCIA L & JAMES E	13-14-8.2
B3	GANTZER MARCIA L & JAMES E	13-14-8.1
C3	YOHO RONNIE E	13-14-8.3
D3	YOHO GAIL L & RONNIE E	13-14-8.4
E3	ROVER PIPELINE LLC	13-14-08
F3	ROVER PIPELINE LLC	13-14-09
G3	DRAKE JASON T & DEANNA J	13-14-31.1
H3	LYONS BRENT G ET UX	13-14-31
I3	HENRY GH & JANET FAMILY TRUST	13-14-32
J3	HENRY GH & JANET FAMILY TRUST	13-14-29
K3	FOSTER CHARLES S & BRENDA	13-14-38.2
L3	EBERT BRADLEY	14-05-24.9
M3	WILSON ROBERT J & REBECCA S	14-05-24.6
N3	FOSTER CAITLIN E	13-14-50
O3	SMITH EDWARD LEE II	14-05-26
P3	HILL KAY F ET AL	14-05-28
Q3	HILL KAY F ET AL	14-05-29
R3	LILLEY ROGER W ET UX	14-05-32.5
S3	YOHO KIM MARLENE	14-05-33
T3	WHIPKEY ROGER ET UX	14-05-35
U3	SIMONS JORDAN M & VICTORIA G BENLINE SIMONS	14-05-36.1
V3	DERROW SAMUEL R ET UX	14-05-39
W3	KELLEY RODNEY & BONNIE	14-05-38.1
X3	KELLEY RODNEY & BONNIE	14-05-38
Y3	KELLEY RODNEY & BONNIE	14-05-38.2
Z3	KELLEY RODNEY & BONNIE	14-05-38.3
A4	WALTER DANA F	14-05-38.4
B4	WALTER DANA F	14-05-38.5
C4	FRANCIS LISA JANE	14-05-36.2
D4	BISHOP PENNY S ET VIR	14-05-39.1
E4	FRANCIS LISA JANE	14-05-37.1
F4	GALLOWAY HARRY L	14-05-11
G4	J & R DEVELOPMENT LLC	14-05-11.3
H4	SMITH MARK ALLEN ET UX	14-05-23
I4	KOONTZ COLE	14-05-24.8
J4	WILLIAMS CARL R & RHONDA L	14-05-24.5
K4	WILLIAMS CARL R & RHONDA L	14-05-24.4
L4	KOONTZ JOHN R	14-05-24.3
M4	WOODS JOHN E SR & FRANCES J	14-05-24.2
N4	KOONTZ CARL E JR	14-05-24.1
O4	SNYDER DAVID L - LIFE	13-14-40
P4	SNYDER DAVID L - LIFE	13-14-44
Q4	HEWITT MARTIN O ET UX	13-14-38.3
R4	SMITH CARROLYN - TOD	13-14-38.4
S4	GUMP CHRISTINA H	13-14-37
T4	WEST THOMAS J JR & KATHY ANN	13-14-36

ADJOINING OWNERS TABLE		
TRACT	SURFACE OWNER	TAX PARCEL
U4	WEST THOMAS J JR & KATHY ANN	13-14-35
V4	WEST THOMAS J JR & KATHY ANN	13-14-34.1
W4	POLANSKI LINDSAY N	13-14-41.2
X4	FERDA BRIAN T	13-14-46.2
Y4	BOWIE CHRISTOPHER E	13-14-46.1
Z4	CUNNINGHAM CHAD	13-14-47
A5	KOONTZ HELEN - TOD	13-14-48.2
B5	CUNNINGHAM CHAD L & JEFFREY H	13-14-47.1
C5	CUNNINGHAM JEFFREY H & CHAD	13-13-20
D5	CUNNINGHAM JEFFREY H & CHAD	13-13-19
E5	HELLER AMBER R & EDGAR D JR	13-13-18.1
F5	HELLER AMBER R & EDGAR D JR	13-13-18
G5	HELLER EDGAR D JR TRUST	13-13-21
H5	HELLER EDGAR D JR TRUST	13-13-23
I5	HELLER EDGAR D JR TRUST	13-13-09
J5	KOCH JOHN E & BARBARA A - TOD	13-13-9.3
K5	SCHABER LESLIE B & LORI D	13-13-10.1
L5	SCHABER LESLIE B & LORI D	13-13-10.2
M5	TH EXPLORATION, LLC	13-13-13.3
N5	NORRIS TABITHA L	13-13-13.2
O5	GROSS COBER R ET UX	13-13-13
P5	SHANNON WILLIAM JAMES	13-13-12
Q5	BURTON ERIC & LEE ANN	13-13-11.7
R5	SCARNECHIA DAVID W	13-13-11.6
S5	SCARNECHIA DAVID W	13-13-11
T5	SCARNECHIA DAVID W	13-13-11.5
U5	HAIGHT DONNA JEAN	13-13-11.8
V5	HAIGHT DONNA JEAN	13-13-11.2
W5	SHANNON WILLIAM JAMES	13-13-11.3
X5	BACH WILBERT H II ET UX	13-13A-10
Y5	BACH WILBERT H II ET UX	13-13A-11
Z5	SCHABER LESLIE B & LORI D	13-13A-12
A6	SCHABER LESLIE B & LORI D	13-13A-13.1
B6	KNOBlich RICHARD KARL ET UX	13-13A-13
C6	WARD ROBERT C JR & VICKY LINN	13-13A-15
D6	SCHABER LESLIE & LORI	13-13-10.3
E6	CARR PHYLLIS J	13-13A-06
F6	HESS GEORGE JR ET UX	13-13A-07
G6	WHIPKEY ROBERT	13-13A-08
H6	MARSH DAVID A ET UX	13-10-28
I6	THORN RONNIE L & BETH A	13-10-30.1
J6	ELLIOTT GLENN F	13-10-30
K6	ELLIOTT GLENN F	13-10-33
L6	MANUFACTURING LIGHT & HEAT CO	13-10-18.2
M6	RUSH J LARRY & LINDA M	13-10-32.1
N6	RUSH JOSEPH L & LINDA M	13-10-32
O6	MOSA BLAIR P ET UX	13-10-18.1
P6	TARGOSKY ROSEMARY & MCCOY-GOOGEL BARAK	13-10-16
Q6	CARTER KELLY J	13-10-15.1
R6	WALTON DANIEL JR & THERESA	13-08-17
S6	WALTON DANIEL JR & THERESA	13-08-18
T6	MCCOMBS THOMAS E & BETH E - TOD	13-08-19
U6	PRESBYTERIAN CHURCH	13-08-20
V6	ALLEN GROVE PRESBYTERIAN CHURCH	13-08-15.1
W6	KAHLBAUGH DAVID W & DELORES- TOD	13-07-24
X6	HIERONIMUS C KEITH ET UX	13-7A-23
Y6	SHARRARD CEMETERY	13-7A-22
Z6	JOHNSON GILBERT	13-7A-03
A7	MCCOMBS THOMAS E & BETH E - TOD	13-08-16
B7	CMK REALTY LLC	13-7A-09
C7	BOARD OF EDUCATION	13-07-16
D7	BOARD OF EDUCATION	13-07-17
E7	MCCOMBS JOHN A SR & MARILYN S	13-07-22.1
F7	REINBEAU DAVID W & SHELLY A	13-07-22.3
G7	REINBEAU DAVID W & SHELLY A	13-07-21.1
H7	BOWMAN MICHAEL ET UX	13-08-28
I7	BOWMAN MICHAEL J & CONSTANCE G	13-07-21
J7	ALEXANDER LORRAINE	13-07-20
K7	ALEXANDER LORRAINE	13-07-18.1
L7	ALEXANDER LORRAINE	13-07-18
M7	SAMPSON EDITH VIRGINIA EST	13-07-19

06/14/2024

REVISIONS:	COMPANY:		 	
	OPERATOR'S	DAVID REINBEAU MSH	API #:	DATE: 10-05-2023
	WELL #:	606H	47-051-02502	DRAWN BY: N. MANO
	DISTRICT:	COUNTY:	STATE:	SCALE: N/A
	UNION	MARSHALL	WV	DRAWING NO:
				WELL LOCATION PLAT 4

**JACKSON SURVEYING
INC.**
2413 EAST PIKE ST. # 112
Clarksburg, WV 26302
304-623-5851

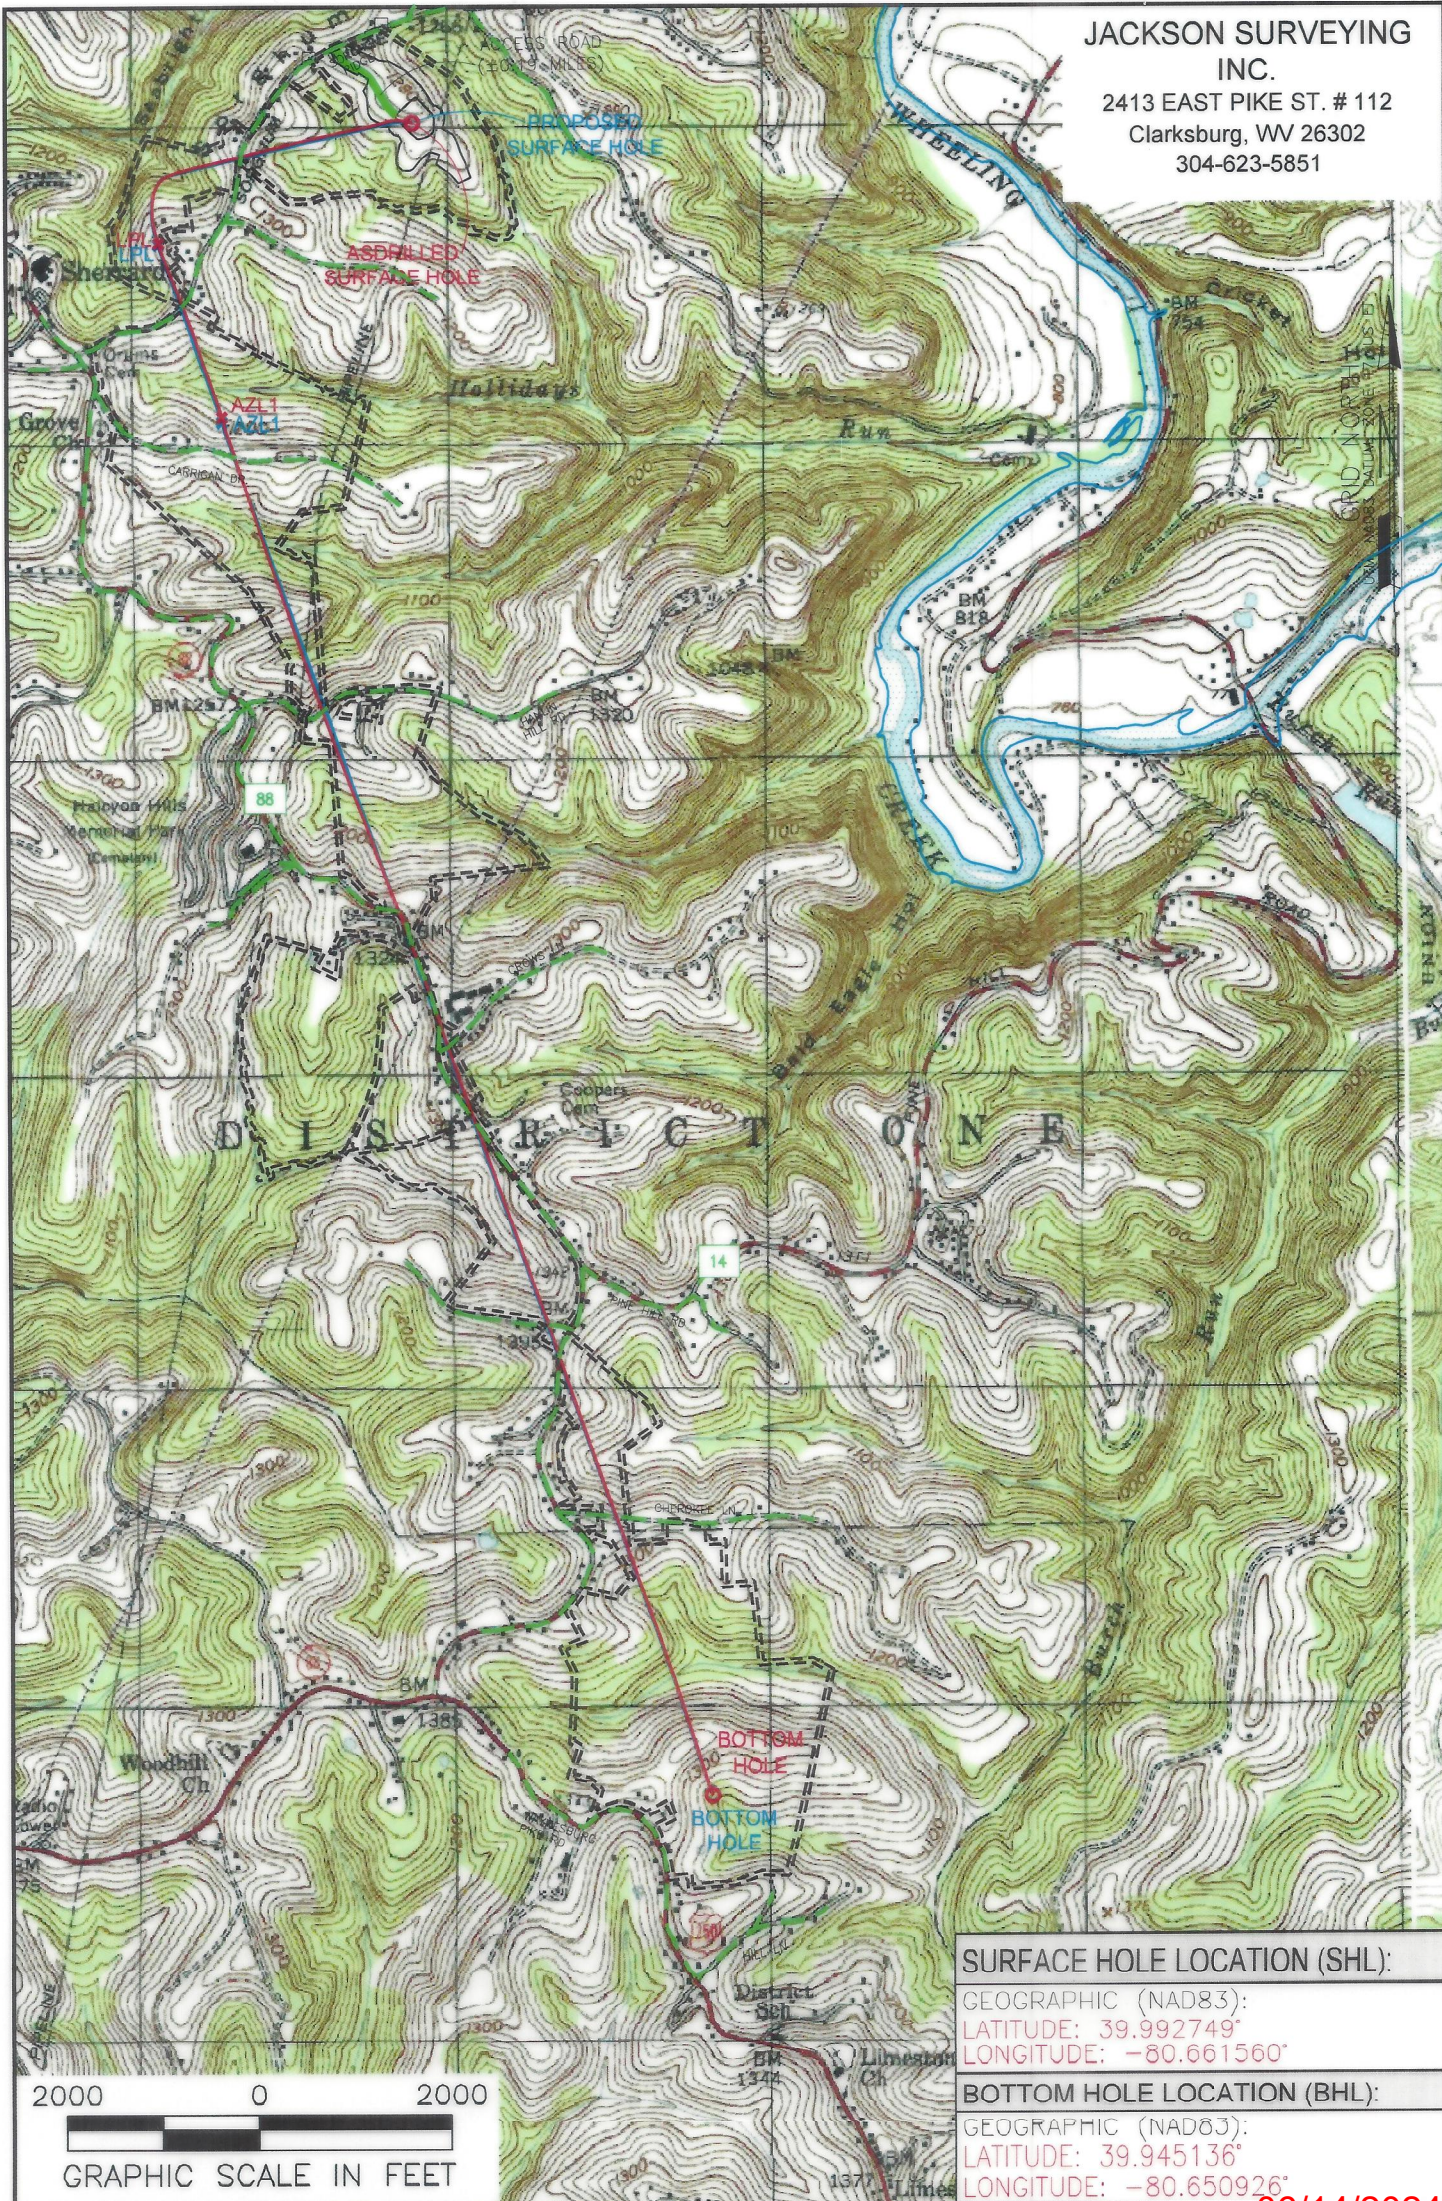

SURFACE HOLE LOCATION (SHL):	
GEOGRAPHIC (NAD83):	
LATITUDE: 39.992749°	
LONGITUDE: -80.661560°	
BOTTOM HOLE LOCATION (BHL):	
GEOGRAPHIC (NAD83):	
LATITUDE: 39.945136°	
LONGITUDE: -80.650926°	

06/14/2024

NOTES ON SURVEY

1. SURFACE AND ROYALTY OWNER INFORMATION AND THEIR BOUNDARIES SHOWN HEREON WERE PLOTTED FROM DEEDS AND/OR TAX PARCEL MAPS PROVIDED BY CLIENT AND/OR FIELD LOCATIONS.
2. THIS PLAT DOES NOT REPRESENT A BOUNDARY SURVEY OF THE PARCELS SHOWN HEREON.
4. ALL INSETS ARE GRID NORTH UNLESS OTHERWISE DEPICTED.

LEGEND:

- PROPOSED SURFACE HOLE / BOTTOM HOLE
- EXISTING / PRODUCING WELLHEAD
- LANDING POINT LOCATION
- FLOOD PLAIN
- ACCESS ROAD
- PUBLIC ROAD
- ACCESS ROAD TO PREV. SITE
- LEASE BOUNDARY
- PROPOSED PATH
- ASDRILLED PATH

WELL OPERATOR: SWN PRODUCTION COMPANY, LLC	WELL (FARM) NAME: DAVID REINBEAU MSH	WELL # 606H
ADDRESS: 1300 FORT PIERPONT ROAD, SUITE 200 MORGANTOWN, WV 26508	COUNTY - CODE MARSHALL - 051	DISTRICT; UNION
SURFACE OWNER: SHELLY A. & DAVID W. REINBEAU	USGS 7 1/2 QUADRANGLE MAP NAME MOUNDSVILLE, WV	API #: 47-051-02502