

4705102527

CAMERON QUADRANGLE
WEST VIRGINIA - PENNSYLVANIA
7.5 MINUTE SERIES (TOPOGRAPHIC)

4963 IV NW
(WIND RIDGE)

SE/4 CAMERON 15' QUADRANGLE

539 32'30"


1710 000 FEET (W. VA.)

WAYNESBURG, PA. 23 MI.
GRAYSVILLE, PA. 8.4 MI.

542

80°30'

39°52'30"

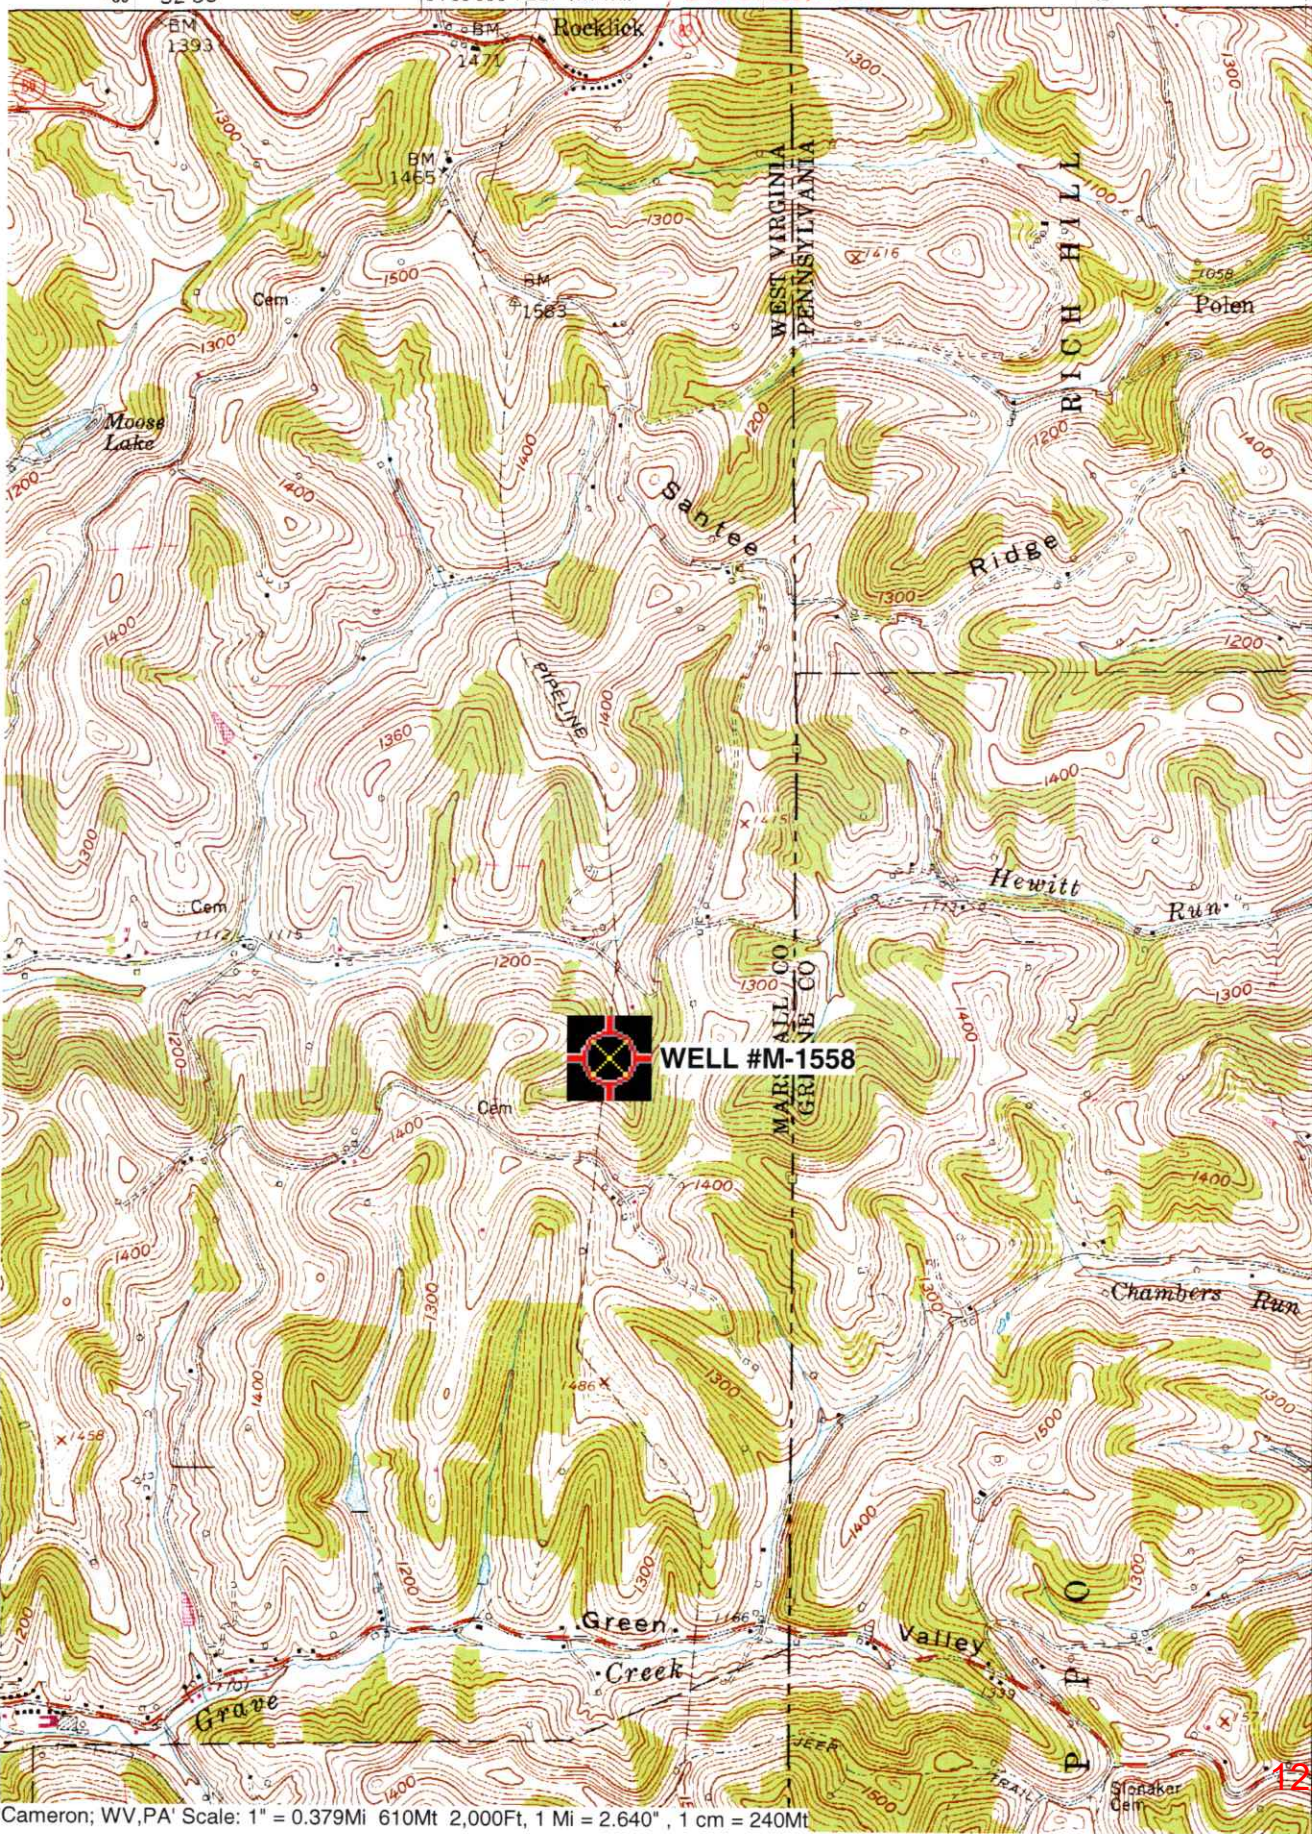

500 000 FEET
(W. VA.)

4412

4411

RECEIVED
Office of Oil and Gas
4410

DEC 06 2024

WV Department of
Environmental Protection

50'

4409

0.2 MI. TO PA. LB

12/20/2024

4705102527

WW-7
8-30-06



West Virginia Department of Environmental Protection
Office of Oil and Gas

WELL LOCATION FORM: GPS

API: 47-051-00573 WELL NO.: M-1558

FARM NAME: T.B. LOUGH

RESPONSIBLE PARTY NAME: WEST VIRGINIA LAND RESOURCES INC.

COUNTY: MARSHALL DISTRICT: CAMERON

QUADRANGLE: CAMERON WV, PA

SURFACE OWNER: ARDEN B. WOOD ET UX

ROYALTY OWNER: _____

UTM GPS NORTHING: 4,410,669 m

UTM GPS EASTING: 540,552 m GPS ELEVATION: 374 m

The Responsible Party named above has chosen to submit GPS coordinates in lieu of preparing a new well location plat for a plugging permit or assigned API number on the above well. The Office of Oil and Gas will not accept GPS coordinates that do not meet the following requirements:

1. Datum: NAD 1983, Zone: 17 North, Coordinate Units: meters, Altitude: height above mean sea level (MSL) – meters.
2. Accuracy to Datum – 3.05 meters
3. Data Collection Method:

Survey grade GPS : Post Processed Differential _____


Real-Time Differential

Mapping Grade GPS _____ : Post Processed Differential _____

Real-Time Differential _____

4. **Letter size copy of the topography map showing the well location.**

I the undersigned, hereby certify this data is correct to the best of my knowledge and belief and shows all the information required by law and the regulations issued and prescribed by the Office of Oil and Gas.

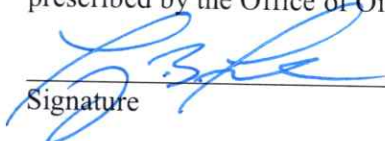
Signature

PS 2002
Title

NOVEMBER 14, 2024
Date

12/20/2024