

Latitude

Longitude

1.73s
1.38w

Topo Location

7.5' Loc. \_\_\_\_\_ 15' Loc. \_\_\_\_\_  
 \_\_\_\_\_ (calc.) \_\_\_\_\_

Company Carnegie Nat Gas

Farm WH Lopez # 696

15' Quad \_\_\_\_\_  
(sec.)

7.5' Quad Cameron


District Liberty

WELL LOCATION PLAT

County 051 Permit 30027

Liberty Dist

Plugging Affidavit  
July 7, 1933

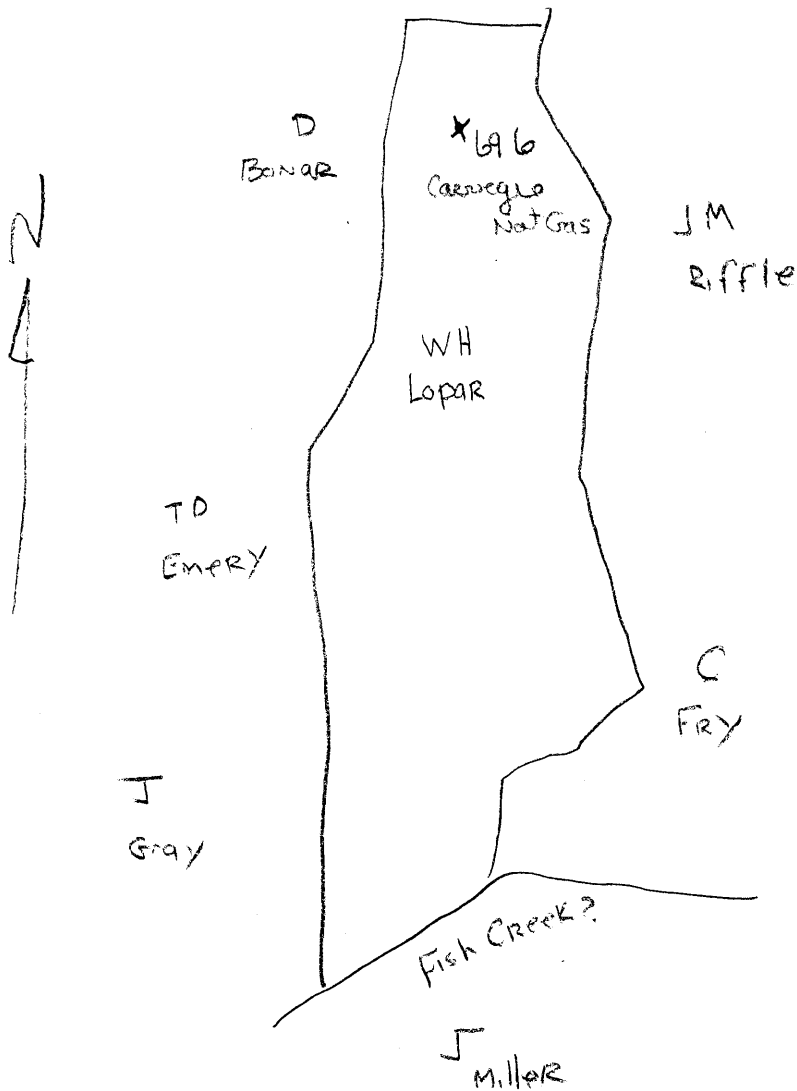

Marsh 27A

Liberty District, Marshall County, W. Va.  
 Carnegie Natural Gas Co., 962 Frick Bldg. Annex, Pittsburgh, Pa.  
 On.....acres, surface owned by Bank of Cameron, Cameron, W. Va.,  
 and mineral rights by Bank of Cameron et al., Cameron, W. Va.  
 Elevation, 1245' B.  
 16" conductor, 12' 10" casing, 235'; 8 1/4", 1480'; 6-5/8", 2095'.  
 Coal was encountered at 880-885, 975-983'.  
 Abandonment reported to Dept. of Mines March 31, 1933.  
 Well was shot at 2961-2968'.  
 Gas well.

MARS-27-A

	Top.	Bottom.
Conductor	0	12
Mapletown Coal	880	885
Pittsburgh Coal	975	984
Murphy Sand	1088	1112
Little Dunkard Sand	1395	1407
Big Dunkard Sand	1476	1482
Gas Sand	1535	1605
1st Salt Sand	1874	1903
Maxton Sand	1993	2040
Little Lime	2050	2060
Pencil Cave	2060	2065
Big Lime	2065	2116
Big Injun Sand (gas, 2200-2207')	2116	2370
30-Ft. Sand	2852	2870
Gordon Stray Sand (little gas, 2908-2912')	2900	2926
Gordon Sand (gas, 2965-2969')	2958	2988
4th Sand, to bottom	3026	3032

Liberty District, Marshall County, W. Va.

By Carnegie Natural Gas Co.

Cameron SE Quadrangle.

On 101 acres; lease No. 9805.

Drilling commenced Nov. 17, 1916; completed, Dec. 20, 1916.

Abandoned July 7, 1933. DRILLED DEEPER from 2208', 7-21-22.

No elevation. Rock pressure, 710#, B.I.; 155#, Gordon.

5,000,000 cu. ft. gas. Big Injun; 335,000 cu. ft. gas in Gordon.

Record from Wilcox 10-15-39.

	Top.	Bottom.
Mapletown (Sewickley) Coal	880	- 885
Pittsburgh Coal	975	- 984
Murphy Sand (MINSHALL)	1088	- 1112
Little Dunkard Sand	1395	- 1407
Big Dunkard Sand	1476	- 1482
1st Gas Sand (BURNING SPRINGS)	1535	- 1605
1st Salt Sand	1874	- 1903
Maxton Sand	1993	- 2040
Little Line	2050	- 2060
Pencil Cave	2060	- 2065
Big Line	2065	- 2116
Big Injun Sand (5,000,000 cu. ft. gas at 2200-07'; 710# R. P.) DRILLED DEEPER FROM 2208', 7-21-22:		
30' Sand (50')	(30')	2852 - 2870
Gordon Stray Sand (show gas, 2908-12')		2900 - 2926
Gordon Sand (gas, 2965-69'; 335,000 cu. ft.; 155# R. P.)		2958 - 2988
<del>Horizontal</del>		<del>3026 - 3035</del>
<del>Horizontal</del>		<del>3026 - 3035</del>
Fourth Sand	3026	- 3035
Total depth		3204
Plugged back to		3032