


48°00'00"

Latitude

80°32'30"

Longitude

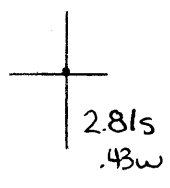

Topo Location

7.5' Loc. \_\_\_\_\_ 15' Loc. \_\_\_\_\_  
 \_\_\_\_\_ (calc.) \_\_\_\_\_

Company Nat Gas Co of WV

Farm LA & WH Bed # 2


15' Quad \_\_\_\_\_  
(sec.)

7.5' Quad Majorsville

District Sand Hill

**WELL LOCATION PLAT**

County OSI Permit 30083

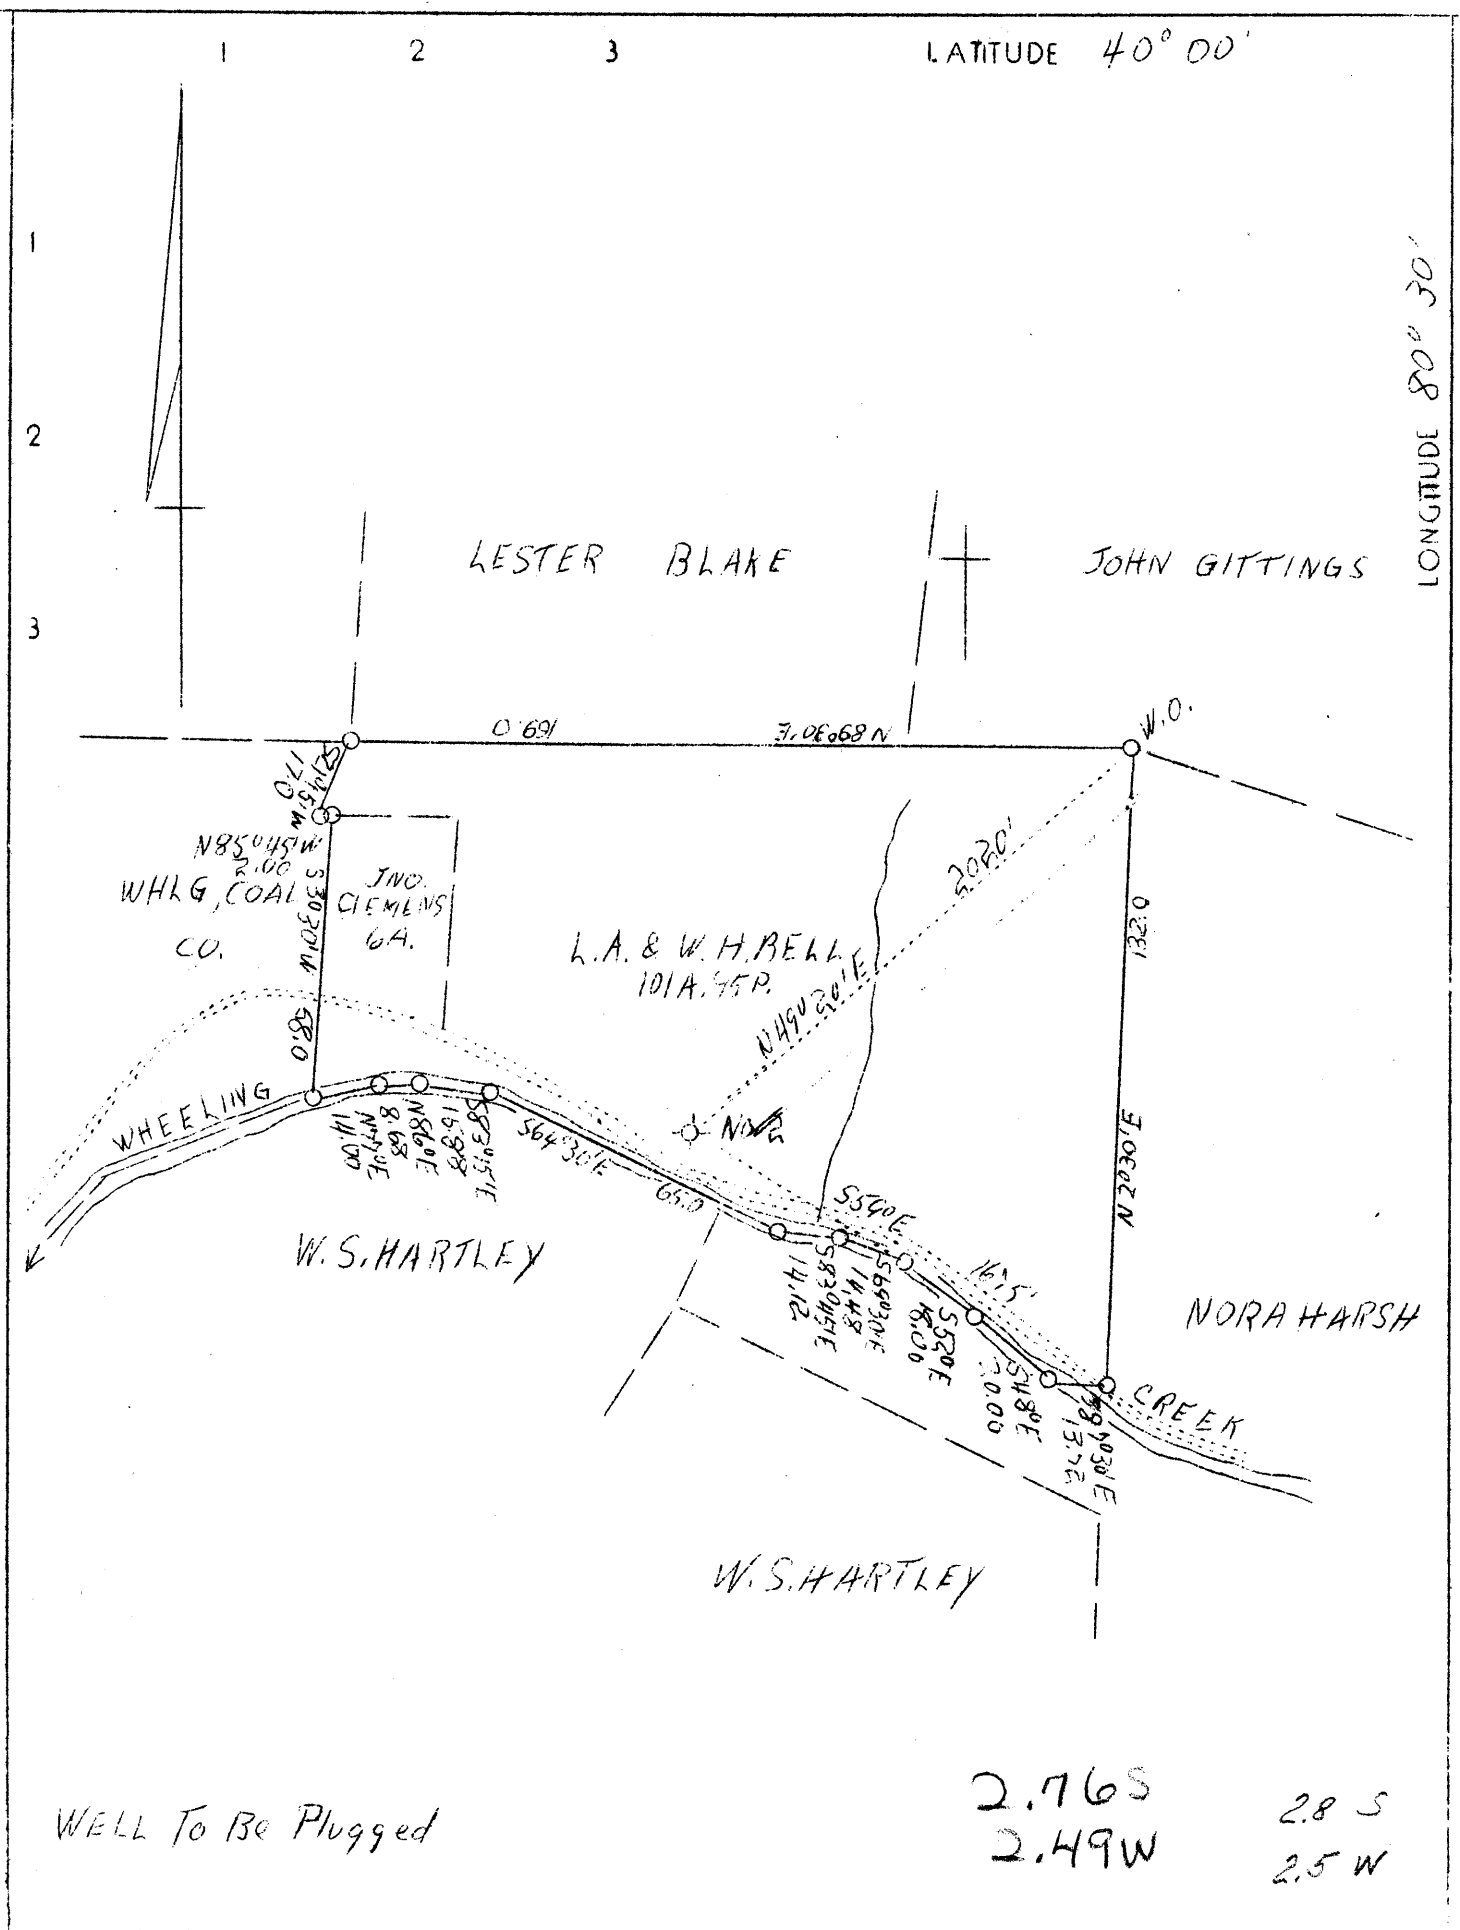

WELL TO BE PLUGGED

2.76 S  
2.49 W  
2.8 S  
2.5 W

Company	Natural Gas Co. of W. Va.
Address	800 Union Trust Bldg., Pittsburgh, Pa.
Farm	L.A. & W.H. Bell
Tract	1 Acres 101.6 Lease No.
Well (Farm) No.	2 Serial No.
Elevation (Spirit Level)	815'
Quadrangle	Cameron N.C.
County	Marshall District Sand Hill
Engineer	A.J. Russell
Engineer's Registration No.	
File No.	Y-7 951 Drawing No.
Date	April 5, 1938 Scale 1" = 40 Rods = 660'

STATE OF WEST VIRGINIA  
Department of Mines  
OIL AND GAS DIVISION  
CHARLESTON

WELL LOCATION MAP

File No. MARS-83-A

Denotes location of well on United States Topographic Maps, scale 1 to 62,500, latitude and longitude lines being represented by border lines as shown.

Denotes one inch spaces on border line of original tracing.