


Latitude 40 00

3
2.77 2.18S
2.69 W
2.40W
2.63S

#3 2.16S
2.70W

Longitude 80 40'

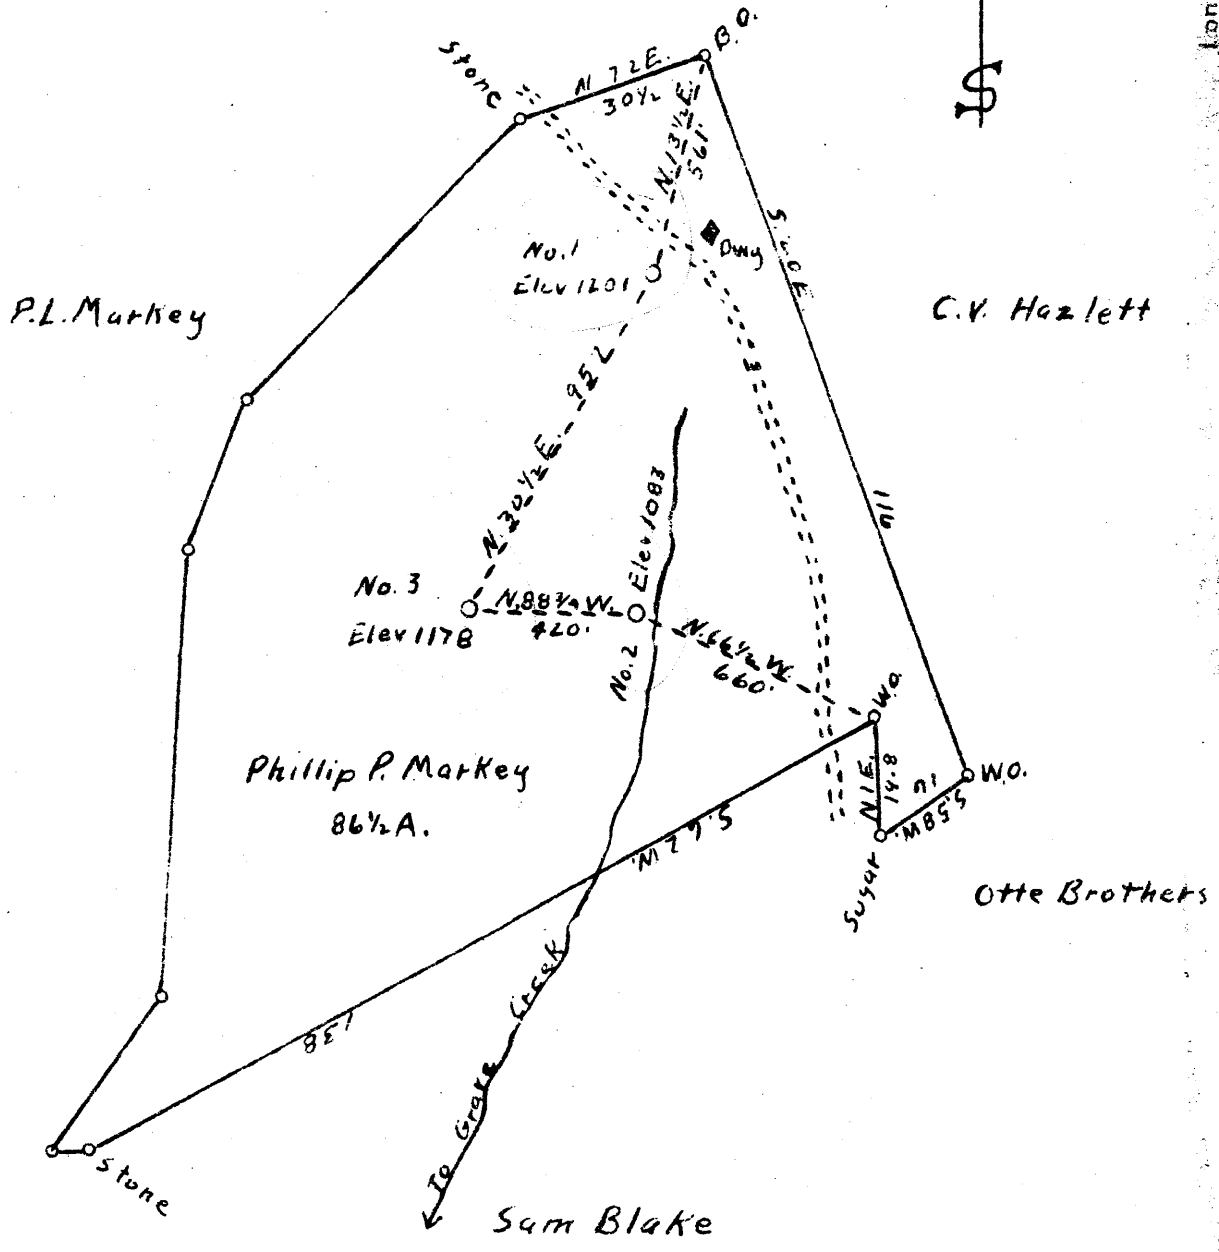

New Location
Drill Deeper
Abandonment X

Company W.M. Moses
Address Salem W.Va.
Farm Phillip P. Markey
Tract _____ Acres 86 1/2 Lease No. _____
Well (Farm) No. 1-2-3 Serial No. _____
Elevation (Spirit Level) 1201-1083-1178
Quadrangle Cameron
County Marshall District Union
Engineer A.K. Westfall
Engineer's Registration No. _____
File No. _____ Drawing No. _____
Date July 19, 1945 Scale 1" = 30 Poles

STATE OF WEST VIRGINIA
DEPARTMENT OF MINES
OIL AND GAS DIVISION
CHARLESTON

WELL LOCATION MAP

FILE NO. ~~MARS 241A-#2~~
MARS - 249-A - #3
~~MARS - 251-A - #1~~

+ Denotes location of well on United States Topographic Maps, scale 1 to 62,500, latitude and longitude lines being represented by border lines as shown.
- Denotes one inch spaces on border line of original tracing.



296

STATE OF WEST VIRGINIA
DEPARTMENT OF MINES
OIL AND GAS DIVISION

WELL RECORD

Permit No. MARS-251-A

Oil or Gas Well OIL
(KIND)

Company George P. Wasmith
Address Glendale, W. Va.
Farm P. P. Markey Acres 86 1/2
Location (waters).....
Well No. 1 Elev. 1201
District Union County Marshall
The surface of tract is owned in fee by.....
Address.....
Mineral rights are owned by.....
Address.....
Drilling commenced 1925
Drilling completed 1925
Date Shot..... From..... To.....
With.....
Open Flow /10ths Water in..... Inch
/10ths Merc. in..... Inch
Volume..... Cu. Ft.
Rock Pressure..... lbs..... hrs.
Oil..... bbls., 1st 24 hrs.
Fresh water..... feet..... feet
Salt water..... feet..... feet

| Casing and Tubing | Used in Drilling | Left in Well | Packers |
|-------------------|------------------|--------------|---------------------|
| Size | | | |
| 16..... | | | Kind of Packer..... |
| 18..... | 20 | 20 | |
| 10..... | 670 | 670 | Size of..... |
| 8 1/4..... | 1170 | Pulled | |
| 6 3/4..... | 1670 | 1670 | Depth set..... |
| 5 3/16..... | | | |
| 3..... | | | Perf. top..... |
| 2..... | 1765 | 1765 | Perf. bottom..... |
| Liners Used..... | | | Perf. top..... |
| | | | Perf. bottom..... |

CASING CEMENTED..... SIZE..... No. Ft..... Date.....
COAL WAS ENCOUNTERED AT 657 FEET..... INCHES
..... FEET..... INCHES..... FEET..... INCHES
..... FEET..... INCHES..... FEET..... INCHES

| Formation | Color | Hard or Soft | Top | Bottom | Oil, Gas or Water | Depth Found | Remarks |
|-----------|-------|--------------|------|--------|-------------------|-------------|---------|
| Big Injun | White | Hard | 1670 | 1770 | Oil | 1765 | |