


LAT. 40° 00'

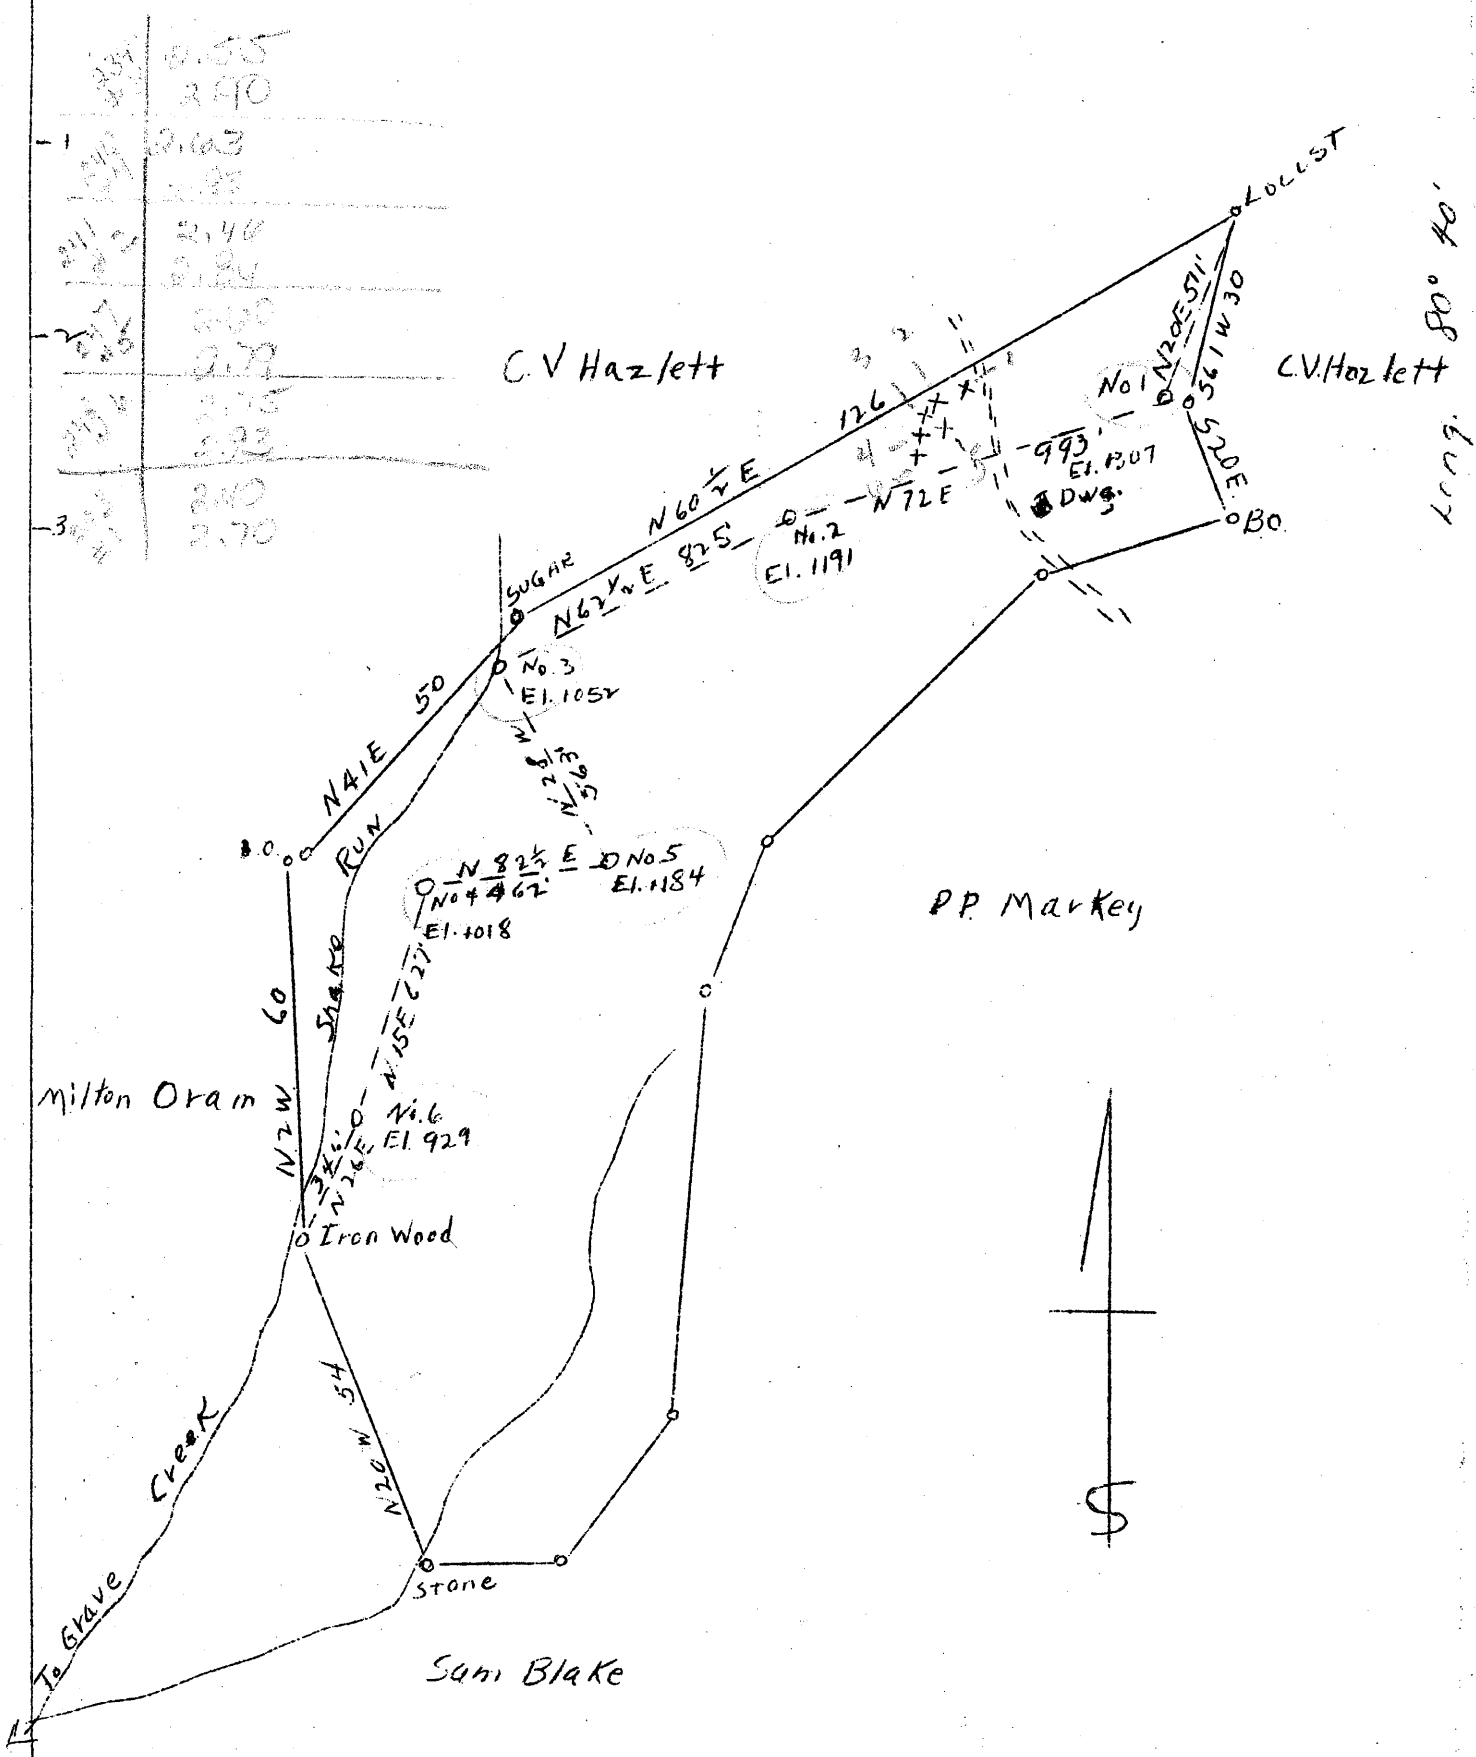

ABANDONMENT X

COMPANY W. M. MOSES

ADDRESS SALEM, W. VA.

FARM PHILIP L. MARKEY HRS.

TRACT ACRES 86 1/4 LEASE NO. _____

WELL (FARM) NO. 1-2-3-4-5-6 SERIAL NO. 1307-1191-1052-1018

ELEVATION (SPIRIT) LEVEL 1184-929

QUADRANGLE CAMERON

COUNTY MARSHALL DIST. UNION

ENGINEER A. K. WESTFALL

ENGINEER REG. NO. _____

FILE NO. _____ DRAWING NO. _____

DATE 7/20/45 SCALE 1" - 30 POLES

STATE OF WEST VIRGINIA
 DEPARTMENT OF MINES
 OIL AND GAS DIVISION
 CHARLESTON
 WELL LOCATION MAP

FILE NO. ~~MARS-239A-NO. 3, 240A-NO. 4;~~
~~241A-NO. 2, 247A-NO. 5; 248A-NO. 6;~~
253A-NO. 1

+ DENOTES LOCATION OF WELL ON U.S. TOPOGRAPHIC MAPS, SCALE 1 TO 62,500 LATITUDE AND LONGITUDE LINES BEING REPRESENTED BY BORDER LINES AS SHOWN.

- DENOTES ONE INCH SPACES ON BORDER LINE OF ORIGINAL TRACING.



300

STATE OF WEST VIRGINIA
DEPARTMENT OF MINES
OIL AND GAS DIVISION

WELL RECORD

Permit No. MARS-253 - A

Oil or Gas Well Oil
(KIND)

Company George P. Wasmuth
Address Glen Dale, West Virginia
Farm Phillip L. Markey Heirs Acres 86 1/2
Location (waters).....
Well No. 1 Elev. 1307
District Union County Marshall
The surface of tract is owned in fee by.....
Address.....
Mineral rights are owned by.....
Address.....
Drilling commenced 1925
Drilling completed 1925
Date Shot..... From..... To.....
With.....
Open Flow /10ths Water in..... Inch
/10ths Merc. in..... Inch
Volume..... Cu. Ft.
Rock Pressure..... lbs..... hrs.
Oil..... bbls., 1st 24 hrs.
Fresh water..... feet..... feet
Salt water..... feet..... feet

| Casing and Tubing | Used in Drilling | Left in Well | Packers |
|-------------------|------------------|--------------|---------------------|
| Size | | | |
| 16..... | | | Kind of Packer..... |
| 18..... | | | |
| 10..... | No record | Pulled | Size of..... |
| 8 1/4..... | 1282 | 1282 | |
| 6 3/4..... | 1791 | 1791 | Depth set..... |
| 5 3/16..... | | | |
| 3..... | | | Perf. top..... |
| 2..... | 1388 | 1388 | Perf. bottom..... |
| Liners Used..... | | | Perf. top..... |
| | | | Perf. bottom..... |

CASING CEMENTED..... SIZE..... No. Ft..... Date.....
COAL WAS ENCOUNTERED AT 775 FEET..... INCHES
..... FEET..... INCHES..... FEET..... INCHES
..... FEET..... INCHES..... FEET..... INCHES

| Formation | Color | Hard or Soft | Top | Bottom | Oil, Gas or Water | Depth Found | Remarks |
|-----------|-------|--------------|------|--------|-------------------|-------------|---------|
| Big Injun | White | Hard | 1791 | 1388 | Oil | 1377 | |