


Latitude

Longitude

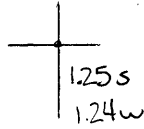

Topo Location

7.5' Loc. \_\_\_\_\_ 15' Loc. \_\_\_\_\_  
 \_\_\_\_\_ (calc.) \_\_\_\_\_

Company \_\_\_\_\_

Farm Jacob Bassett #1

15' Quad \_\_\_\_\_  
(sec.)

7.5' Quad Wm Easton

District Meado


WELL LOCATION PLAT

County OSI Permit 30337

Meade

3950

2040

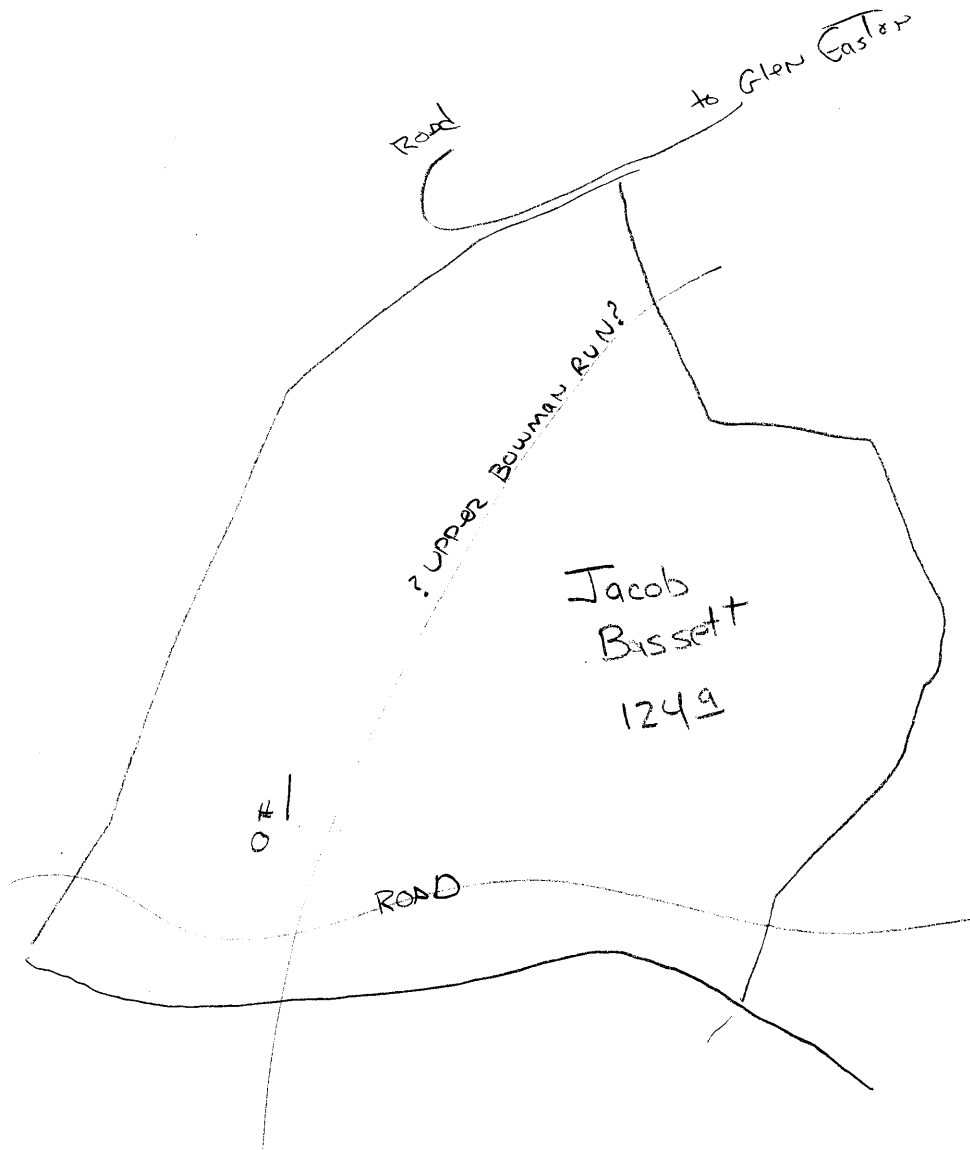

30337