


Latitude 40°00

Longitude 80°40

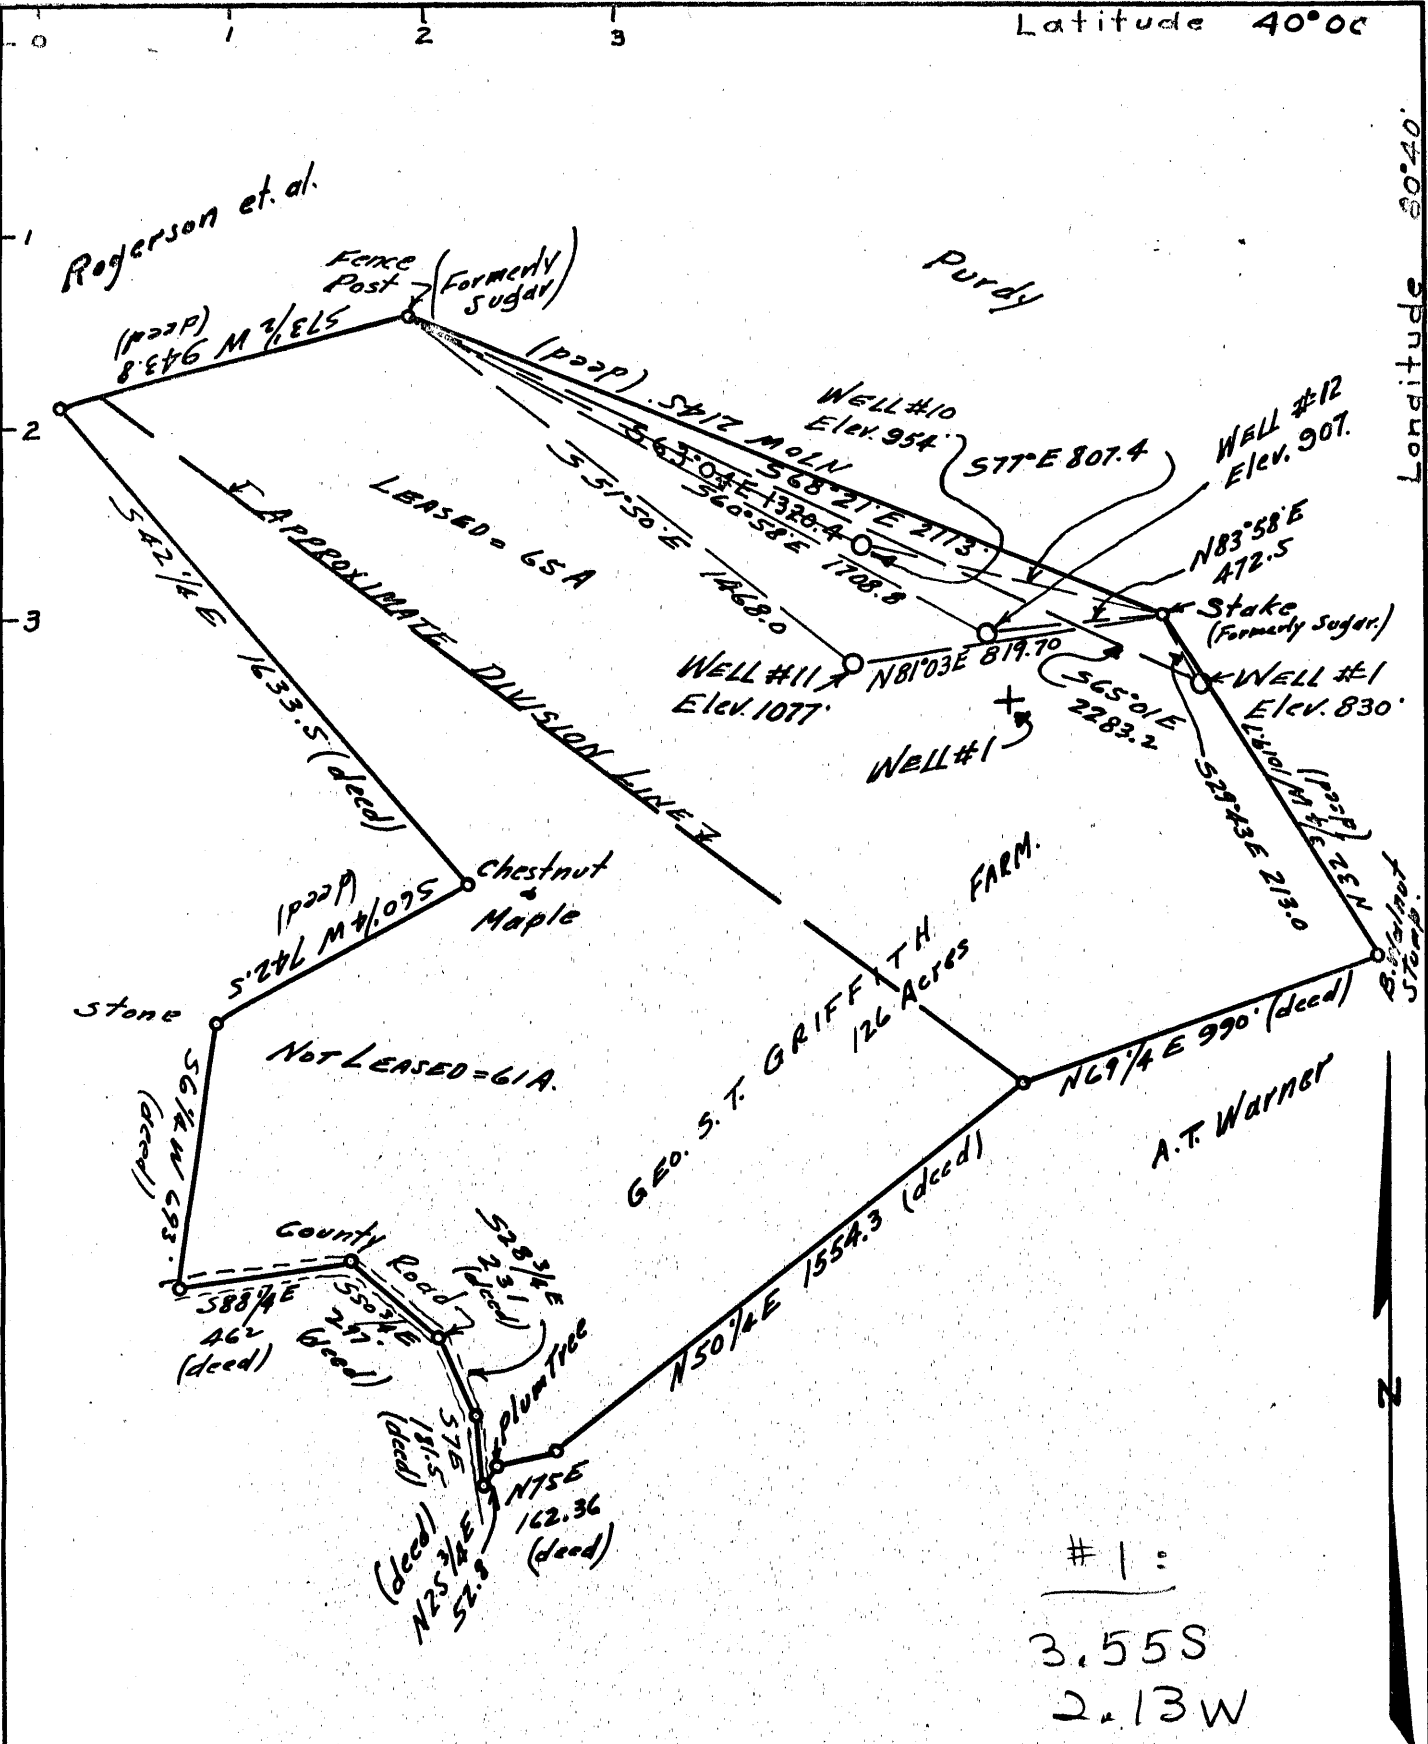

- New Location
- Drill Deeper
- Abandonment

Company GEO. P. WASMUTH
 Address GLENDALE, W. VA.
 Farm GEO. S. T. GRIFFITH
 Tract ONE Acres 65 Lease No. _____
 Well (Farm) No. _____ Serial No. _____
 Quadrangle CAMERON
 County MARSHALL
 District WASHINGTON
 Engineer Halter H. Stegman
 Engineer's Registration No. 394
 File No. _____ Drawing No. _____
 Date MAY 19 1943 Scale 1 INCH = 500 FEET.

STATE OF WEST VIRGINIA
 DEPARTMENT OF MINES
 OIL AND GAS DIVISION
 CHARLESTON

WELL LOCATION MAP
 FILE NO. MARS-225-A-#1
MARS-361-A-#11 MARS-360-A-#10

+ Denotes location of well on United States Topographic Maps. scale 1 to 62,500, latitude and longitude lines being represented by border lines as shown.

- Denotes one inch spaces on border line of original tracing.



STATE OF WEST VIRGINIA
DEPARTMENT OF MINES
OIL AND GAS DIVISION

420

WELL RECORD

Permit No. 356A Oil or Gas Well oil
(KIND)

Company Geo. P. Thasmueth
 Address Glen Dale, West Va
 Farm Geo S. T. Griffith Acres 65
 Location (waters) Little Hawk Creek
 Well No. 11 Elev. 1077
 District Washington County Marshall
 The surface of tract is owned in fee by J. Otto Heiss
 Address Glen Dale, W Va
 Mineral rights are owned by Same
 Address Same
 Drilling commenced 1906
 Drilling completed 1906
 Date Shot _____ From _____ To _____
 With _____
 Open Flow _____ /10ths Water in _____ Inch
 _____ /10ths Merc. in _____ Inch
 Volume _____ Cu. Ft.
 Rock Pressure _____ lbs. _____ hrs.
 Oil _____ / bbls., 1st 24 hrs.
 Fresh water _____ feet _____ feet
 Salt water _____ feet _____ feet

Casing and Tubing	Used in Drilling	Left in Well	Packers
Size			
16			Kind of Packer
13			
10			Size of
8 1/4	<u>350</u>	<u>Pulled</u>	
6 1/4	<u>740</u>	<u>740</u>	Depth set
5 3/16 4 7/8		<u>150 ft</u>	<u>Liners</u>
3			Perf. top
2			Perf. bottom
Liners Used			Perf. top
			Perf. bottom

CASING CEMENTED _____ SIZE _____ No. Ft. _____ Date _____
 COAL WAS ENCOUNTERED AT 585 FEET _____ INCHES
 _____ FEET _____ INCHES FEET _____ INCHES
 _____ FEET _____ INCHES FEET _____ INCHES

Formation	Color	Hard or Soft	Top	Bottom	Oil, Gas or Water	Depth Found	Remarks
<u>Pow-Ram Sand</u>	<u>White</u>	<u>Hard</u>	<u>888</u>	<u>902</u>	<u>oil</u>	<u>895</u>	



(Handwritten mark)

NOV 12 1954

Formation	Color	Hard or Soft	Top	Bottom	Oil, Gas or Water	Depth Found	Remarks

Date Oct 20th, 1953

APPROVED Geo P. Kasnuth Owner

By _____ (Title)