


0 1 2 3 LATITUDE 39 ° 45 ' 1  
 -1  
 -2  
 -3

LONGITUDE 80 ° 40 ' 40  
 80°42'30"

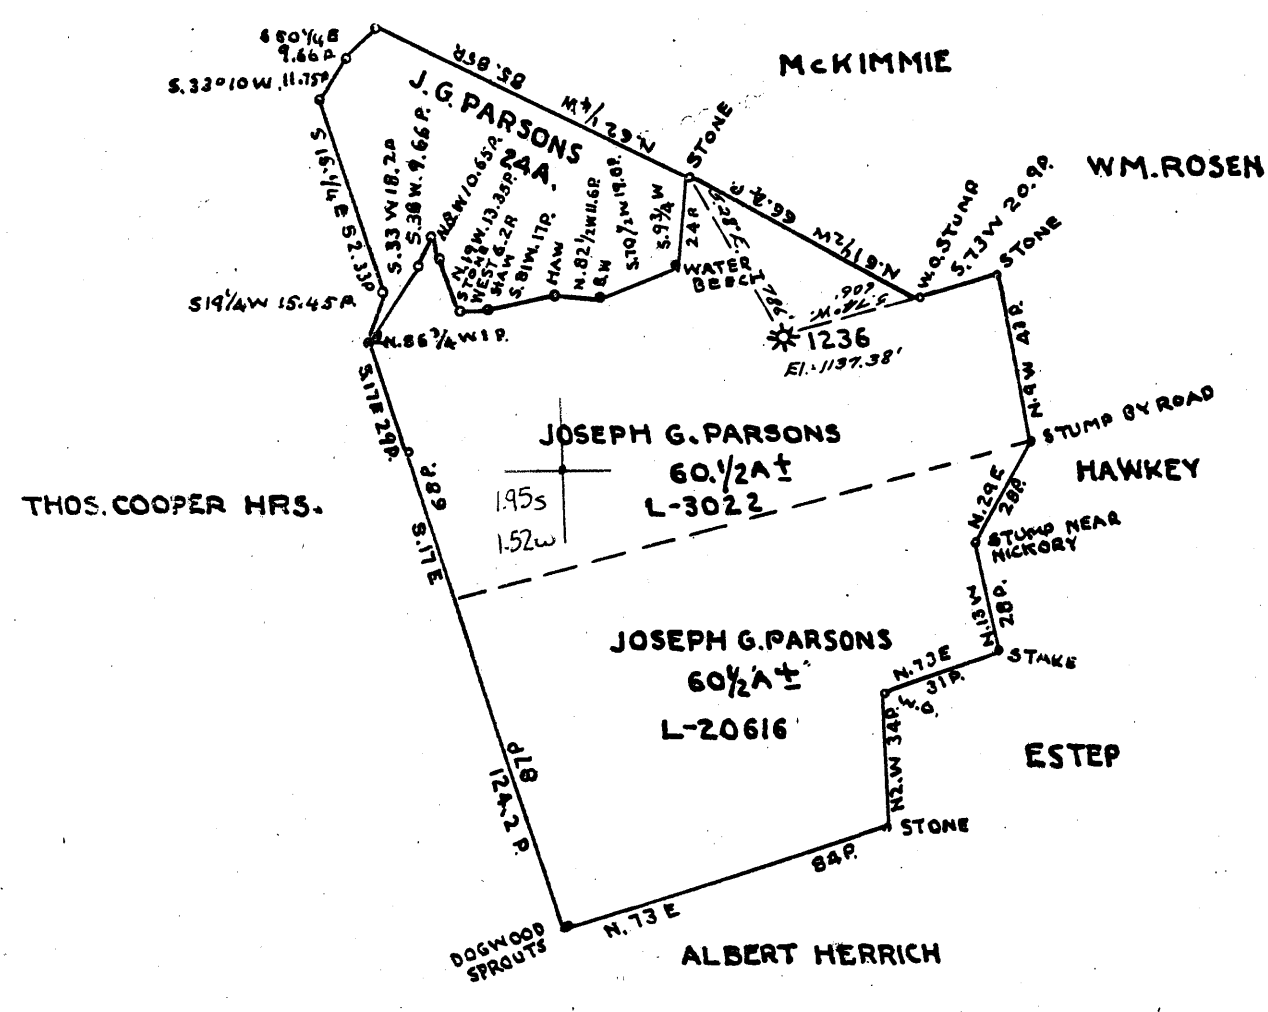

1.94S  
 3.53W

COAL OWNED BY \_\_\_\_\_

NEW LOCATION.....

DRILL DEEPER.....

ABANDONMENT.....

COMPANY THE MANUFACTURERS LIGHT & HEAT

ADDRESS 800 UNION TRUST BLDG. PGH. PA.

FARM J.G. PARSONS & JACKSON YOHO

TRACT \_\_\_\_\_ ACRES 65 LEASE No. 3022

WELL (FARM) No. 1 SERIAL No. 1236

ELEVATION (SPIRIT LEVEL) 1137.38'

QUADRANGLE LITTLETON

COUNTY MARSHALL DISTRICT FRANKLIN

ENGINEER Robert M. Neill (G.E.A.)

ENGINEER'S REGISTRATION No. 361-E

FILE No. \_\_\_\_\_ DRAWING No. Y-15-928

DATE 8 APR. 1959 SCALE 1" = 800'

STATE OF WEST VIRGINIA  
 DEPARTMENT OF MINES  
 OIL AND GAS DIVISION  
 CHARLESTON

WELL LOCATION MAP

FILE No. 77ACS-400-A

+ DENOTES LOCATION OF WELL ON UNITED STATES TOPOGRAPHIC MAPS. SCALE 1 TO 62,500. LATITUDE AND LONGITUDE LINES BEING REPRESENTED BY BORDER LINES AS SHOWN.

- DENOTES ONE INCH SPACES ON BORDER LINE OF ORIGINAL TRACING.