

2.40S
3.77W

0-25-24

COAL OWNED BY _____
 PART PLUG _____
 NEW LOCATION.....
 DRILL DEEPER.....
 ABANDONMENT.....


COMPANY THE MANUFACTURERS LIGHT & HEAT
 ADDRESS 800 UNION TRUST BLDG. PGH. PA.
 FARM L. F. WILHELM (M. & L. HOWARD)
 TRACT _____ ACRES 108 LEASE No. 2148
 WELL (FARM) No. 1 SERIAL No. 2833
 ELEVATION (SPIRIT LEVEL) 1226'
 QUADRANGLE CAMERON
 COUNTY MARSHALL DISTRICT LIBERTY
 ENGINEER Thomas E. Virgin W.
 ENGINEER'S REGISTRATION No. 1503
 FILE No. _____ DRAWING No. Y-25-277
 DATE 8 FEB. 61 SCALE 1" = 800'

STATE OF WEST VIRGINIA
 DEPARTMENT OF MINES
 OIL AND GAS DIVISION
 CHARLESTON

WELL LOCATION MAP

File No. MARS-431-A-P

+ DENOTES LOCATION OF WELL ON UNITED STATES TOPOGRAPHIC MAPS, SCALE 1 TO 62,500. LATITUDE AND LONGITUDE LINES BEING REPRESENTED BY BORDER LINES AS SHOWN.
 - DENOTES ONE INCH SPACES ON BORDER LINE OF ORIGINAL TRACING.

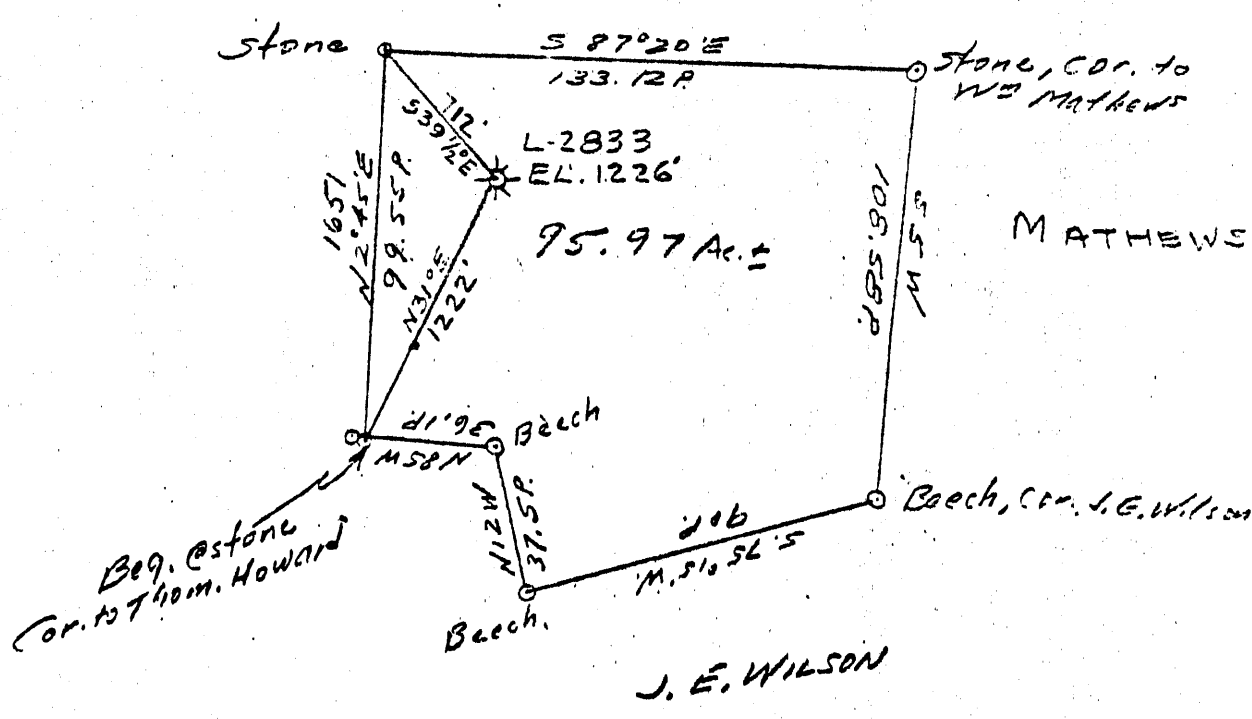

2.37S
3.80W

COAL OWNED BY _____
~~PORT RIVER~~
 NEW LOCATION.....
 DRILL DEEPER.....
 ABANDONMENT..... *issued 8-5-69*

0-25-24

COMPANY THE MANUFACTURERS LIGHT & HEAT
 ADDRESS 800 UNION TRUST BLDG. PGH. PA.
 FARM L. F. WILHELM (M. & L. HOWARD)
 TRACT _____ ACRES 108 LEASE NO. 2148
 WELL (FARM) No. 1 SERIAL No. 2833
 ELEVATION (SPIRIT LEVEL) 1226'
 QUADRANGLE CAMERON SE
 COUNTY MARSHALL DISTRICT LIBERTY
 ENGINEER Thomas E. Virgin M.
 ENGINEER'S REGISTRATION No. 1503
 FILE No. _____ DRAWING No. Y-25-277
 DATE 8 FEB. 61 SCALE 1" = 800'

STATE OF WEST VIRGINIA
 DEPARTMENT OF MINES
 OIL AND GAS DIVISION
 CHARLESTON

WELL LOCATION MAP
 FILE No. MARS-431-A-P-P

+ DENOTES LOCATION OF WELL ON UNITED STATES TOPOGRAPHIC MAPS, SCALE 1 TO 62,500. LATITUDE AND LONGITUDE LINES BEING REPRESENTED BY BORDER LINES AS SHOWN.
 - DENOTES ONE INCH SPACES ON BORDER LINE OF ORIGINAL TRACING.