


LATITUDE 39°40'

51.08

LONGITUDE

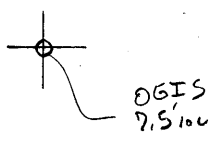

7.5 OGIS topo location

7.5' loc	<u>1.60 S</u>	15' loc	<u>1.60</u>
	<u>2.10 W</u>	(calc.)	<u>2.10</u>

Company State Line Oil & Gas

Farm Mary J. Straight 1

Quad Wadestown 7.5' Area

County Monongalia


District Battle

WELL LOCATION MAP

File No. 061-48

no well record

Plan of the proposed Location of Well No. 1. for the State Line Oil & Gas Trust of Fairmont, West Virginia. On the land of Mary J. Straight containing 45 acres, on the waters of Dunkard Creek, in Battelle District, Monongalia County, West Virginia.

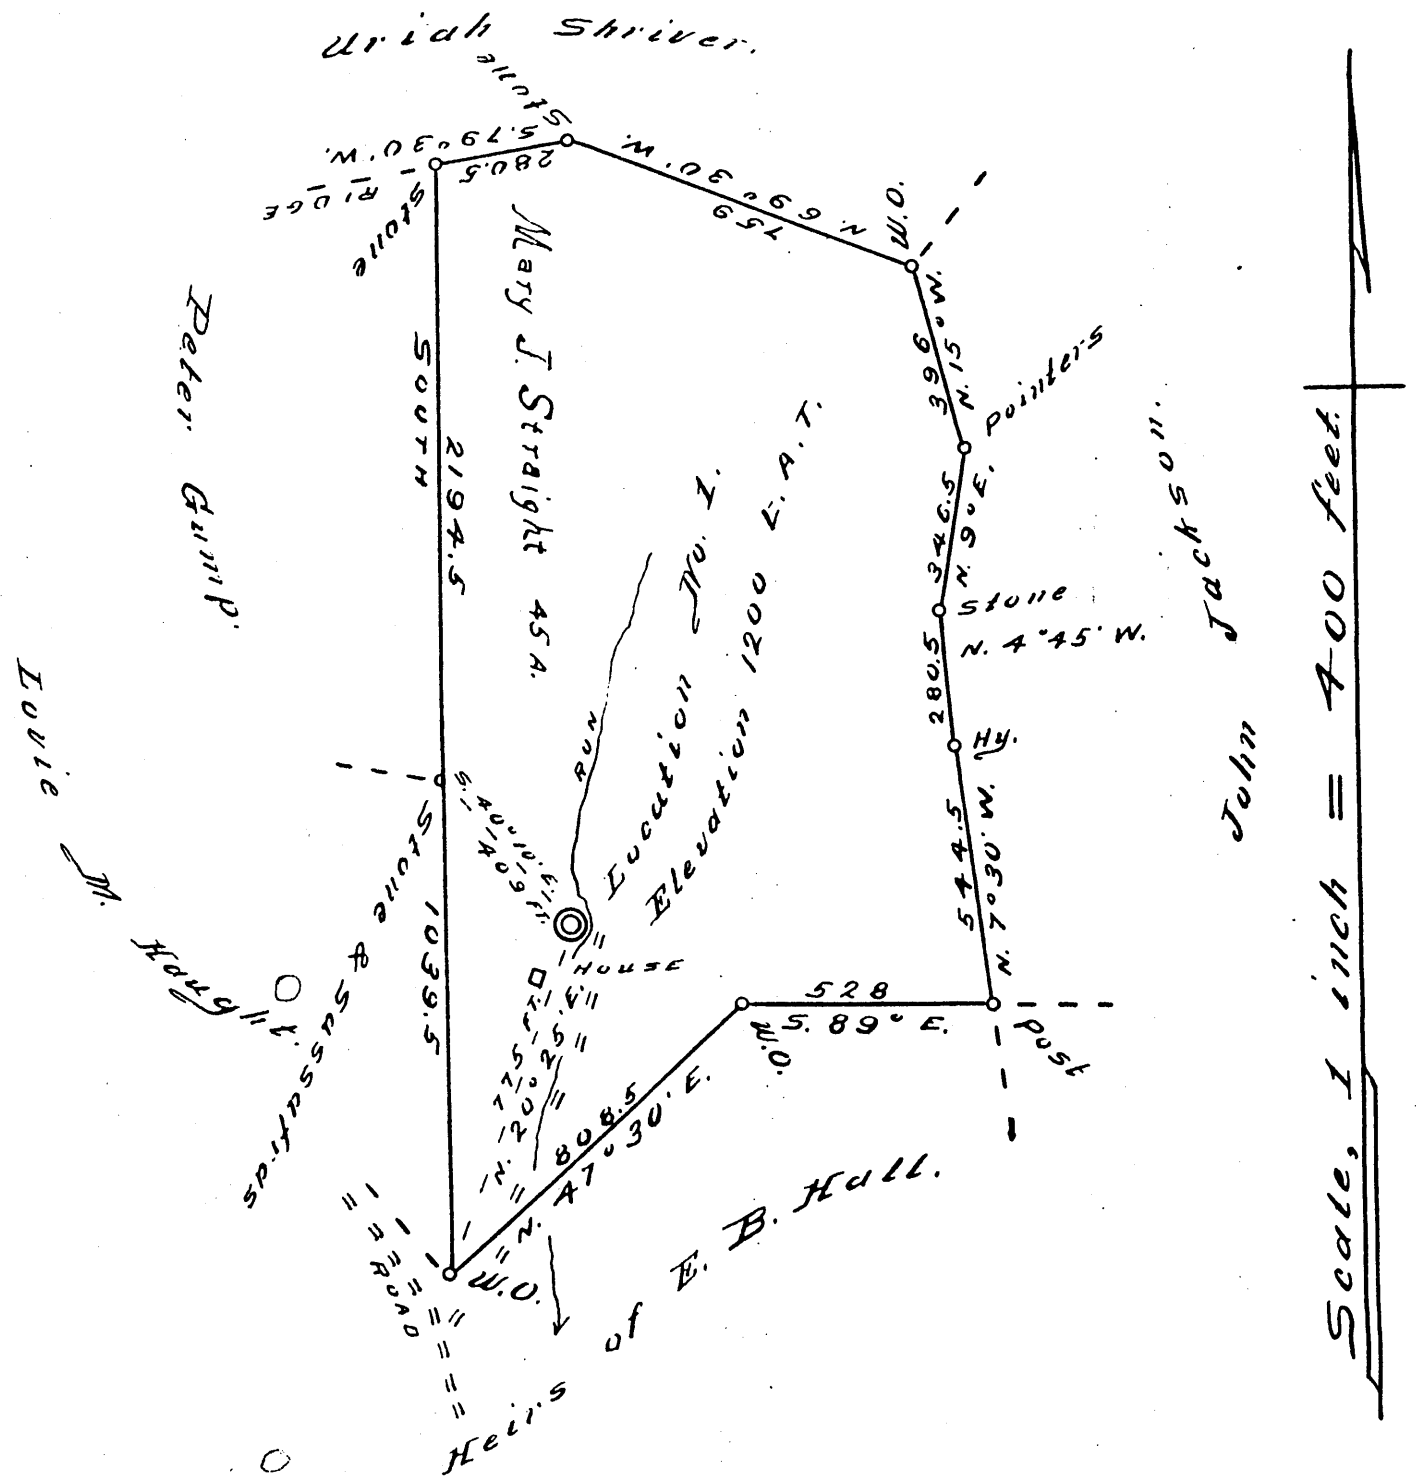

I, the undersigned hereby certify this map is correct, and shows all the information to the best of my knowledge, as required by the Oil & Gas section of the Mining Laws of West Virginia.

David Weed, Engineer.

Acknowledged before me a Notary Public, this 24th day of February - 1932.

W.M. Hess, N.P.

# DRILLER'S RECORD

Previously Requested, but NOT  
AVAILABLE

DATE: 3-2-92

061  
COUNTY

48  
PERMIT