


1 2 3

Latitude 39° 45'

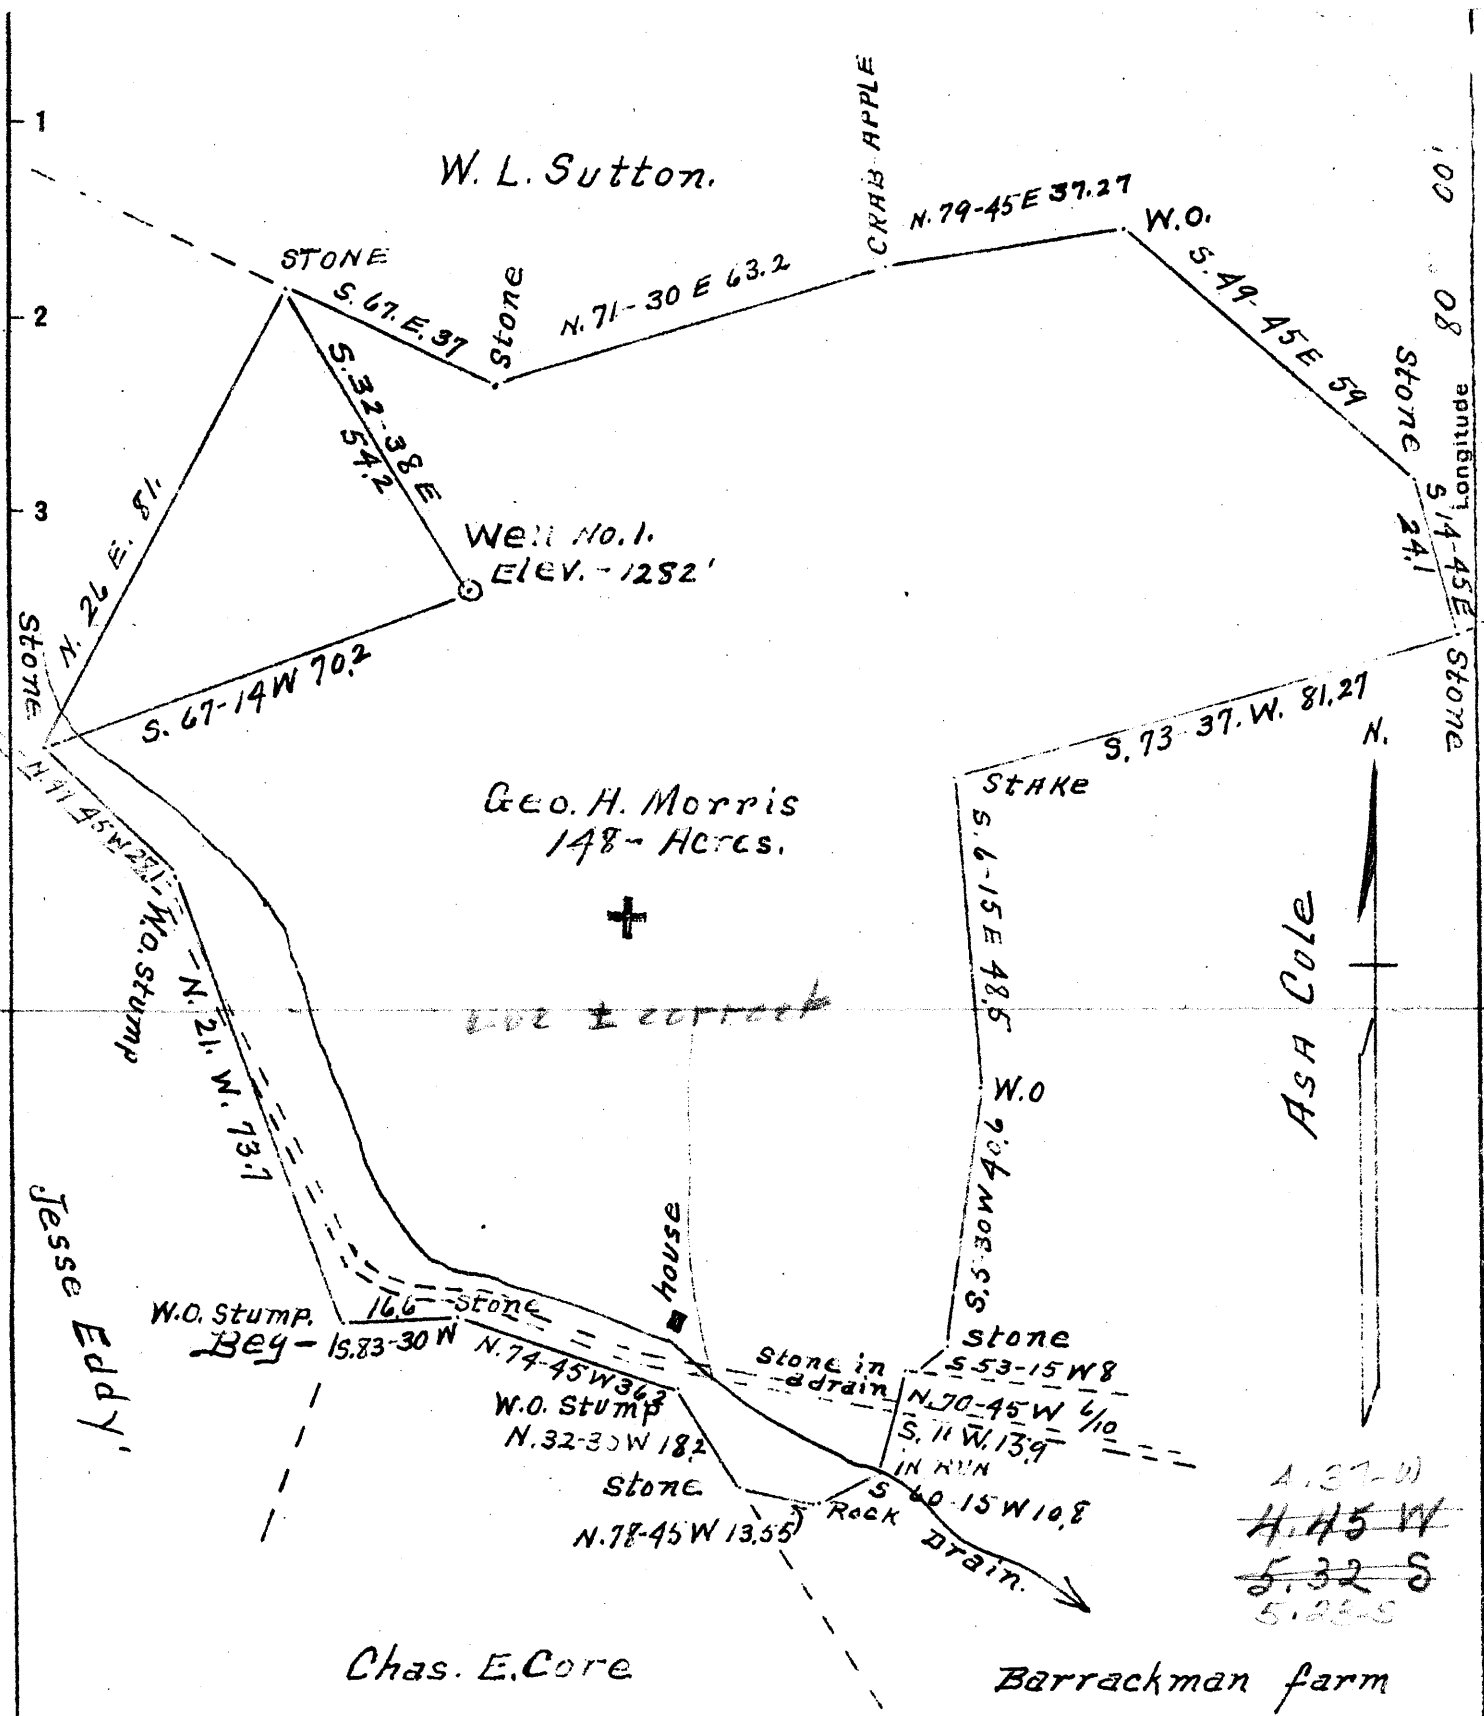

- New Location
- Drill Deeper
- Abandonment

Company J. I. Eddy & Co.
 Address Brave, Pa.
 Farm George A. Morris
 Tract ONE Acres 148- Lease No. _____
 Well (Farm) No. ONE Serial No. _____
 Elevation (Spirit Level) 1282
 Quadrangle Blacksville
 County Monongalia District Cass
 Engineer A. L. Headley
 Engineer's Registration No. _____
 File No. _____ Drawing No. _____
 Date May 22-1940 Scale 1 inch = 30 poles

STATE OF WEST VIRGINIA
 DEPARTMENT OF MINES
 OIL AND GAS DIVISION
 CHARLESTON

WELL LOCATION MAP
 FILE NO. MON-117

- + Denotes location of well on United States Topographic Maps, scale 1 to 62,500, latitude and longitude lines being represented by border lines as shown.
- Denotes one inch spaces on border line of original tracing.

water

WEST VIRGINIA DEPARTMENT OF MINES
OIL & GAS DIVISION
WELL RECORD

Permit No. Mon-117
Blacksville Quad.

Gas Well

CASING & TUBING

6-5/8 1844-1

Coal at 225, 500 & 582

Company J. I. Eddy & Co.
Address Brave, Pa.
Farm Geo. A. Morris ACRES 148
Well No. 1 ELEV. 1282
District Cass - Monongalia County
Surface Geo. A. Morris
Address -
Mineral J. I. Eddy and Co., Brave, Pa.
Commenced June 8, 1940
Completed Aug. 19, 1940
Shot 8/23/40 - Depth 2984
Open Flow 40/10ths Water in 1"
Volume 76,000 c.f.
Rock Pressure 196 lbs. 24 hrs.
Fresh Water 1840 >

Clay	gr	s	0	50
Lime	gr	h	50	80
Shale	dk	s	80	110
Broken Lime	gr	s	110	170
Lime	gr	h	170	225
Coal	bk	s	225	230
Shale	drk	s	230	340
Lime	gr	h	340	390
Shale	dk	s	390	455
Sand	gr	h	455	490
Slate	gr	s	490	500
Coal	bk	s	500	505
Slate	dk	s	505	510
Lime	gr	h	510	575
Slate	dk	s	575	582
Coal	bk	s	582	590
Slate&Lime	dk	s	590	640
Sand	gr	h	640	675
Slate	dk	s	675	800
Sand	gr	h	800	850
Slate&Lime	dk	s	850	900
Lime	gr	h	900	975
Sand	gr	h	975	1000
Slate&Shells	dk	s	1000	1090
Sand	gr	h	1090	1135
Slate&Shells	gr	s	1135	1180
Sand	gr	h	1180	1225
Slate	dk	s	1225	1332
Sand	gr	h	1332	1370
Slate&Shells	dk	s	1370	1400
Sand	gr	h	1400	1420
Slate	dk	s	1420	1440
Sand	gr	h	1440	1500
Slate&Shells	dk	s	1500	1557
Sand	gr	h	1557	1615
Slate	dk	s	1615	1705
Red Rock	rd	s	1705	1800
Lime	gr	h	1800	1820
Slate	dk	s	1820	1828
Lime	gr	h	1828	1893
Sand	gr	h	1893	2052
Slate&Shells	dk	s	2052	2100
Sand	gr	h	2100	2125
Slate&Shells	dk	s	2125	2450
Sand	gr	h	2450	2495
Slate&Shells	dk	s	2495	2505

Sand	gr	h	2505	2518
Slate	dk	s	2518	2530
Sand-50	gr	h	2530	2570
Red Rock	rd	s	2570	2610
Sand-30	gr	h	2610	2640
Slate	dk	s	2640	2675
Red Rock	rd	s	2675	2700
Slate	dk	s	2700	2740
Sand	gr	h	2740	2752
Slate	dk	s	2752	2800
Sand-4	gr	h	2800	2810
Slate	dk	s	2810	2850
Sand	gr	h	2850	2860
Slate	dk	s	2860	2942
Sand-3	gr	h	2942	3017
Slate&Shells	dk	s	3017	3092

Gas 1918 4/10 W in 2", blew down to 20,000 MC
Gas 2456 Increased to 94,000 MC, blew down to 40,000 MC
Gas 2984 Increased to 76,000 MC 4/10 water in 1". Shot with 15 qts. at 2984 increased to 5/10 Water in 2"

6-5/8 casing cemented in 8 and 10 inch casing pulled Cemented 6-5/8 casing from bottom to surface

1280
660
620